


DRAWING NOTES

- 1. RE-ROUTE 40KVA UPS FEEDER TO NEW MANUAL ATS SWITCH.

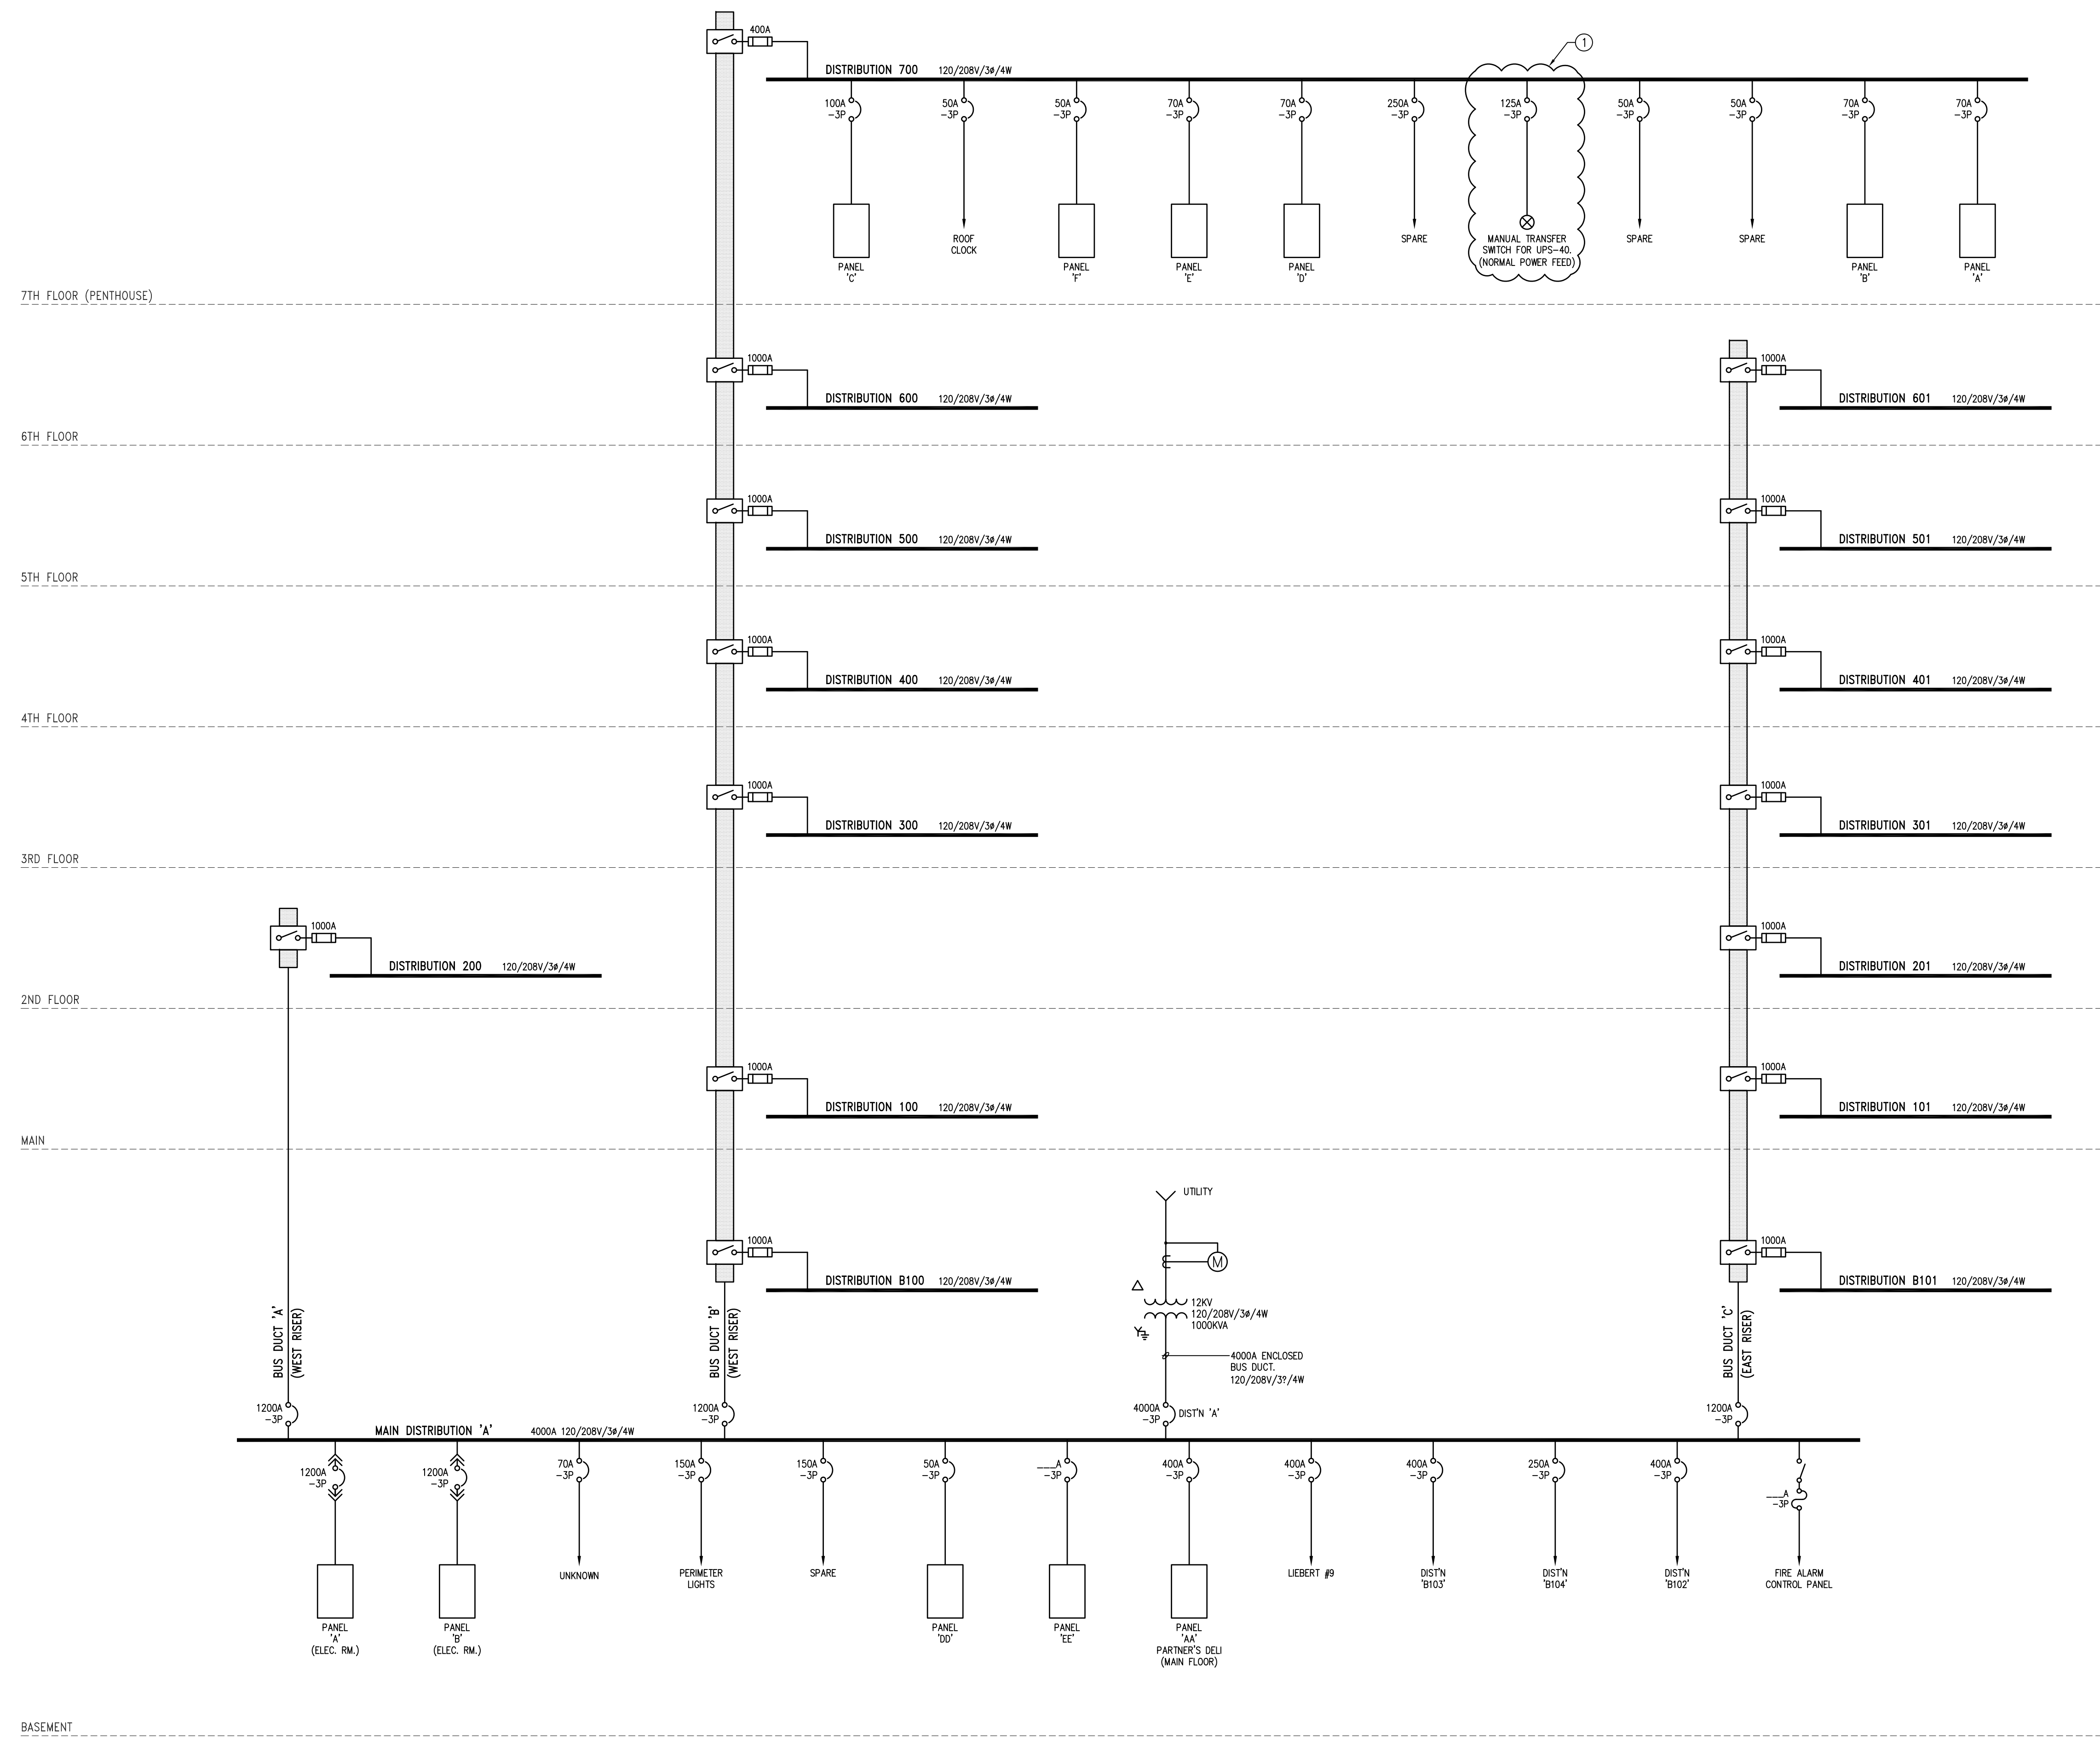

SMS ENGINEERING

SMS Engineering Ltd. Consulting Engineers
 170 Bradford Street Winnipeg MB Canada R3H 0K3
 Telephone: 204.775.0291 Fax: 204.772.2153
 sms@smseng.com

- 2. ISSUED FOR ADDENDUM NO. 2 CB 09.07.27
- 1. ISSUED FOR BID OPPORTUNITY CB 09.06.19

NO.	REVISION/DESCRIPTION	BY	DATE

SEALS



DRAWN BY	CHECKED BY	APPROVED CH
KAM	CR	

CITY OF WINNIPEG
 PLANNING, PROPERTY &
 DEVELOPMENT DEPARTMENT
 CIVIC ACCOMMODATIONS DIVISION
 300 - 65 GARRY ST. R3C 4K4

PROJECT
 CITY OF WINNIPEG 510 MAIN ST.
 EMERGENCY DISTRIBUTION UPGRADE
 PHASE 1

SHEET TITLE
 EXISTING BUSDUCT RISER DIAGRAM

SCALE	PROJECT NO.	SHEET NO.
AS SHOWN	07-232-01	E3.3