


TITLE

Pedra Single Timber Edging Detail

SCD 651 - R1

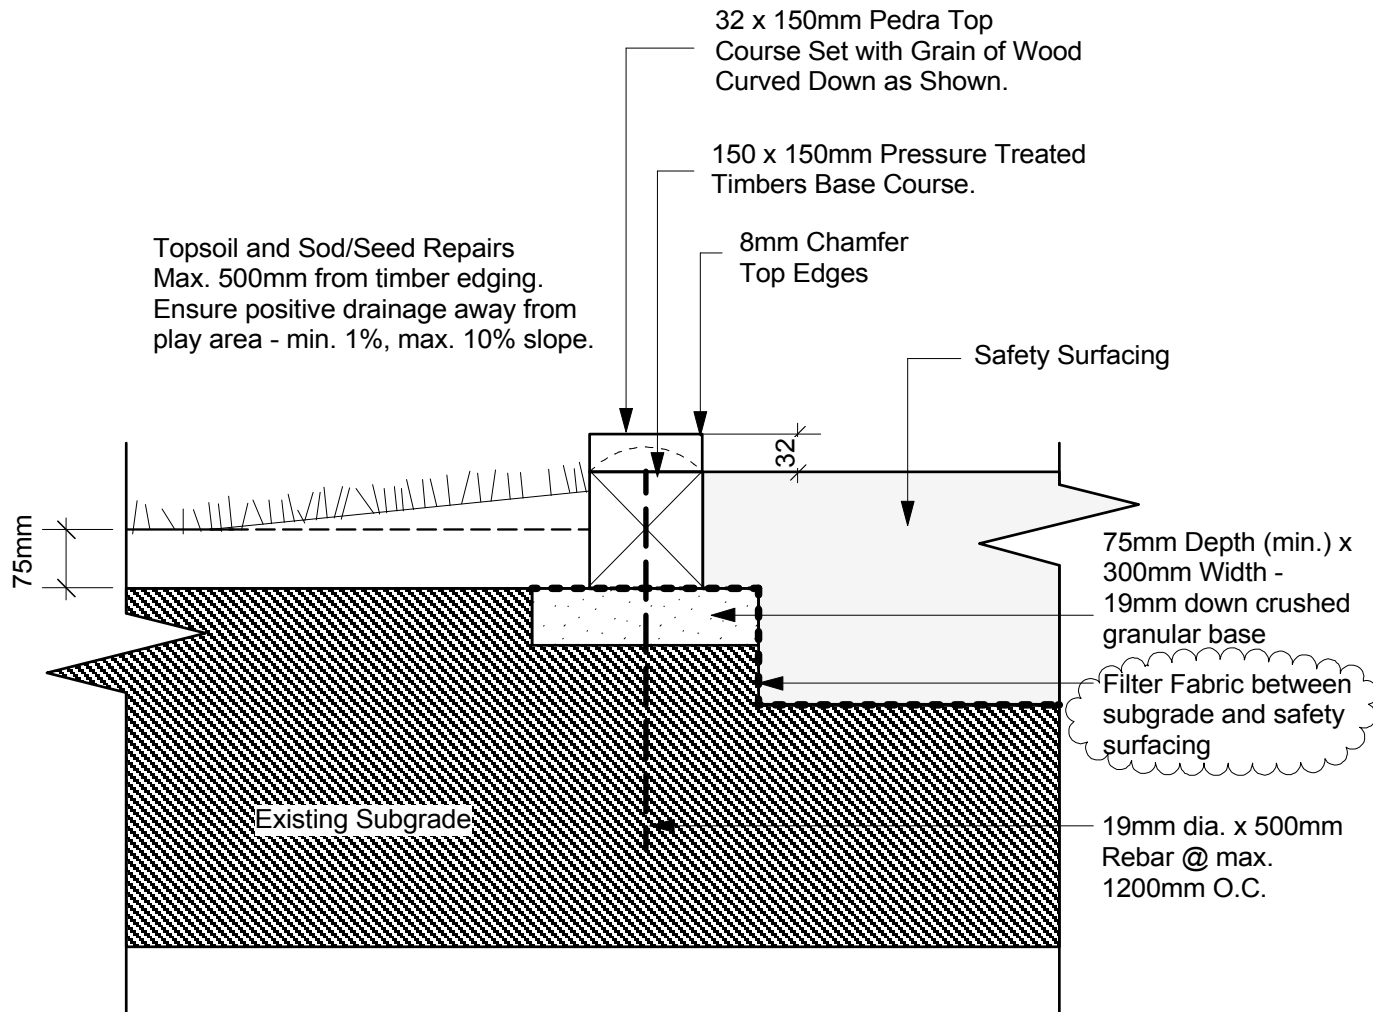

Base course timber shall be pinned with minimum of two (2)
19mm dia. rebar @ max. 1200mm O.C.
Pedra top course shall be pre-drilled and screwed down using
screws treated for ACQ use and sized to suit. Two screws at each
end and every 600mm alternating sides along length. Only use
but joints for straight sections of pedra. Min. length of timbers to
be 1200mm. Install longest lengths possible.

NOTE:

ALL DIMENSIONS SHOWN
ARE IN MILLIMETERS.

Scale: NTS

Drawn By: C.H.

Date: Jan.09

THE CITY OF WINNIPEG
Planning, Property and Development Department
Planning and Land Use Division
Unit 15 - 10 Fort Street, Winnipeg, MB, R3C 4X5

