


N1 LAN
TO NCU #1
BUILDING B
SEE 1501-3

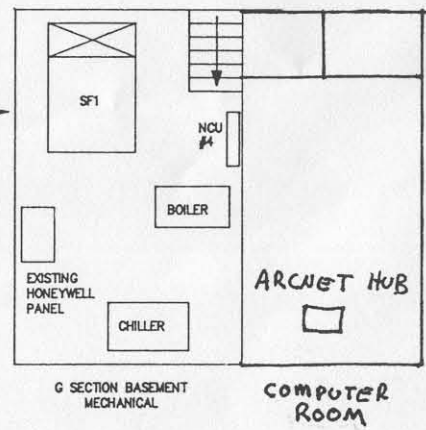

* SET END OF LINE N2 BUS DAISY CHAINS TO EACH UNIT.
THE REMOTE NT ROUTES FROM NCU #4 TO NEU #3

UNIT
UNITARY DIGITAL CONTROLLER (u = N2 ADDRESS)

530 FT.

DRAWING TITLE		FILE: GSECFURP	
FT. ROUGE G SECTION		2	2098-5007/UNIT 18
N2 COMMUNICATION BUS		1	AS BUILT
LAYOUT		NO. 1	REVISION-LOCATION
SCALE	ENR PROJECT	NO. 1	DATE BY
BH	RC	RC	APPROVED
PROJECT		DATE	
WINNEPEG TRANSIT		07/28/98 CH	
ADMINISTRATION AND G SECTION		03/23/98 CH	
METASYS FACILITY		DRAWN	
MANAGEMENT SYSTEM		BY CH DATE 07/25/98	
JOHNSON CONTROLS		CONTRACT NUMBER	
Systems & Services Division		91098-5006	
JOHNSON CONTROLS LTD		DRAWING NUMBER	
800 MORAY STREET		1501-32A	
WINNEPEG, MANITOBA			
R3J 3W9			
204-895-9300			