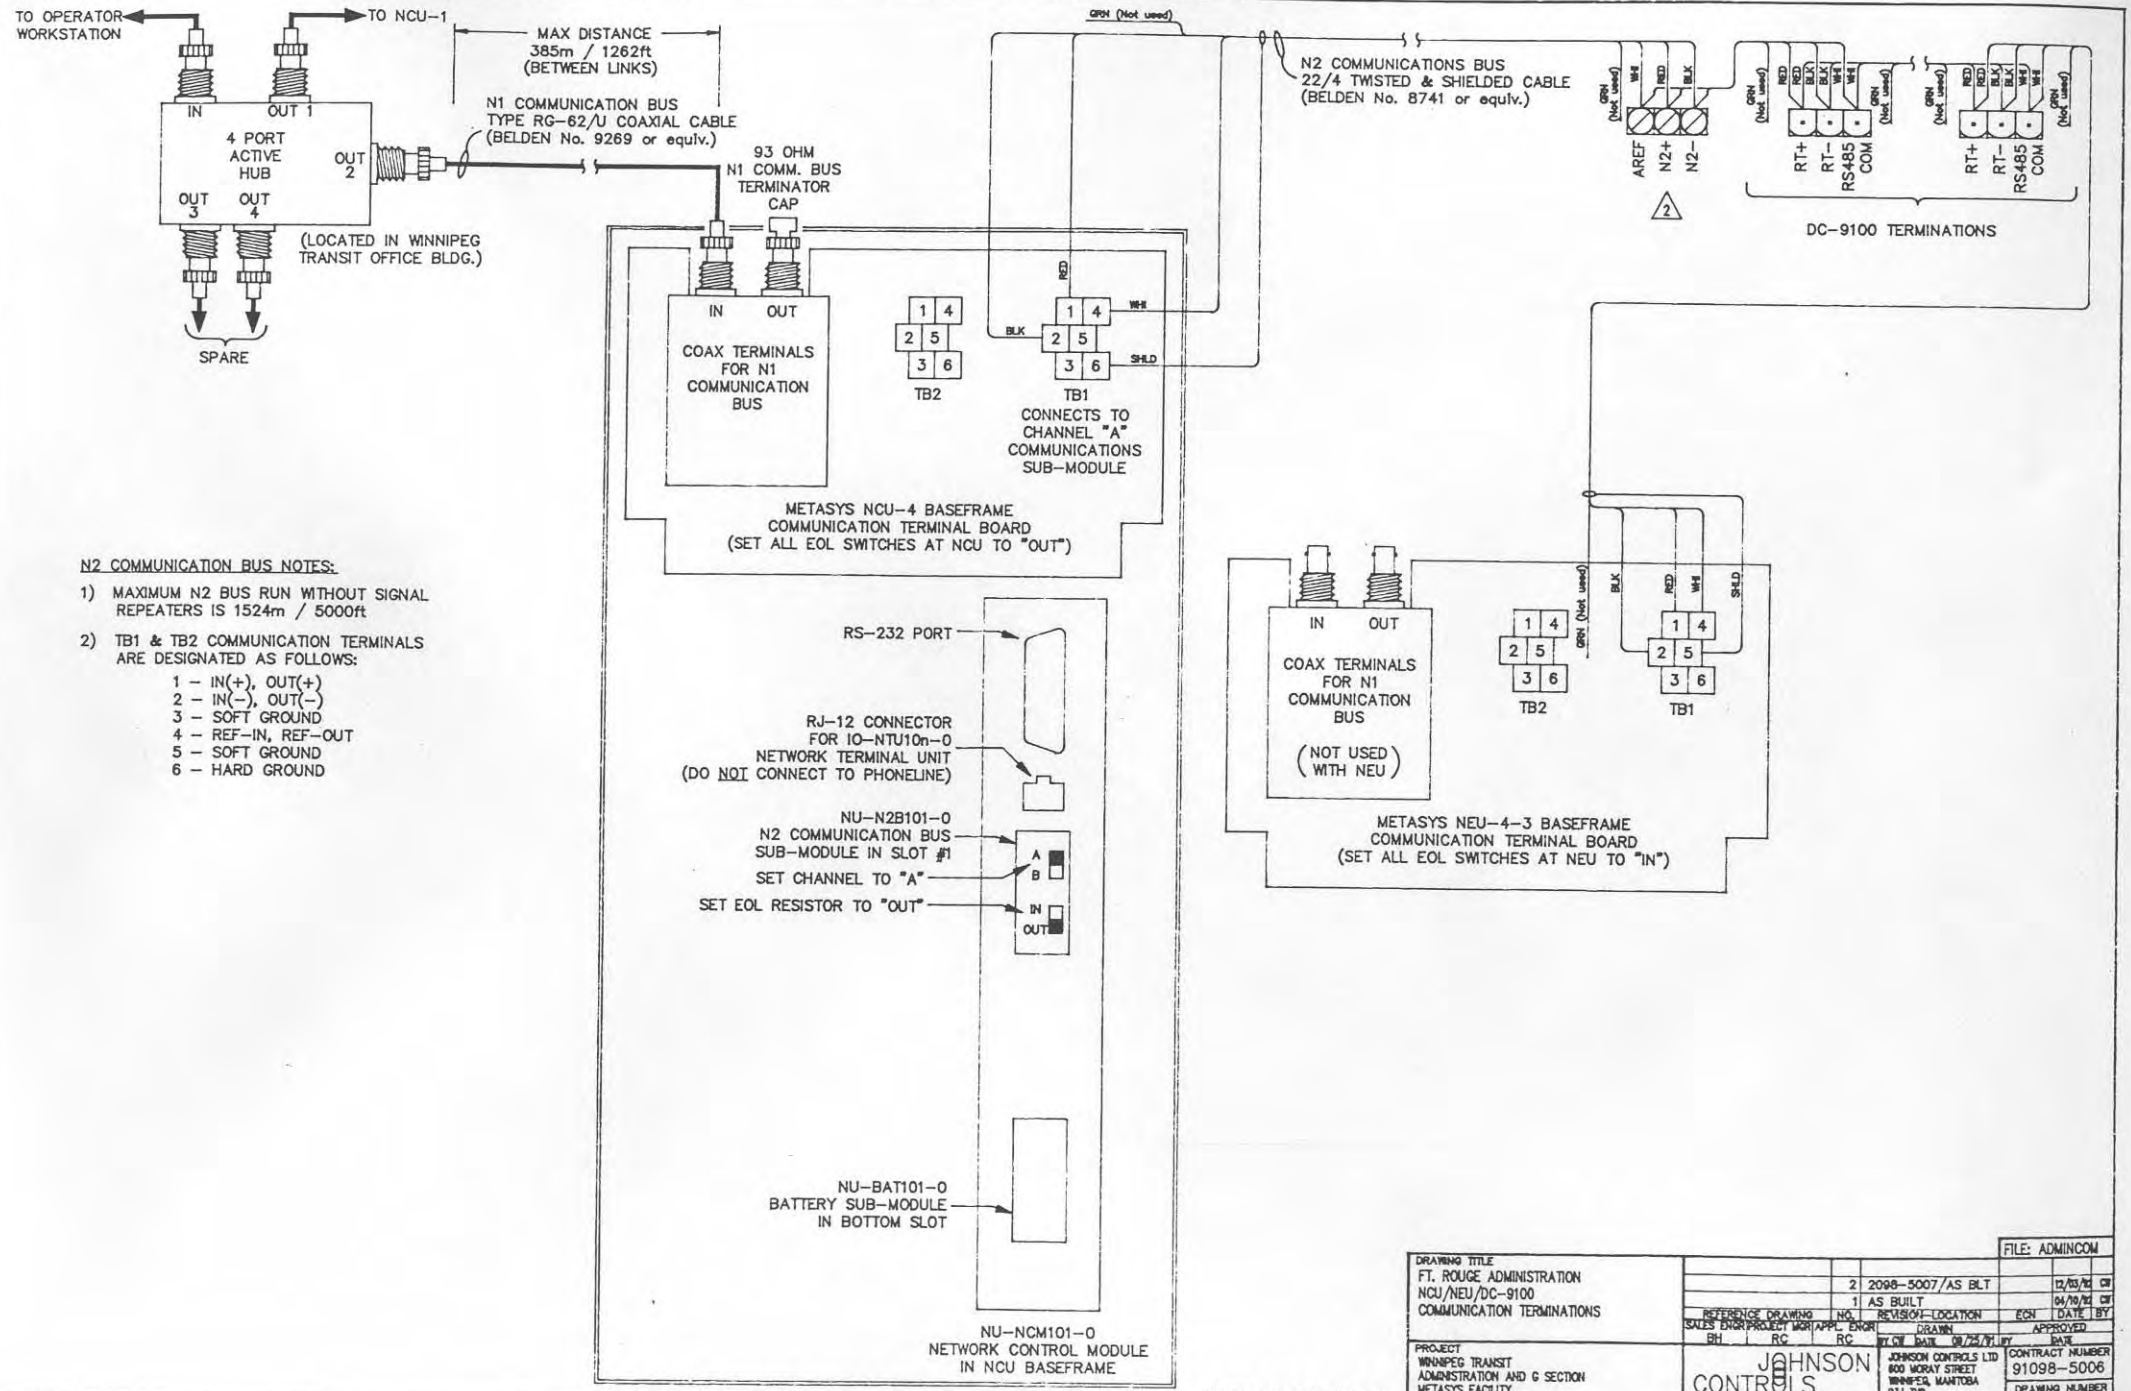

N2 COMMUNICATION BUS NOTES:

1) MAXIMUM N2 BUS RUN WITHOUT SIGNAL REPEATERS IS 1524m / 5000ft

2) TB1 & TB2 COMMUNICATION TERMINALS ARE DESIGNATED AS FOLLOWS:
   - 1 – IN(+), OUT(+)
   - 2 – IN(–), OUT(–)
   - 3 – SOFT GROUND
   - 4 – REF–IN, REF–OUT
   - 5 – SOFT GROUND
   - 6 – HARD GROUND

COPYRIGHT JOHNSON CONTROLS, INC. 1991

DRAWING TITLE
FT. ROUGE ADMINISTRATION
NCU/NEU/DC-9100
COMMUNICATION TERMINATIONS

NO.	REVISION–LOCATION	ECN	DATE	BY
2	2098–5007/AS BLT		12/03/92	CW
1	AS BUILT		04/10/92	CW

REFERENCE DRAWING: SALES ENGR BH; PROJECT MGR RC; APPL. ENGR RC
DRAWN: BY CW DATE 08/25/91
APPROVED: BY DATE

FILE: ADMINCOM

PROJECT
WINNIPEG TRANSIT
ADMINISTRATION AND G SECTION
METASYS FACILITY
MANAGEMENT SYSTEM

JOHNSON CONTROLS
Systems & Services Division

JOHNSON CONTROLS LTD
800 MORAY STREET
WINNIPEG, MANITOBA
R3J 3Y8
204–885–8380

CONTRACT NUMBER 91098–5006

DRAWING NUMBER 1501–34