MUA-1

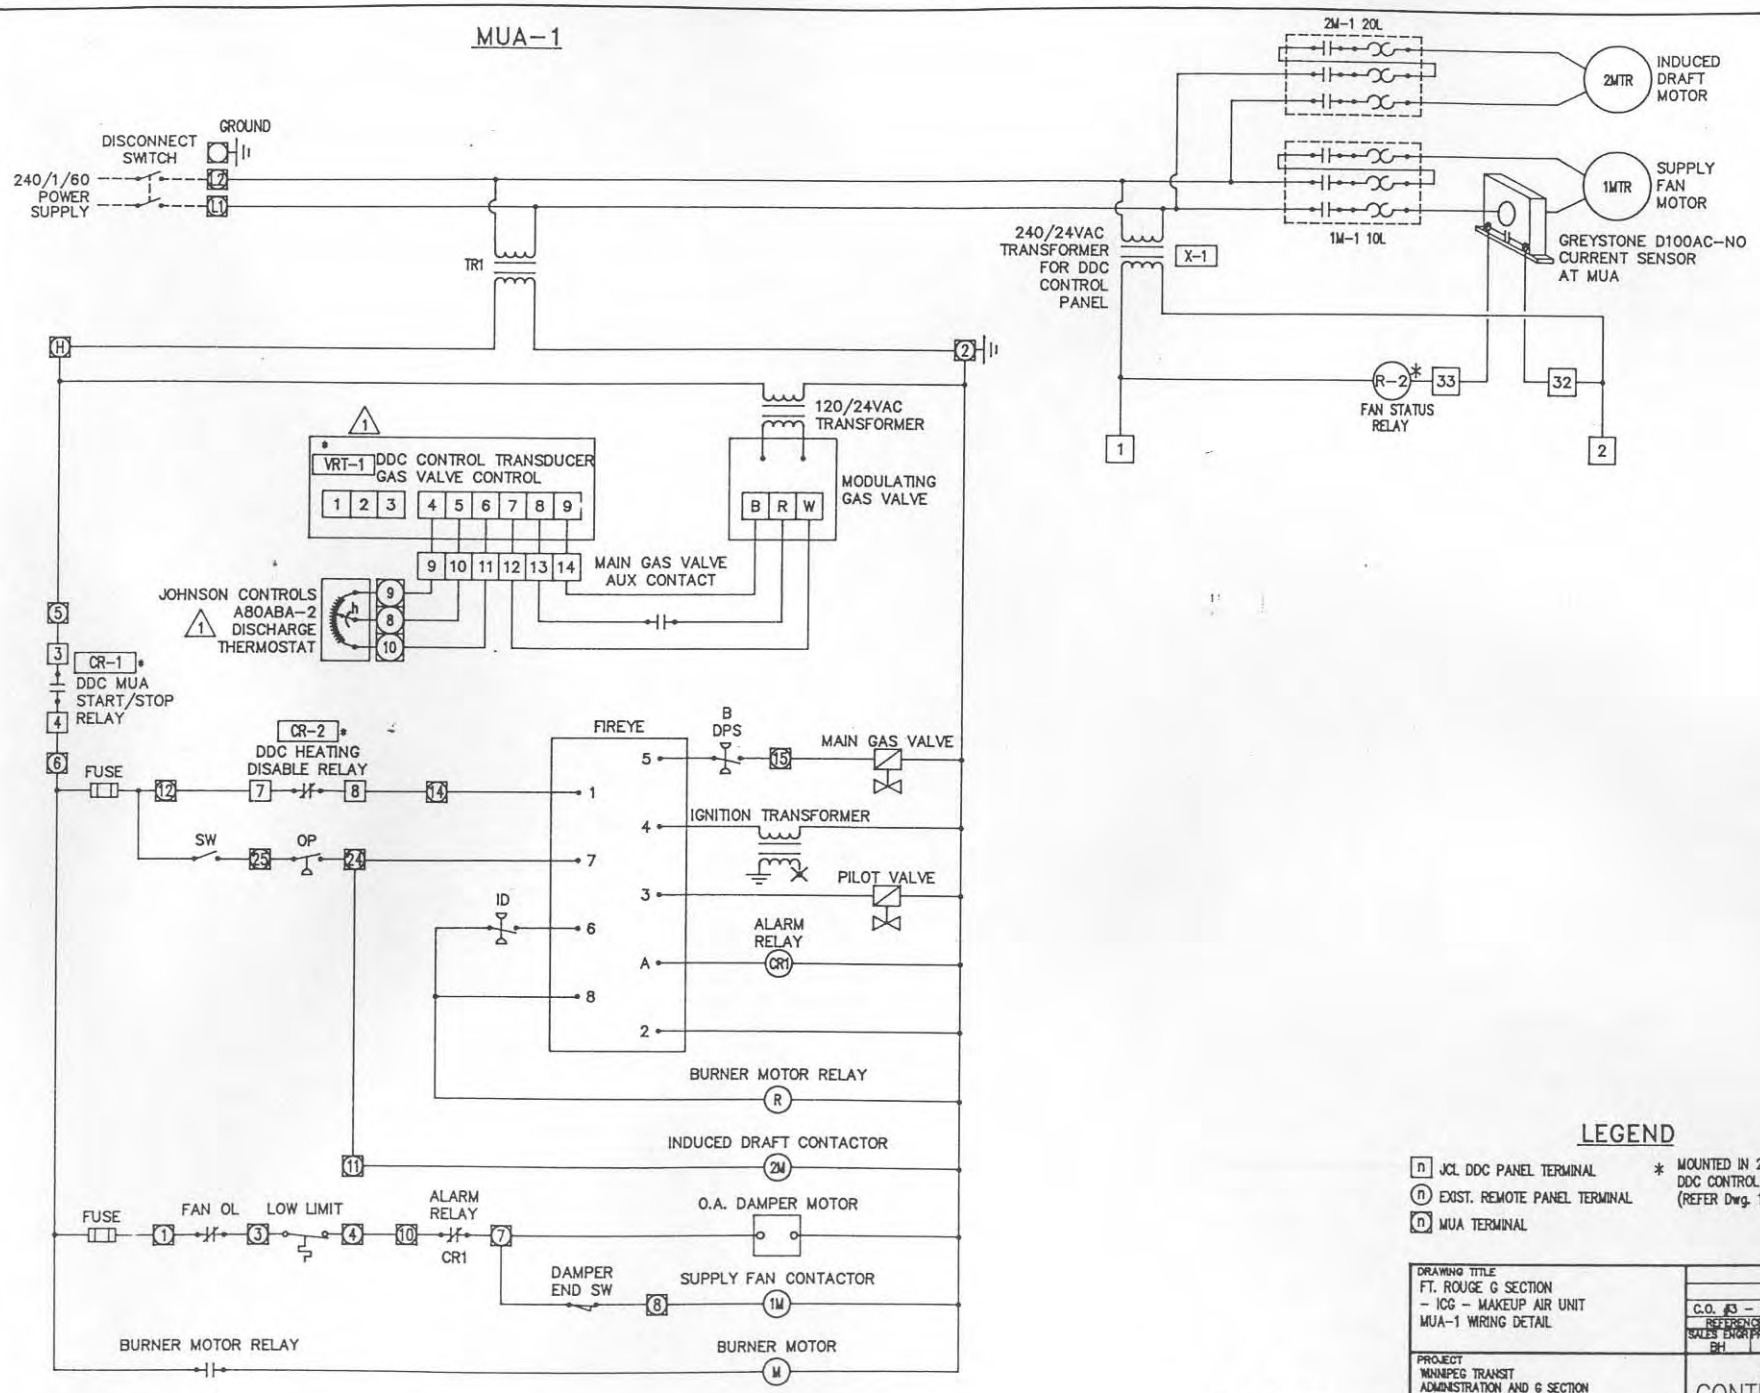

LEGEND

- [n] JCL DDC PANEL TERMINAL
- (n) EXIST. REMOTE PANEL TERMINAL
- [n] MUA TERMINAL
- * MOUNTED IN 20" X 20" DDC CONTROL PANEL (REFER Dwg. 1501-47)

FILE: FTRGMUA1

	2	AS BUILT	05/01/92	JHF
C.O. #3 - DWS	1	MOD. GAS VALVE	02/07/92	CM
REFERENCE DRAWING	NO.	REVISION-LOCATION	ECN	DATE BY

DRAWING TITLE
FT. ROUGE G SECTION
- ICG - MAKEUP AIR UNIT
MUA-1 WIRING DETAIL

SALES ENGR: BH | PROJECT MGR: RC | APPL. ENGR: RC
DRAWN BY: CM DATE: 01/07/92 BY
APPROVED BY: DATE:

PROJECT
WINNIPEG TRANSIT
ADMINISTRATION AND G SECTION
METASYS FACILITY
MANAGEMENT SYSTEM

JOHNSON CONTROLS
Systems & Services Division

JOHNSON CONTROLS LTD
800 MORAY STREET
WINNIPEG, MANITOBA
R3J 3Y9
204-885-9380

CONTRACT NUMBER: 91098-5006
DRAWING NUMBER: 1501-46A

COPYRIGHT JOHNSON CONTROLS, INC. 1991