


# Network Architecture

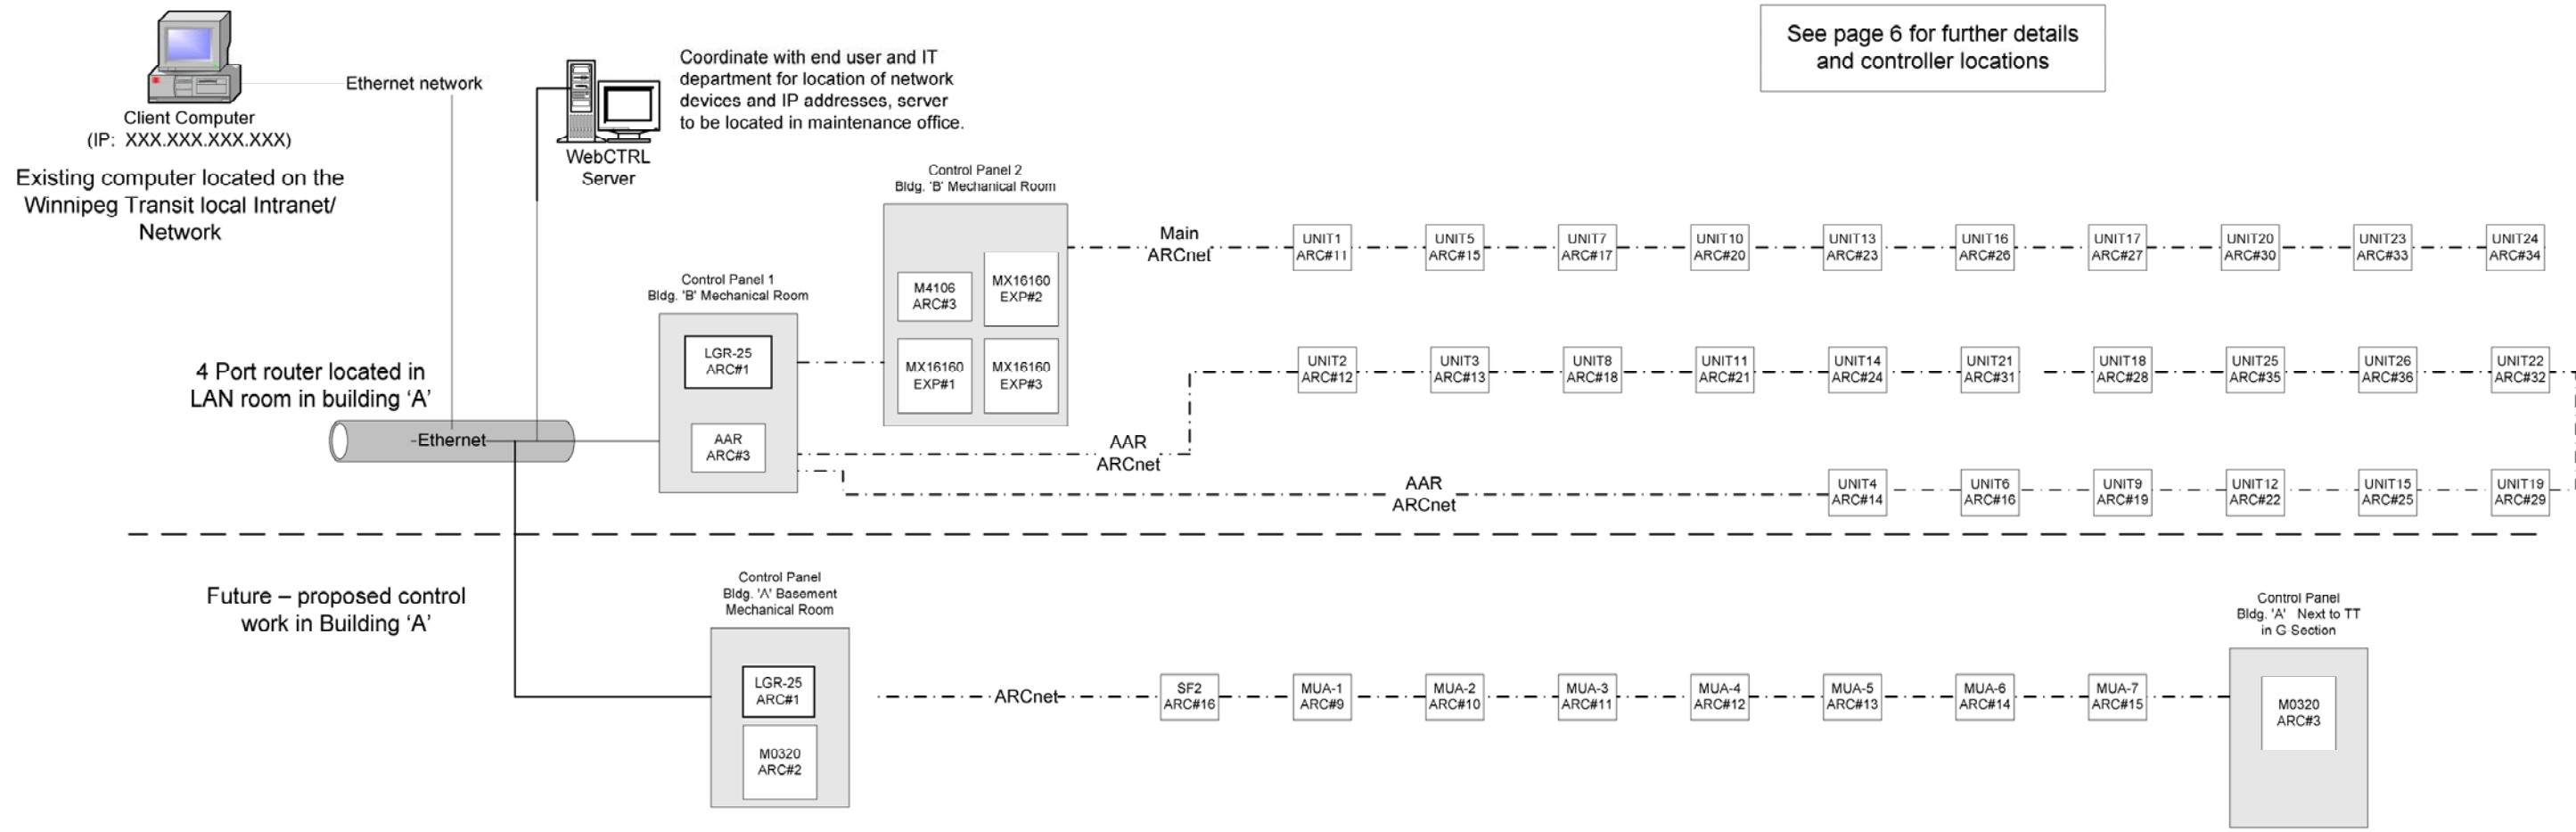

See page 6 for further details and controller locations

<b>Winnipeg Transit</b>			
Winnipeg, Manitoba			
Integrated Control Systems			
Network Architecture			
REV: 1	As-Built	5/29/2008	JOB NO: ICS06-81
<b>AUTOMATEDLOGIC</b> CORPORATION			CHECK BY: J.J.L.
			DSCODE:
			5 of 27