


Network Wiring Layout

- Notes:
 1 – Original network wiring
 2 – New CAT5 ethernet wiring
 3 – Temporary network wiring for installation only

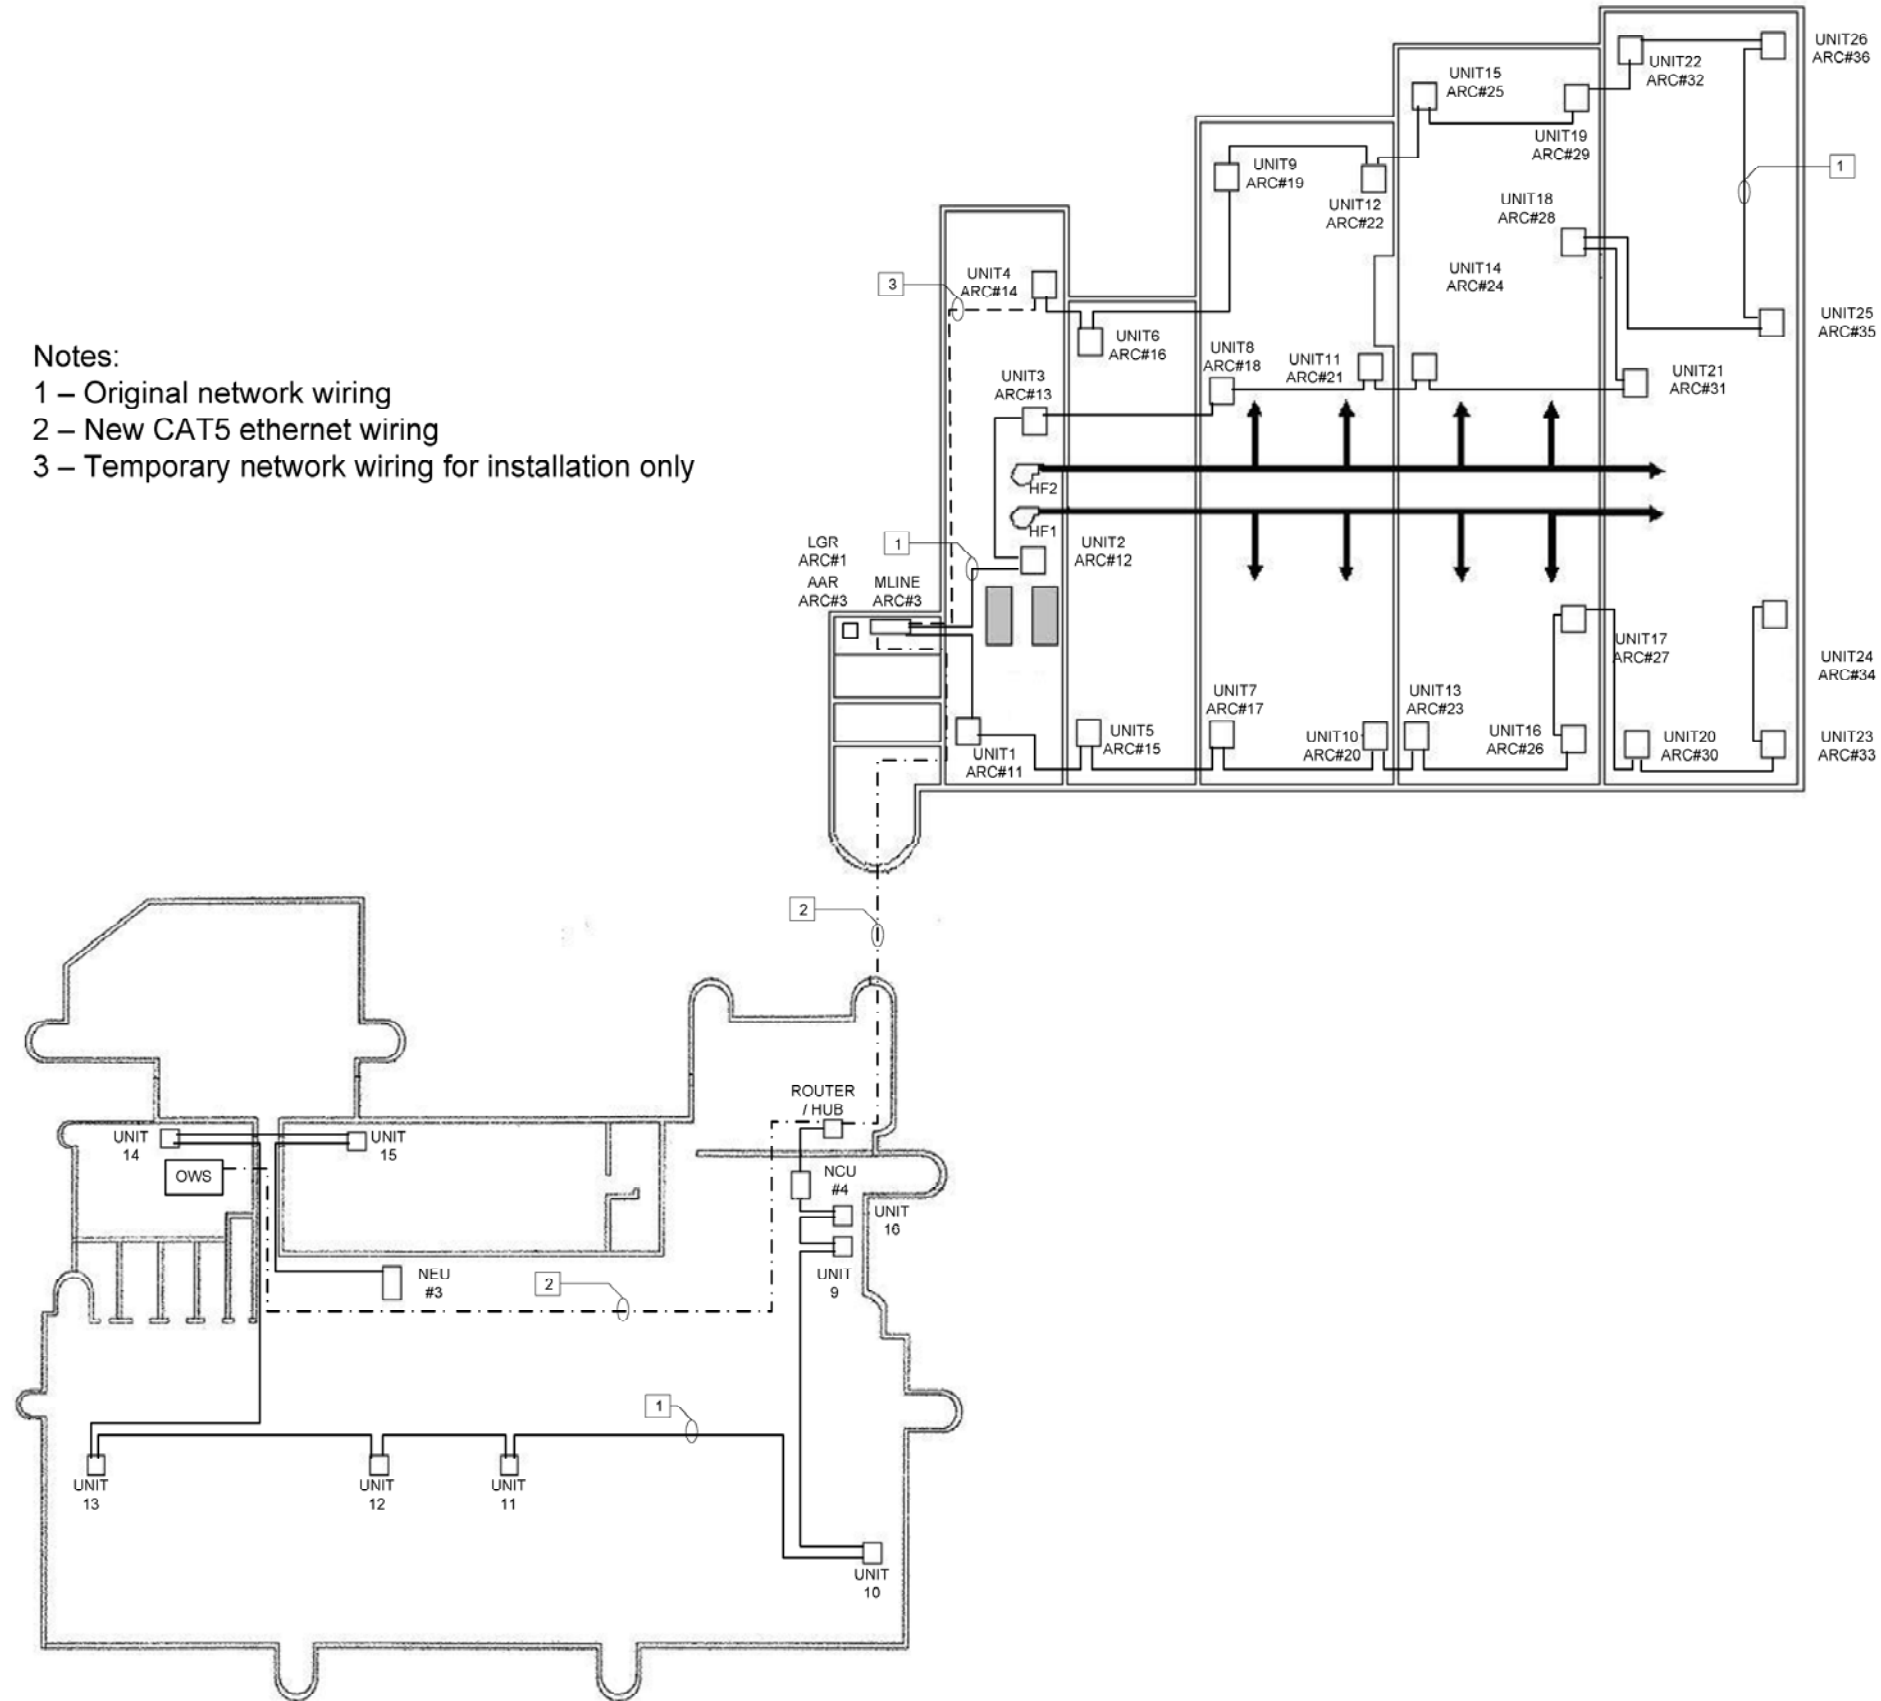

Winnipeg Transit Winnipeg, Manitoba			
Integrated Control Systems			
Network Wiring Layout			
REV: 1	As-Built	5/29/2008	JOB NO: ICS06-81
			CHECK BY: J.J.L.
			DSCODE:
			6 of 27