
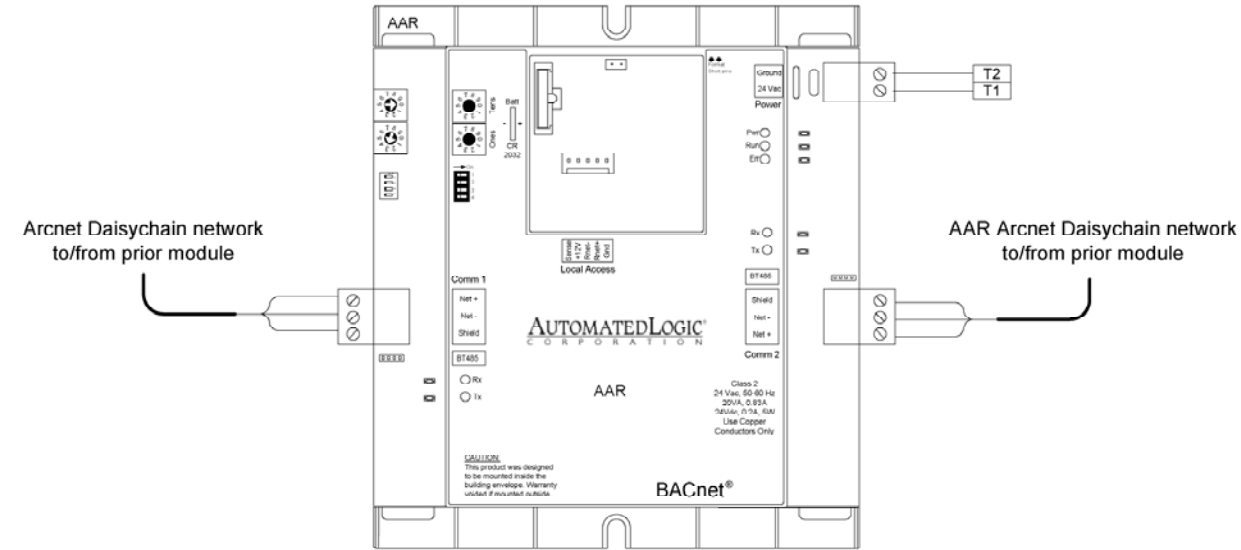


LGR Controller

Bill of Materials				
DID	DESCRIPTION	MANUFACTURER	PART NUMBER	QTY
AAR	ARCNET TO ARCNET ROUTER	AUTOMATED LOGIC	AAR	1 ea
EH-7	HOFFMAN NEMA 1 24X20X6.25	HOFFMAN	A-24N20ALP	1 ea
LGR25	LGR25	AUTOMATED LOGIC	LGR25	1 ea
TRV75	120/24 VAC TRANSFORMER 75VA WITH BREAKER	VERIS IND	X075CAA	1 ea

DDC Control Panel

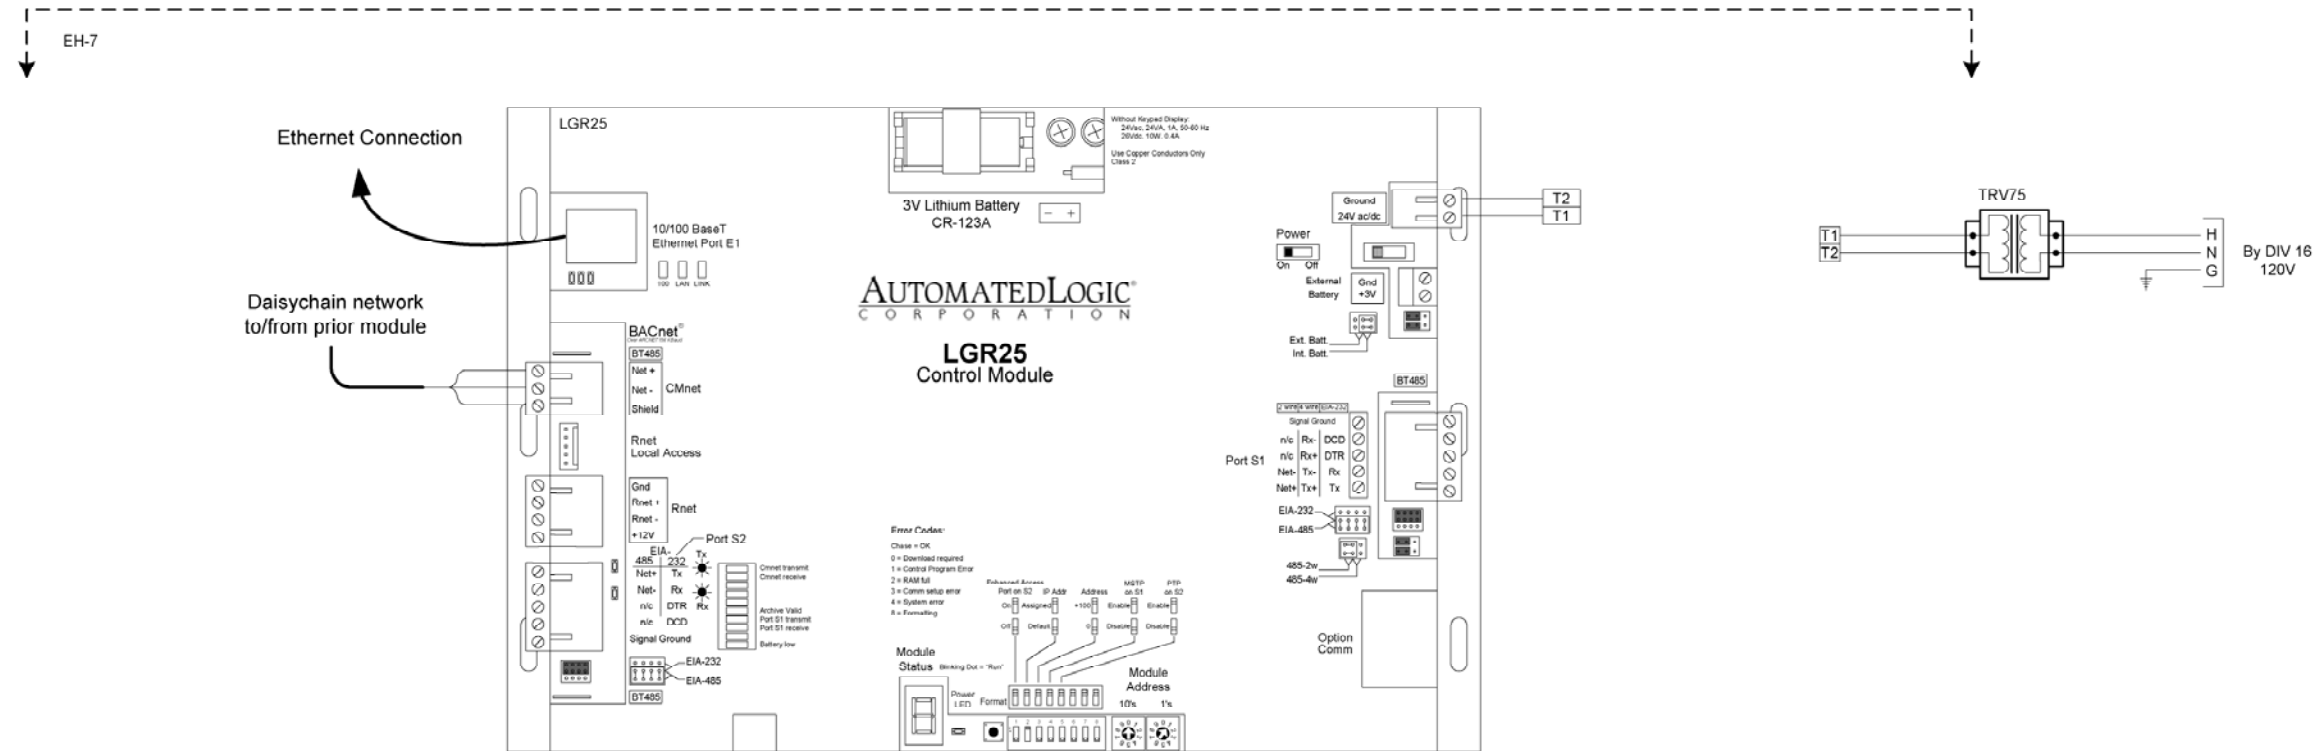

Winnipeg Transit Winnipeg, Manitoba			
Integrated Control Systems			
LGR Controller			
REV: 1	As-Built	5/29/2008	JOB NO: ICS06-81
			CHECK BY: J.J.L.
			DSCODE:
			7 of 27