


**N.E. RETAINING WALL PILE LAYOUT**  
SCALE 1:75

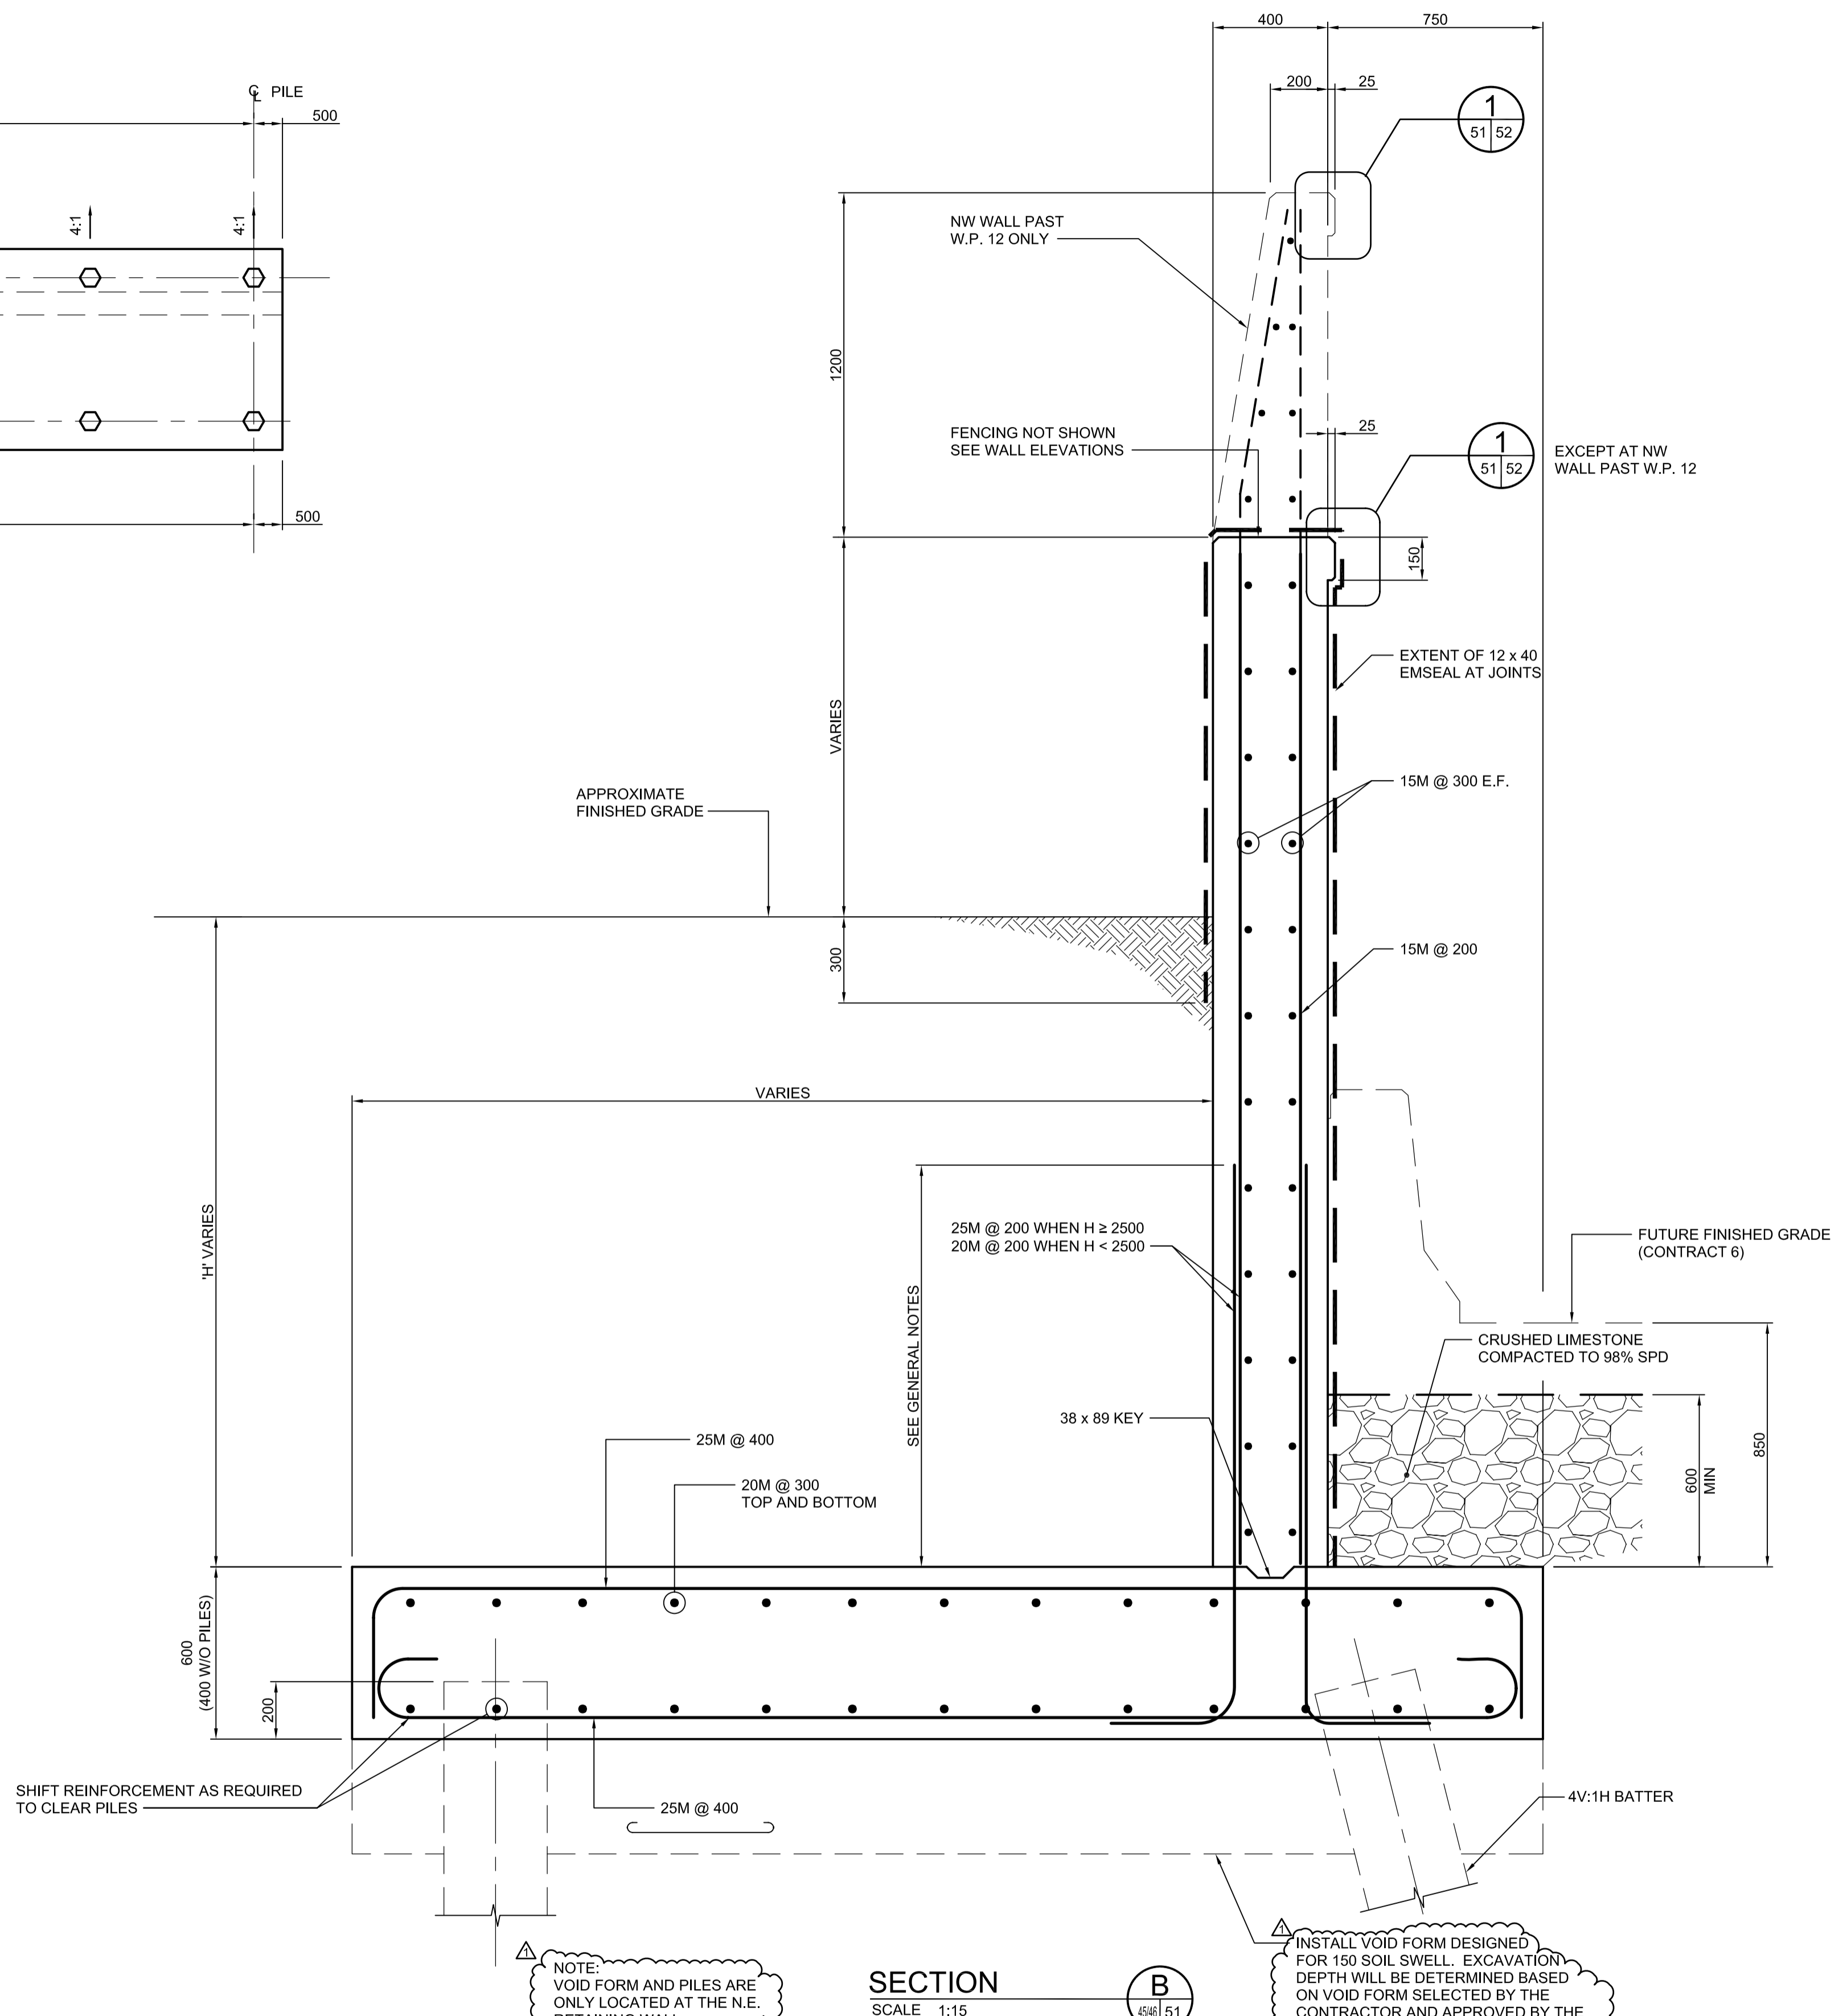

**SECTION**  
SCALE 1:15

<b>LOCATION UNDERGROUND STRUCTURES</b> SUPV. U/G STRUCTURES COMMITTEE DATE		<b>APPROVED STRUCTURES</b> DATE		B.M. ELEV.		DESIGNED BY: KGW DRAWN BY: RCB CHECKED BY: KGW APPROVED BY: DPK		ENGINEER'S SEAL PROVINCE OF MANITOBA ORIGINAL SIGNED BY: K. G. WILLIS 10.13.2009 REGISTERED PROFESSIONAL ENGINEER		<b>THE CITY OF WINNIPEG</b> <b>TRANSIT DEPARTMENT</b> SOUTHWEST RAPID TRANSIT CORRIDOR - STAGE 1 TRANSITWAY TUNNEL AT CN RIVERS SUBDIVISION MILEAGE 1.38 & ASSOCIATED WORKS		CITY DRAWING NUMBER: U237-09-51 SHEET 51 OF 73	
NOTE: LOCATION OF UNDERGROUND STRUCTURES AS SHOWN ARE BASED ON THE BEST INFORMATION AVAILABLE BUT NO GUARANTEE IS GIVEN THAT ALL EXISTING UTILITIES ARE SHOWN OR THAT THE GIVEN LOCATIONS ARE EXACT. CONFIRMATION OF EXISTENCE AND EXACT LOCATION OF ALL SERVICES MUST BE OBTAINED FROM THE INDIVIDUAL UTILITIES BEFORE PROCEEDING WITH CONSTRUCTION.				1 ISSUED WITH ADDENDUM #4 11/04/2009 RCB 0 ISSUED FOR TENDER 10/13/2009 RCB		HOR. SCALE AS SHOWN VERTICAL AS SHOWN		RELEASED FOR CONSTRUCTION DATE		CONSULTANT PROJECT NO. 088813		GRAVITY WALL DETAILS CONSULTANT DRAWING NUMBER C4-S1128-T	



G:\csc\088813\Contract\Contract\_1\Current\C4-S1128-P.dwg