



- NOTES:**
1. ALL ROADWAY DIMENSIONS SHOWN ARE TO BACK OF CURB.
 2. REFER TO DRAWINGS FOR DETAILED CULVERT DESIGN.
 3. ALL CURBS SHALL BE 125 REVEALED HEIGHT BARRIER CURB, UNLESS OTHERWISE NOTED.
 4. ADD 200.00 TO ALL ELEVATIONS TO OBTAIN GEODETIC ELEVATIONS.
 5. ALL GRASSED AREAS TO BE RESTORED TO EQUAL TO OR BETTER THAN PRE-CONSTRUCTION CONDITIONS.

2+00= IB AT SW CORNER OF NESS AVENUE AND ALBANY STREET

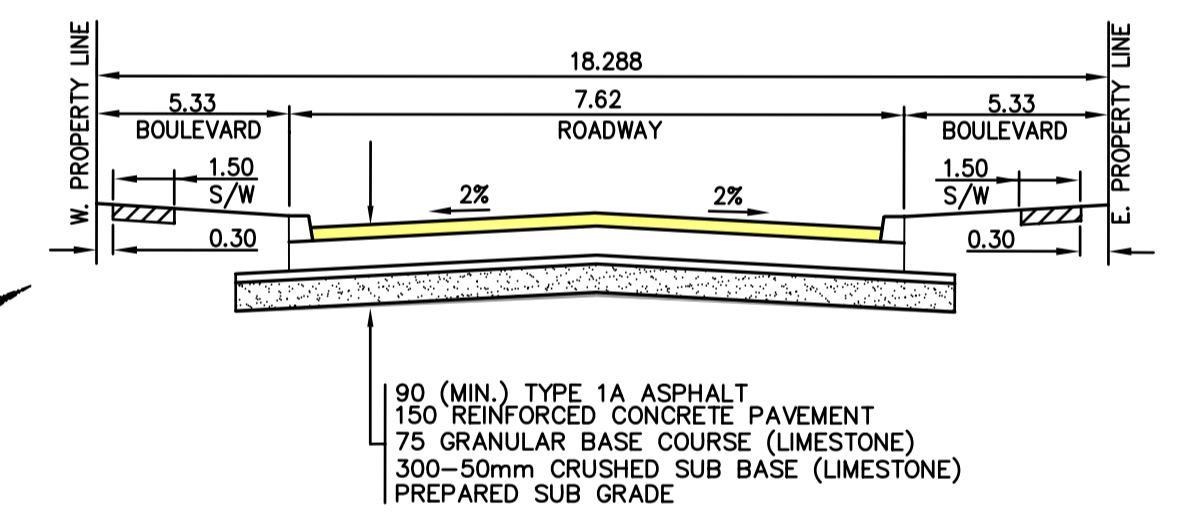

TYPICAL CROSS-SECTION
SCALE: NTS

REFER TO C340-09-04 FOR CULVERT GENERAL ARRANGEMENT

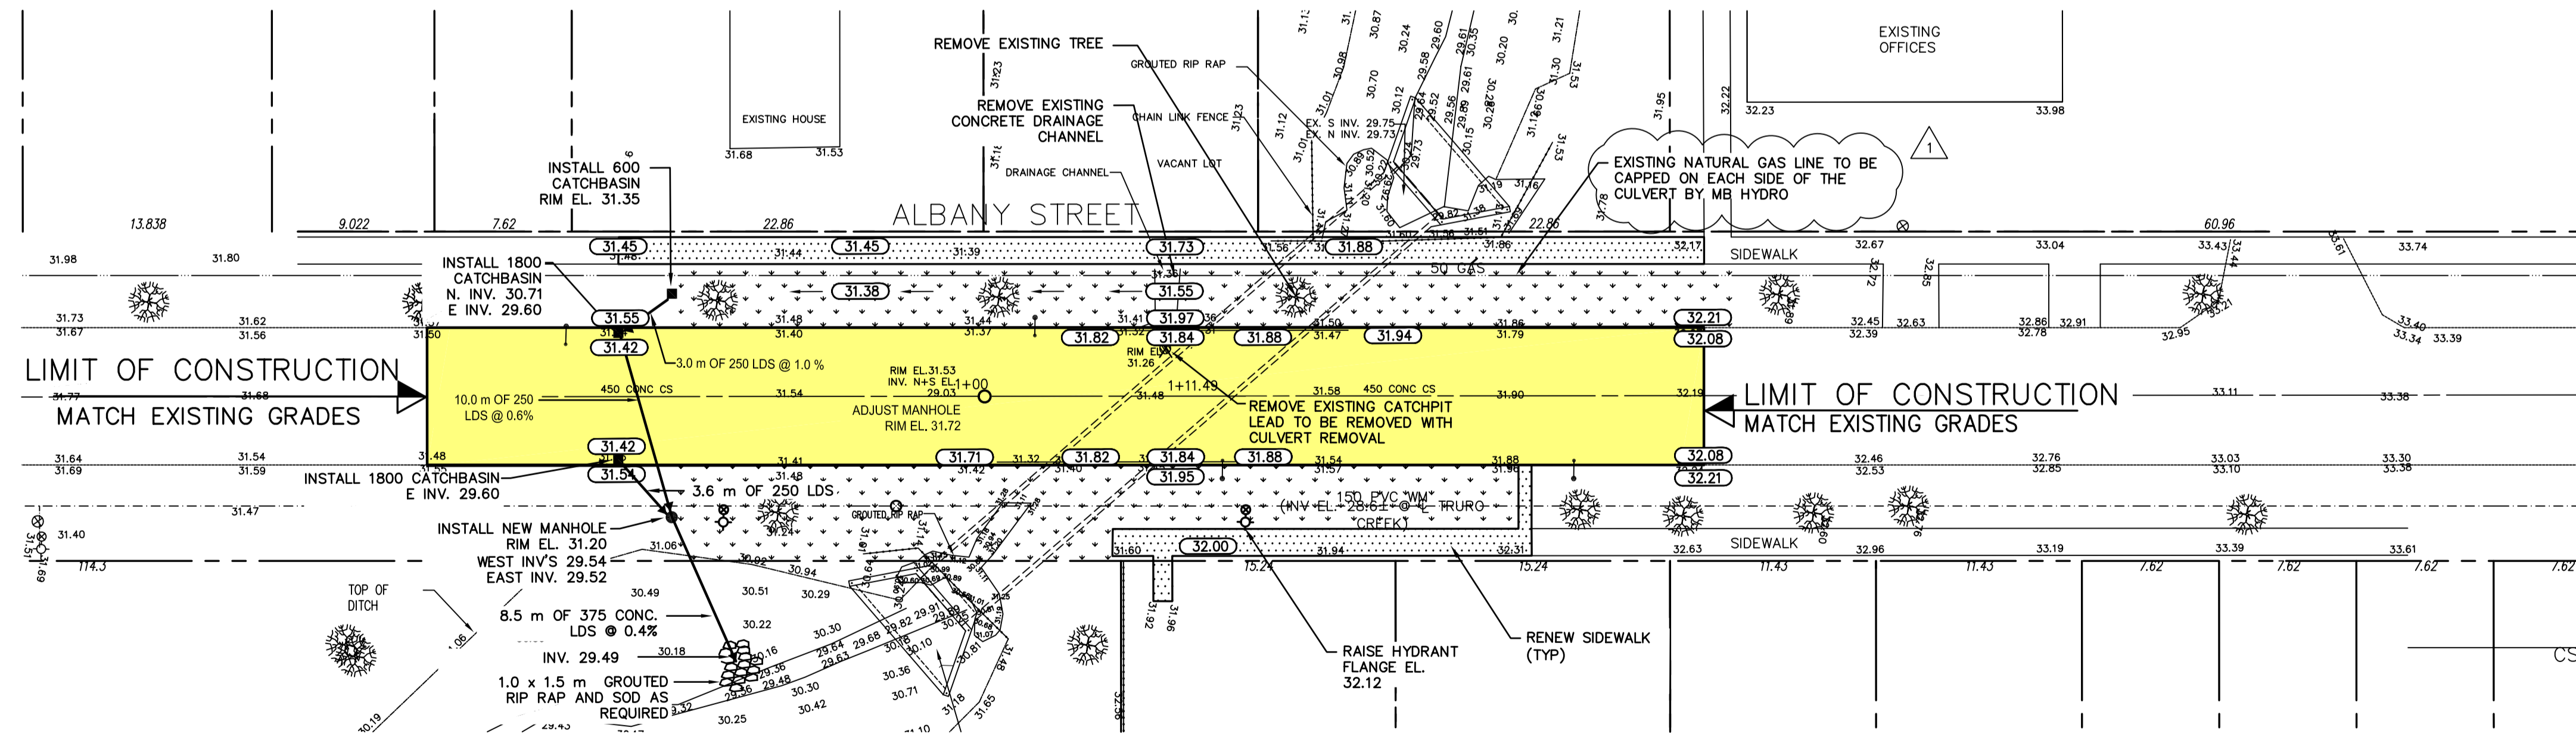

NOTE:
These design documents are prepared solely for the use by the party with whom the design professional has entered into a contract and there are no representations of any kind made by the design professional to any party with whom the design professional has not entered into a contract.

⊕	WATERMAIN	LS	---	---	---	---	---
⊕	HYDRANT VALVE	---	---	---	---	---	---
---	LAND DRAINAGE SEWER	---	---	---	---	---	---
---	WASTE WATER SEWER	---	---	---	---	---	---
○	MANHOLE	●	---	---	---	---	---
●	CATCH BASIN	■	---	---	---	---	---
---	UTILITIES ADJUSTED	⊕ ⊗ ⊙ △	---	---	---	---	---
---	GAS	---	---	---	---	---	---
---	M.T.S.	---	---	---	---	---	---
---	EXISTING	---	---	---	---	---	---
---	LEGEND-PLAN	---	---	---	---	---	---
---	PROPOSED	---	---	---	---	---	---
---	EXISTING	---	---	---	---	---	---
---	LEGEND-PROFILE	---	---	---	---	---	---
---	PROPOSED	---	---	---	---	---	---

---	CENTRE LINE	---	---
---	WEST GUTTER	---	---
---	EAST GUTTER	---	---
---	WEST PROP. LINE	---	---
---	EAST PROP. LINE	---	---

---	LOCATIONS APPROVED	---	---
---	UNDERGROUND STRUCTURES	---	---
---	SIGNED BY:	---	---
---	SUPV U/G STRUCTURES	---	---
---	DATE	---	---

---	G.B.M. ELEV.	---	---
---	DESIGNED BY	---	---
---	DRAWN BY	---	---
---	HOR. SCALE	---	---
---	VERT. SCALE	---	---
---	REVISIONS	---	---
---	DATE	---	---
---	BY	---	---
---	DATE	---	---

---	ENGINEER'S SEAL	---	---
---	DESIGNED BY	---	---
---	CHECKED BY	---	---
---	DRAWN BY	---	---
---	APPROVED BY	---	---
---	RELEASED FOR CONSTRUCTION	---	---
---	ORIGINAL SIGNED BY B.A. NEIRNICK	---	---
---	BID OPPORTUNITY	---	---
---	579-2009	---	---

METRIC
WHOLE NUMBERS INDICATE MILLIMETRES
DECIMALIZED NUMBERS INDICATE METRES

APCGM
Certificate of Authorization
MMM Group Limited
No. 4531 Date: 09.07.31

CITY OF WINNIPEG
PUBLIC WORKS DEPARTMENT
Winnipeg

ALBANY STREET
CROSSING OF TRURO CREEK
PROPOSED ROADWORKS
PLAN AND PROFILE

CONSULTANT DRAWING NUMBER
42088-C01
SHEET 2 OF 6
CITY DRAWING NUMBER
C340-09-02

Aug 14, 2009 - 9:24am
 P:\42088 - 42088\42088 - Albany Street Crossing of Truro Creek\Drawings\42088_albany_011_rdw\42088_albany_011_rdw.dwg - tab:OPTION A