



2 SECTION DETAIL
1 1/2" = 1'-0"

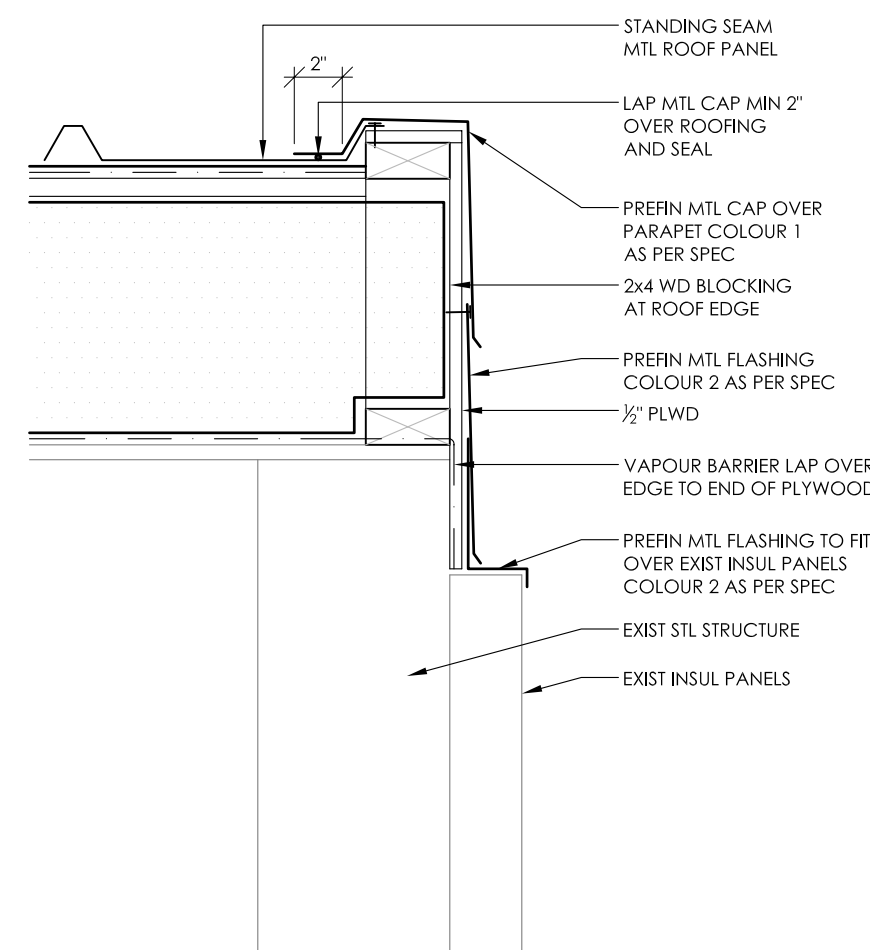

3 SECTION DETAIL
1 1/2" = 1'-0"

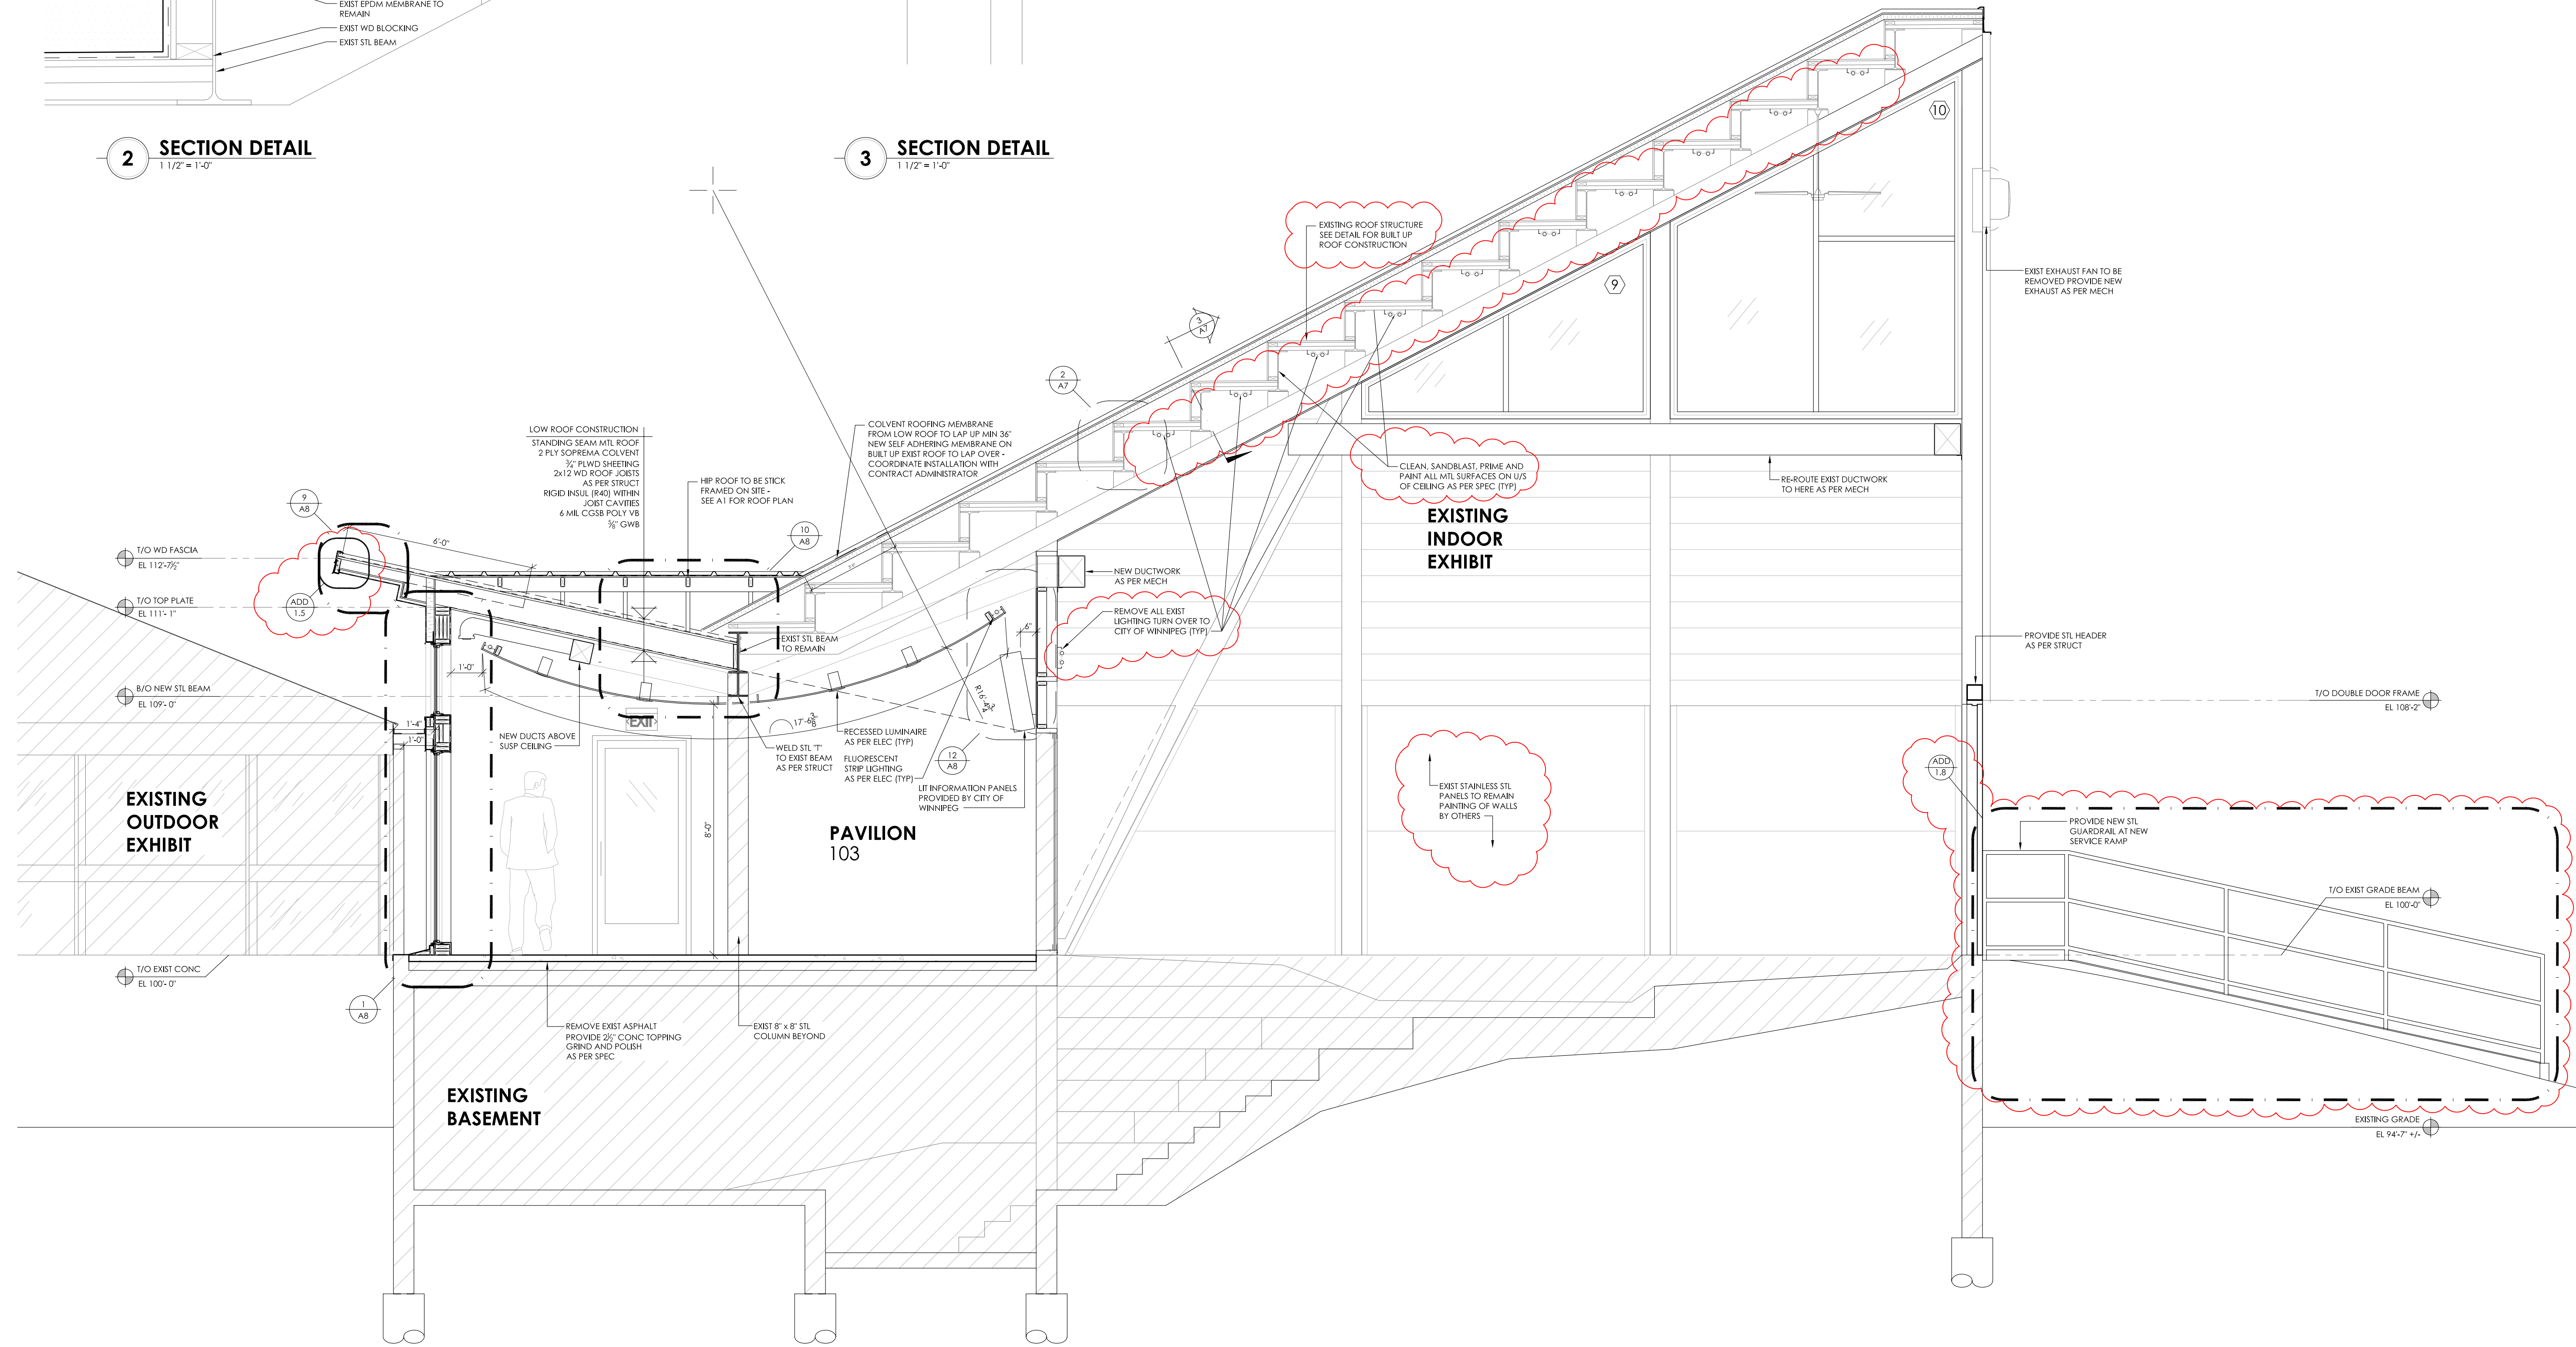

1 BUILDING SECTION
3/8" = 1'-0"