
FLOOR PLANS MECHANICAL

Project Number: 0714 MAR.17/09

Issued For: ADDENDUM N

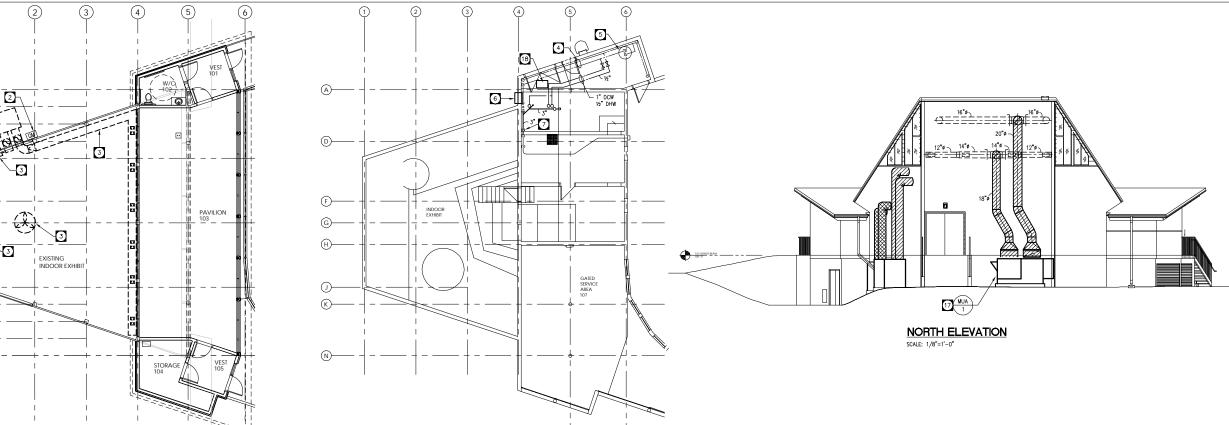

BASEMENT PLAN - MECHANICAL

B)-

18"ø

(1)

(2)

PARTIAL MAIN FLOOR PLAN -UPPER LEVEL

(3)

(4)

PAVILION 103

B _____

(N)

PARTIAL MAIN FLOOR PLAN - INDOOR EXHIBIT DEMOLITION

(1)

A 22 RT 2

(B)-

 \oplus

(M)-

800 LB\$ 115MBH

√13

PARTIAL MAIN FLOOR PLAN -LOWER LEVEL

(3)

9 EF

- (21)-

419

1.5KW

ADDENDUM NO.3 - ITEM 2

DRAWING NOTES

- APPROXIMATE LOCATION OF PAD MOUNTED AIR HANDLING UNIT; PROVIDE FOR THE REMOVAL OF EXISTING UNIT AND HOUSEKEPING PAD AND COMPLETE INSTALLATION OF NEW NCLUDE MODIFICATIONS TO EXISTING NATURAL, GAS SERVICE AND ALL ASSOCIATED UTILITY COSTS. CONORETE PAD MODIFICATIONS, ETC., AS REQUIRED TO FAQUILITATE INTERCONNECTION. COORDINATE WITH STRUCTURAL DRAWINGS FOR HOUSEKEEPING PAD CONSTRUCTION.
- EXISTING NATURAL GAS METER; MODIFY/EXTEND AS REQUIRED TO SUIT NEW AIR HANDLING EQUIPMENT INSTALLATIONS.
- REMOVE ALL EXISTING FANS, DUCT WORK, GRILLES, HANGERS, ETC., SERVING NODOR EXHIBIT. COORDINATE WITH ARCHITECTURAL PLANS AND CONTRACTOR FOR PATCH/REPAIR OF REMAINING WALL PENETRATIONS.
- EXISTING DCW/DHW IN BASEMENT; MODIFY/EXTEND AS REQUIRED TO SUIT NEW FIXTURE INSTALLATIONS.
- 5 EXISTING DOMESTIC HOT WATER HEATER TO REMAIN.
- 6 EXISTING WALL MOUNT AIR CONDITIONING UNIT TO REMAIN.
- NEW PAD MOUNT PACKAGED AIR UNIT; OFFSET INTERIOR INSULATED WATER TIGHT SUPPLY //ECTURN DUCTS UP ALONG EXTERIOR WALL, THRU INDOOR EXHIBIT TO PAVILON 103 CELLING SPACE. WOOIFT/EXTEND GAS SUPPLY FROM EVISING GAS METER. COORDINATE WITH STRUCTURAL DRAWINGS FOR HOUSEKEEPING PAD CONSTRUCTION.

 WASHROOM EXHAUST FAN; EXTEND INSULATED DISCHARGE TO STEEL HOODED WALL CAP W/ BOD, BIRDSORGEN.
- EXTEND SANITARY VENT UP THRU ROOF C/W 3" INCREASER AT ROOF PENETRATION.
- 11 ELECTRIC FORCE FLOW HEATER PROVIDED/INSTALLED BY DIVISION 16.
- SUPPLY GRILLES AT NEW ARCHITECTURAL CEILING; COORDINATE INSTALLATION ACCORDINGLY.

- 18 EXISTING ELECTRIC FORCE FLOW HEATER.

- 21 ALL LINED SUPPLY DUCTWORK WITHIN INDOOR EXHIBIT TO/FROM RT-1 (SERVING INDOOR PAYLION) TO BE WELDED STAINLESS STEEL SEALED WATER TIGHT. COORDINATE ACCORDINGLY FOR WATER TIGHT SEAL ALL THEFMALE ENVELOPE WALL PENETRATION
- 22 NEW PAD MOUNT PACKAGED AR UNIT: OFFSET EXTERIOR INSULATED/JACKETED SUPPLY /RETURN DUCTS UP ALONG EXTEROR WALL, THRU TO INDOOR EXHBIT. MODIFY-KETMO AS SUPPLY FROM EXISTING AGS METER COORDINATE WITH STRUCTURAL DRAWINGS FOR HOUSEKEEPING PAD CONSTRUCTION.

- OFFSET NEW 3" SANITARY DOWN FROM HIGH LEVEL, TIE-IN TO BASE OF EXISTING 4" VERTICAL SANITARY STACK; MODIFY/EXTEND AS REQUIRED TO FACILITATE INTERCONNECTION.

- $\ensuremath{\ensuremath{\square}}$ Supply duct mount around perimeter of indoor exhibit, at elevations below new window installation.
- 14 SUPPLY GRILLES MOUNTED ABOVE DUCT FOR UP DISCHARGE AT WINDOWS.
- 15 SUPPLY GRILLES MOUNTED AT U/S OF DUCT FOR DOWN DISCHARGE.
- SUPPLY GRILLES DUCT MOUNT WITH DOWN DISCHARGE AT 45-DEGREE TO THE HORIZONTAL.
- PAD MOUNTED NATURAL GAS MAKE-UP AIR UNIT C/W HEAT RECOVERY (HEAT PIPE).

 ZYTEND EXTENDER INSULATED/JACKETED DUCT UP AT SIDEWALL OF INDOOR EXHIBIT TO HIGH LEVEL;

 OFFSET WITHIN EXHIBIT AREA AT HIGH LEVEL. COORDINATE WITH STRUCTURAL DRAWINGS FOR HOUSEKEEPING PAD CONSTRUCTION.
- DUCTWORK ABOVE SUSPENDED CEILING IN PAVILION 103 MUST FOLLOW SLOPE OF STRUCTURE; COORDINATE AS REQUIRED TO AVOID CONFLICT WITH LIGHTS, STRUCTURE, ETC.
- NATURAL GAS METER; MODIFY/EXTEND AS REQUIRED TO ACCOMMODATE NEW GAS FIRED APPLIANCES. TOTAL CONNECTED LOAD: 530MBHI

VENTILATION SUMMARY

GENERAL NOTES:

BASED ON ASHRAE 62.1-2004, TABLE 6-1 RT-1 INDOOR PAVILION (BASED ON MUSEUM/GALLERY OCCUPANCY): (50 OCC. X 7.5CFM/OCC.) + (850SQ.FT. X 0.06CFM/SQ.FT.) = 426CFM O/A

ADDENDUM NO.3
ITEM 1

T. STANLESS STEEL DUCT SERVING RT-1 WITHIN INDOOR EXHIBIT AREA
106 SHALL BE INSTALLED IN LENGTHS AS REQUIRED TO
ACCOMMODATE INSTALLATION OF INTERNAL INSULATION. EQUIVALENT
SIZE ROUND DUCTS SHALL BE ACCEPTED PROVIDED ALL AREAS AREA
INTERNALLY INSULATED AS REQUIRED. CONNECTIONS AT EACH JOINT
SHALL BE MORE VIA MANUFACTURED STANLESS STEEL DUCT
CONNECTION SYSTEM, FLANCED AND CASKETED TO MAINTAIN A
WATERTHORT SEAL THE CASKET MATERIAL SHALL BE NON-HARDENING,
WATER AND MILDEW RESISTANT, AND MEETS APPROVAL OF LICE DUCT
CONNECTION SYSTEMS AS MANUFACTURED BY DUCTAME AND NEXUS
SHALL BE ACCEPTED, OR APPROVED EQUALS IN ACCORDANCE WITH B6. INSTALLATIONS TO SMACNA AND MANUFACTURERS
RECOMMENDATIONS.

NOVA 3 ENGINEERING LTD.
CONSULTING ENGINEERS

M1