


ELEVATION ON GRID 2/3
SCALE 1:50

ELEVATION ON GRID A/C
SCALE 1:50

ELEVATION ON GRID D
SCALE 1:50

ELEVATION ON GRID 4/5
SCALE 1:50

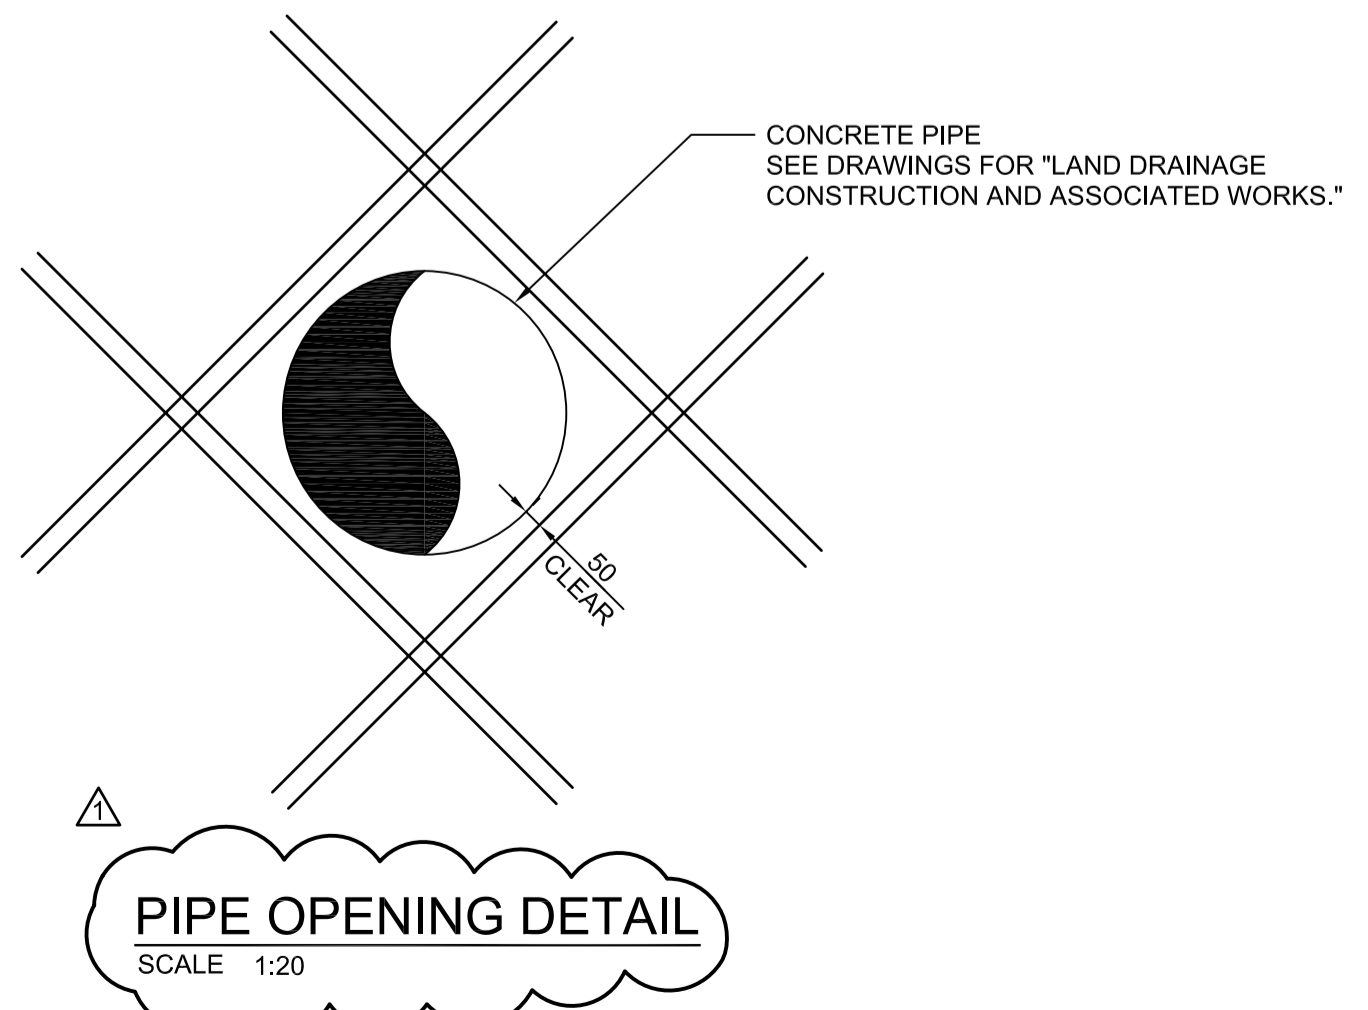

PIPE OPENING DETAIL
SCALE 1:20



NO.	REVISIONS	DATE	BY
1	ISSUED WITH ADDENDUM #1	18/04/2009	RCB
0	ISSUED FOR TENDER	25/03/09	RCB

DESIGNED BY	KGW
DRAWN BY	RCB
CHECKED BY	ORIGINAL SIGNED BY JAMES SKEET
APPROVED BY	ORIGINAL SIGNED BY NORM ULYATT
HOR. SCALE	AS SHOWN
VERTICAL SCALE	AS SHOWN
DATE	01-01-09

DILLON CONSULTING

RELEASED FOR CONSTRUCTION
ORIGINAL SIGNED BY RANDY FINGAS
DATE 25/03/09

ENGINEER'S SEAL
PROVINCE OF MANITOBA
J.A. SKEET
Member 25025
REG. SURVEY PROFESSIONAL ENGINEER

THE CITY OF WINNIPEG
TRANSIT DEPARTMENT

Winnipeg

SOUTHWEST RAPID TRANSIT CORRIDOR - STAGE 1
LAND DRAINAGE PUMPING STATION & ASSOCIATED WORKS

WALL LAYOUT

CITY DRAWING NUMBER LD-5309
SHEET 10 OF 25

CONSULTANT PROJECT NO. 088813

C2-B2103-T