



**A** TRANSITWAY SECTION - STA. 12+770  
SCALE H=1:100 V=1:50

230 PLAIN DOWELLED PAVEMENT  
75 LIMESTONE BASE COURSE  
150 CRUSHED LIMESTONE SUBBASE  
MAX. AGGREGATE SIZE 50mm  
450 CRUSHED LIMESTONE SUBBASE  
MAX. AGGREGATE SIZE 150mm  
SEPERATION GEOTEXTILE FABRIC

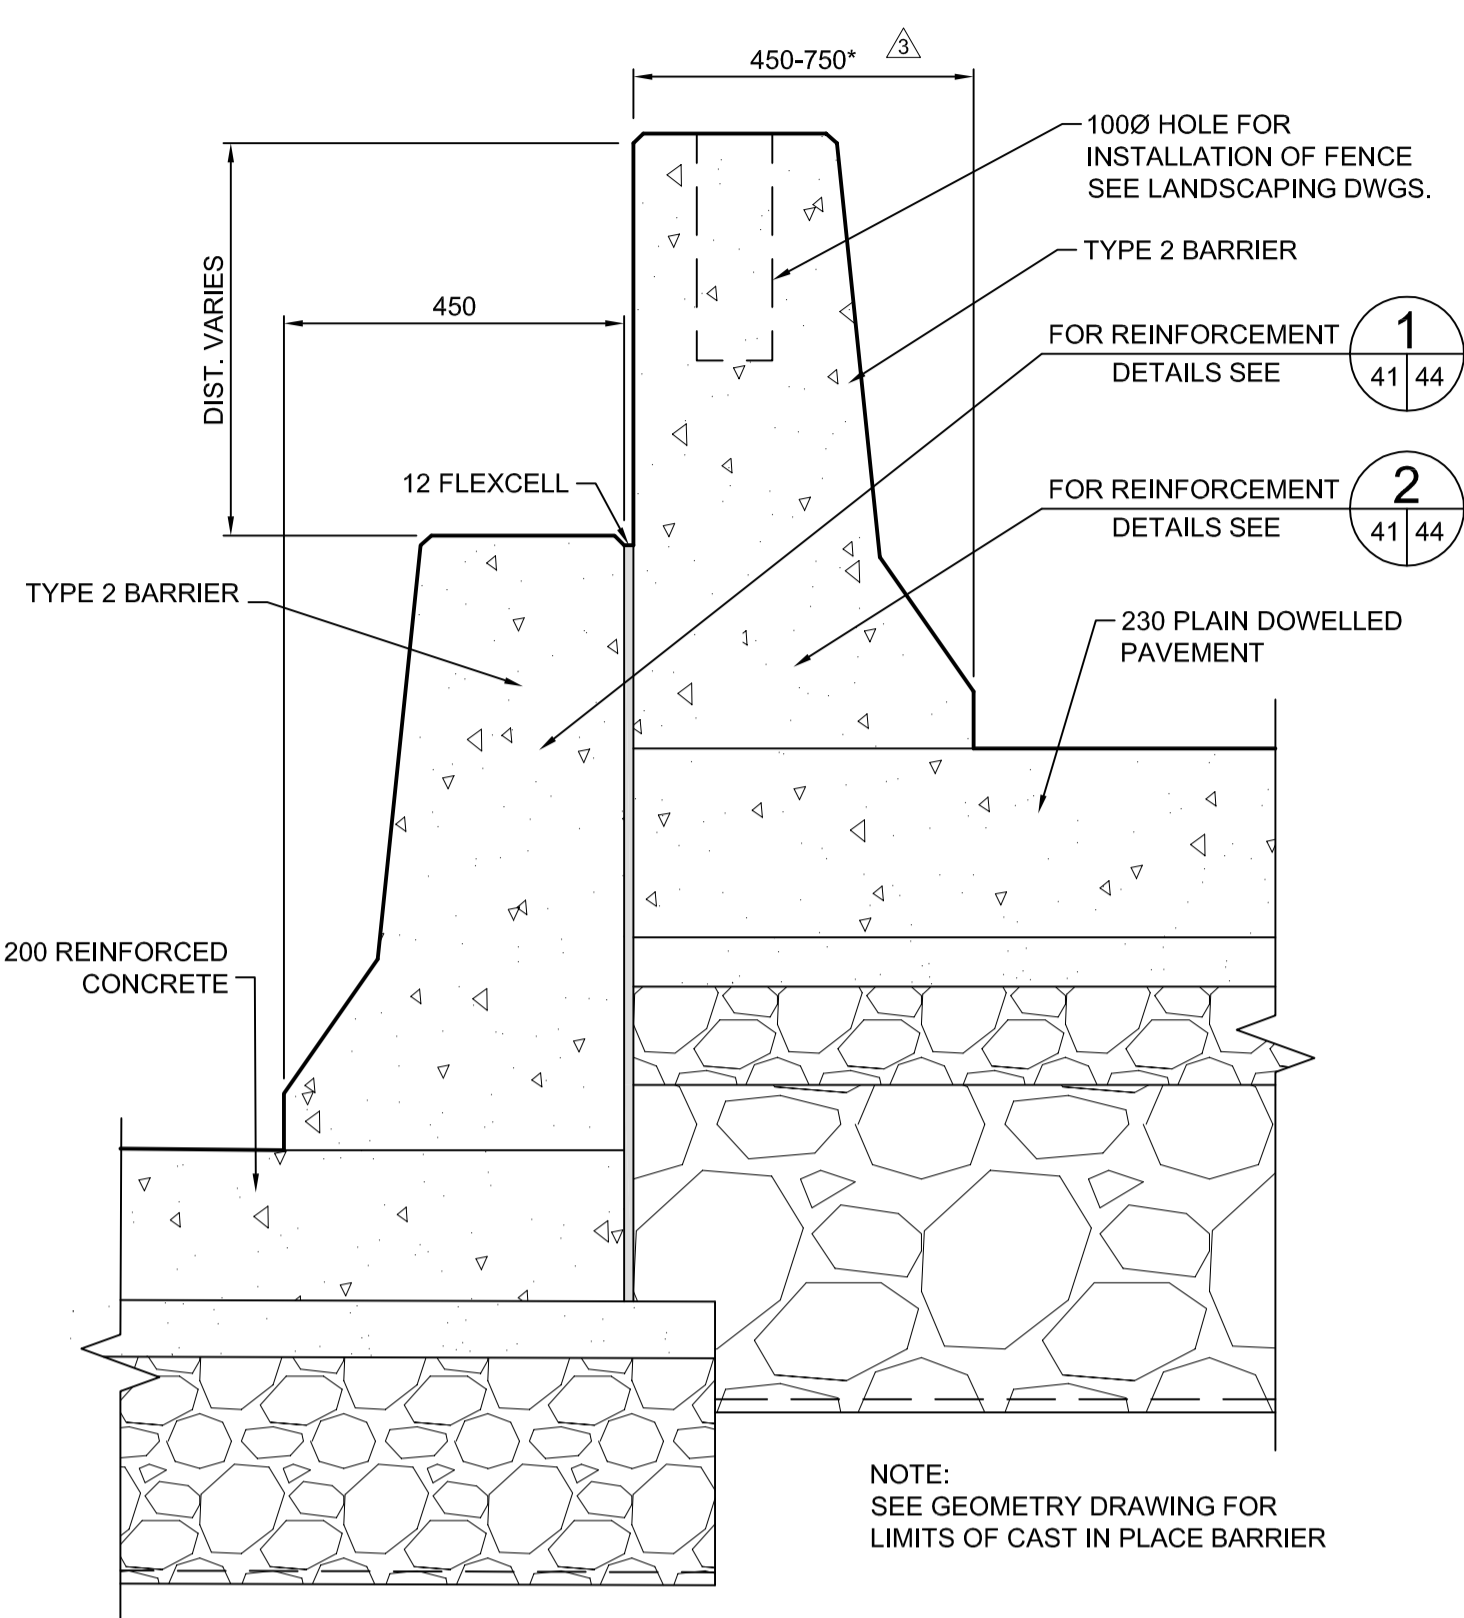


**DETAIL 1**  
SCALE 1:10

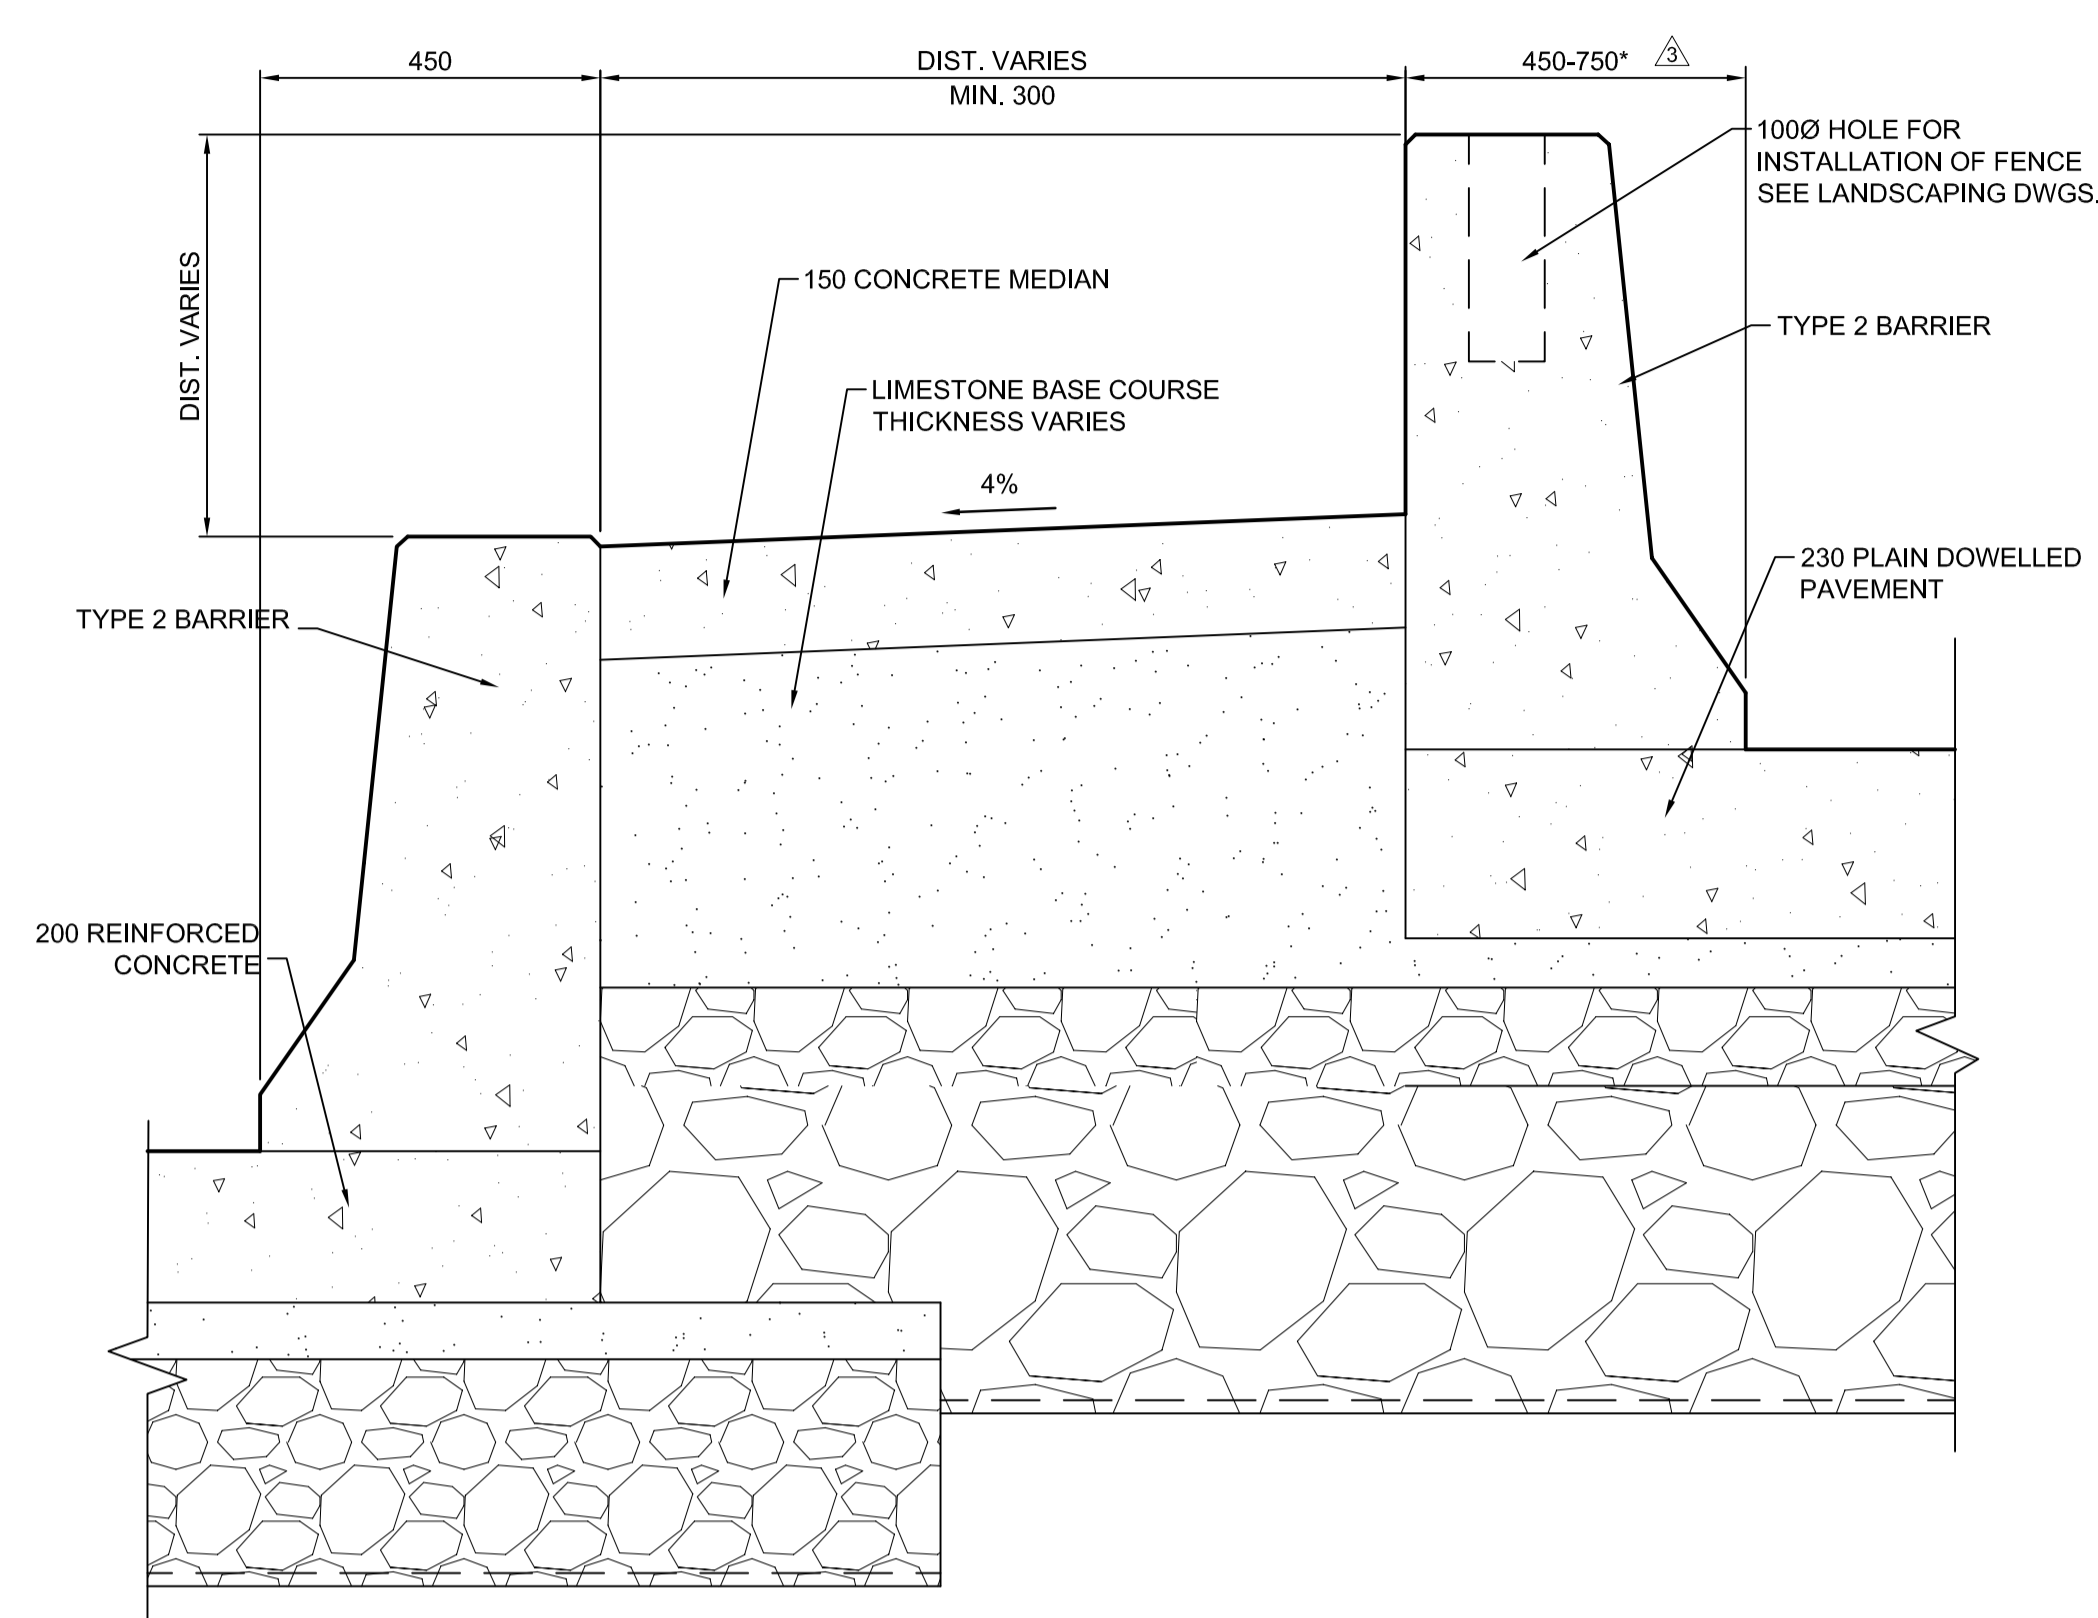


**DETAIL 2**  
SCALE 1:10

\* NOTE TRANSITWAY BARRIER (TYPE 2) WIDTH WIDENS TO 750 AT POINT MEDIAN SLAB IS 300 mm WIDE SEE GEOMETRY DWG 19 FOR LOCATIONS

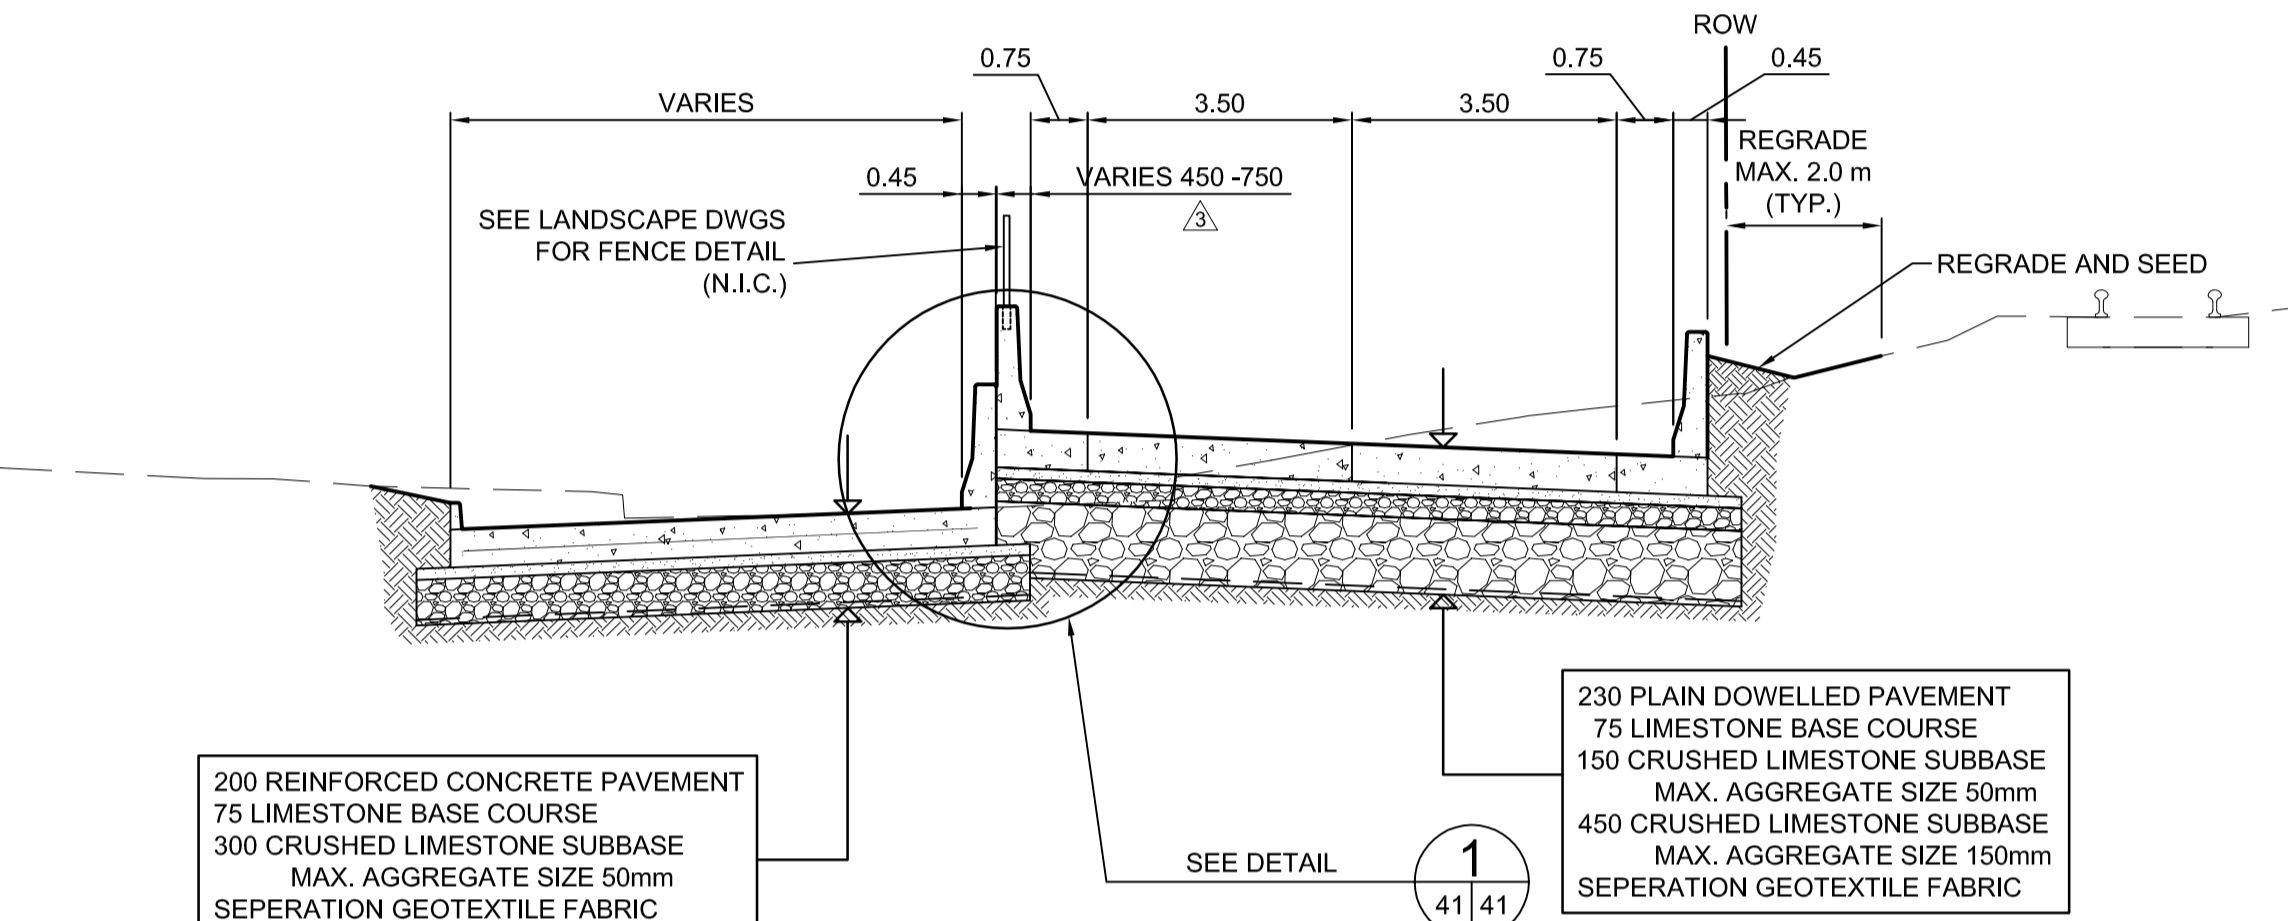


**B** LAGOPOULOS WAY SECTION - STA. 12+905  
SCALE H=1:100 V=1:50

230 PLAIN DOWELLED PAVEMENT  
75 LIMESTONE BASE COURSE  
150 CRUSHED LIMESTONE SUBBASE  
MAX. AGGREGATE SIZE 50mm  
450 CRUSHED LIMESTONE SUBBASE  
MAX. AGGREGATE SIZE 150mm  
SEPERATION GEOTEXTILE FABRIC

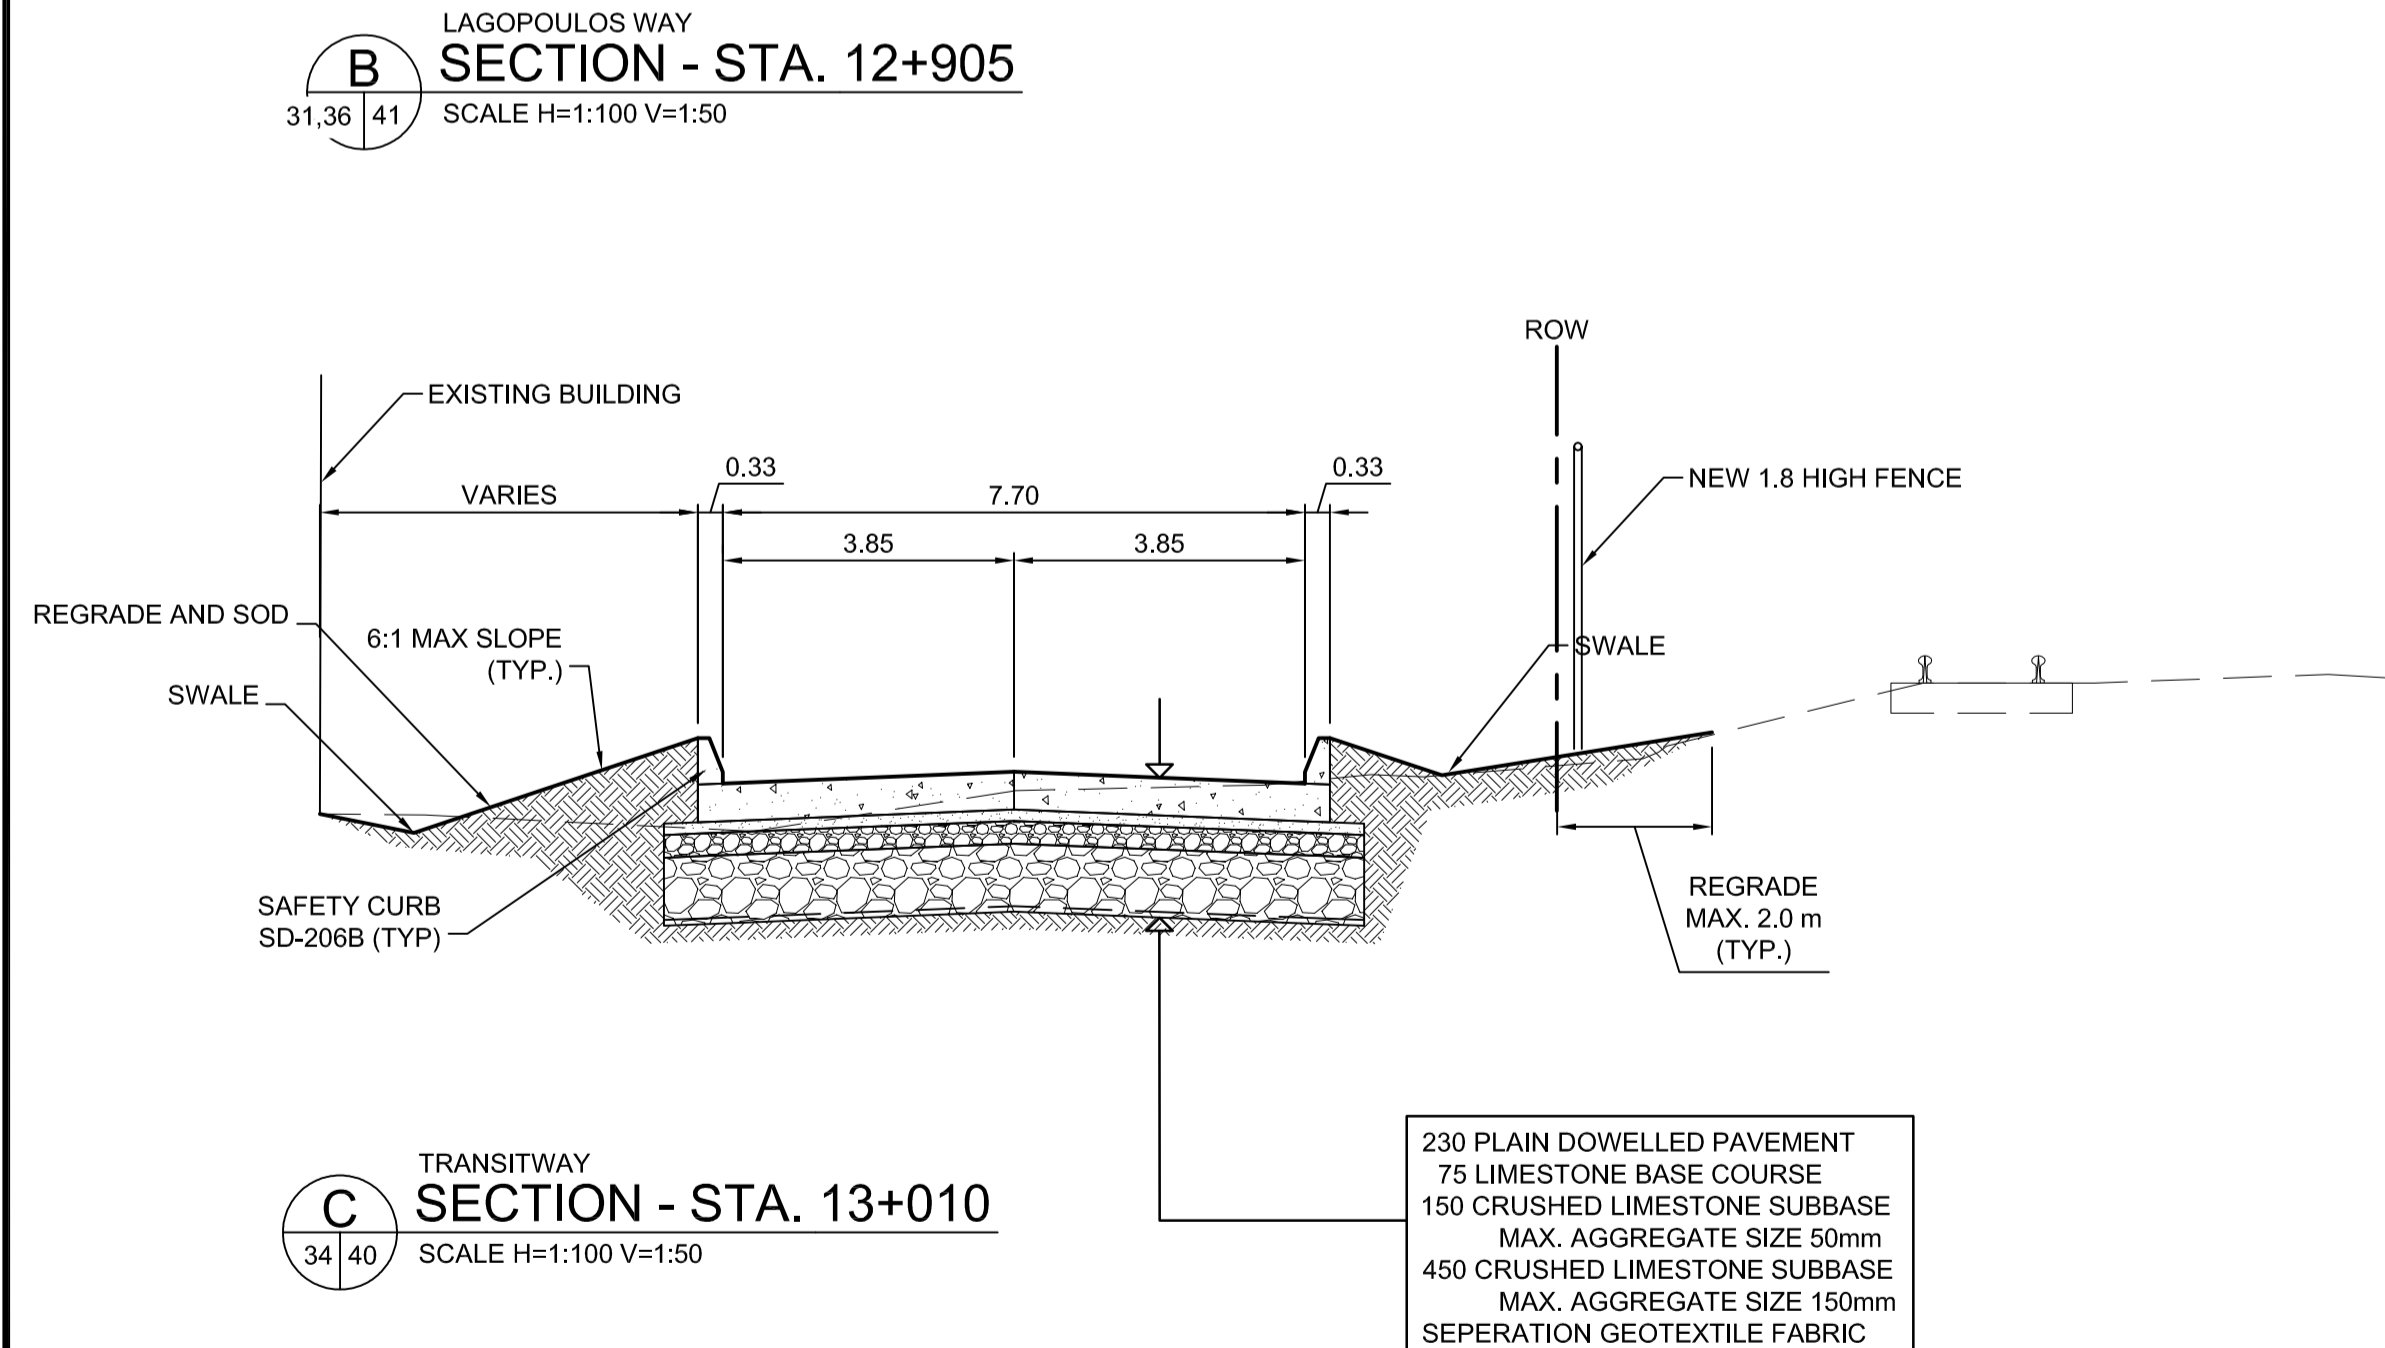

**C** TRANSITWAY SECTION - STA. 13+010  
SCALE H=1:100 V=1:50

230 PLAIN DOWELLED PAVEMENT  
75 LIMESTONE BASE COURSE  
150 CRUSHED LIMESTONE SUBBASE  
MAX. AGGREGATE SIZE 50mm  
450 CRUSHED LIMESTONE SUBBASE  
MAX. AGGREGATE SIZE 150mm  
SEPERATION GEOTEXTILE FABRIC

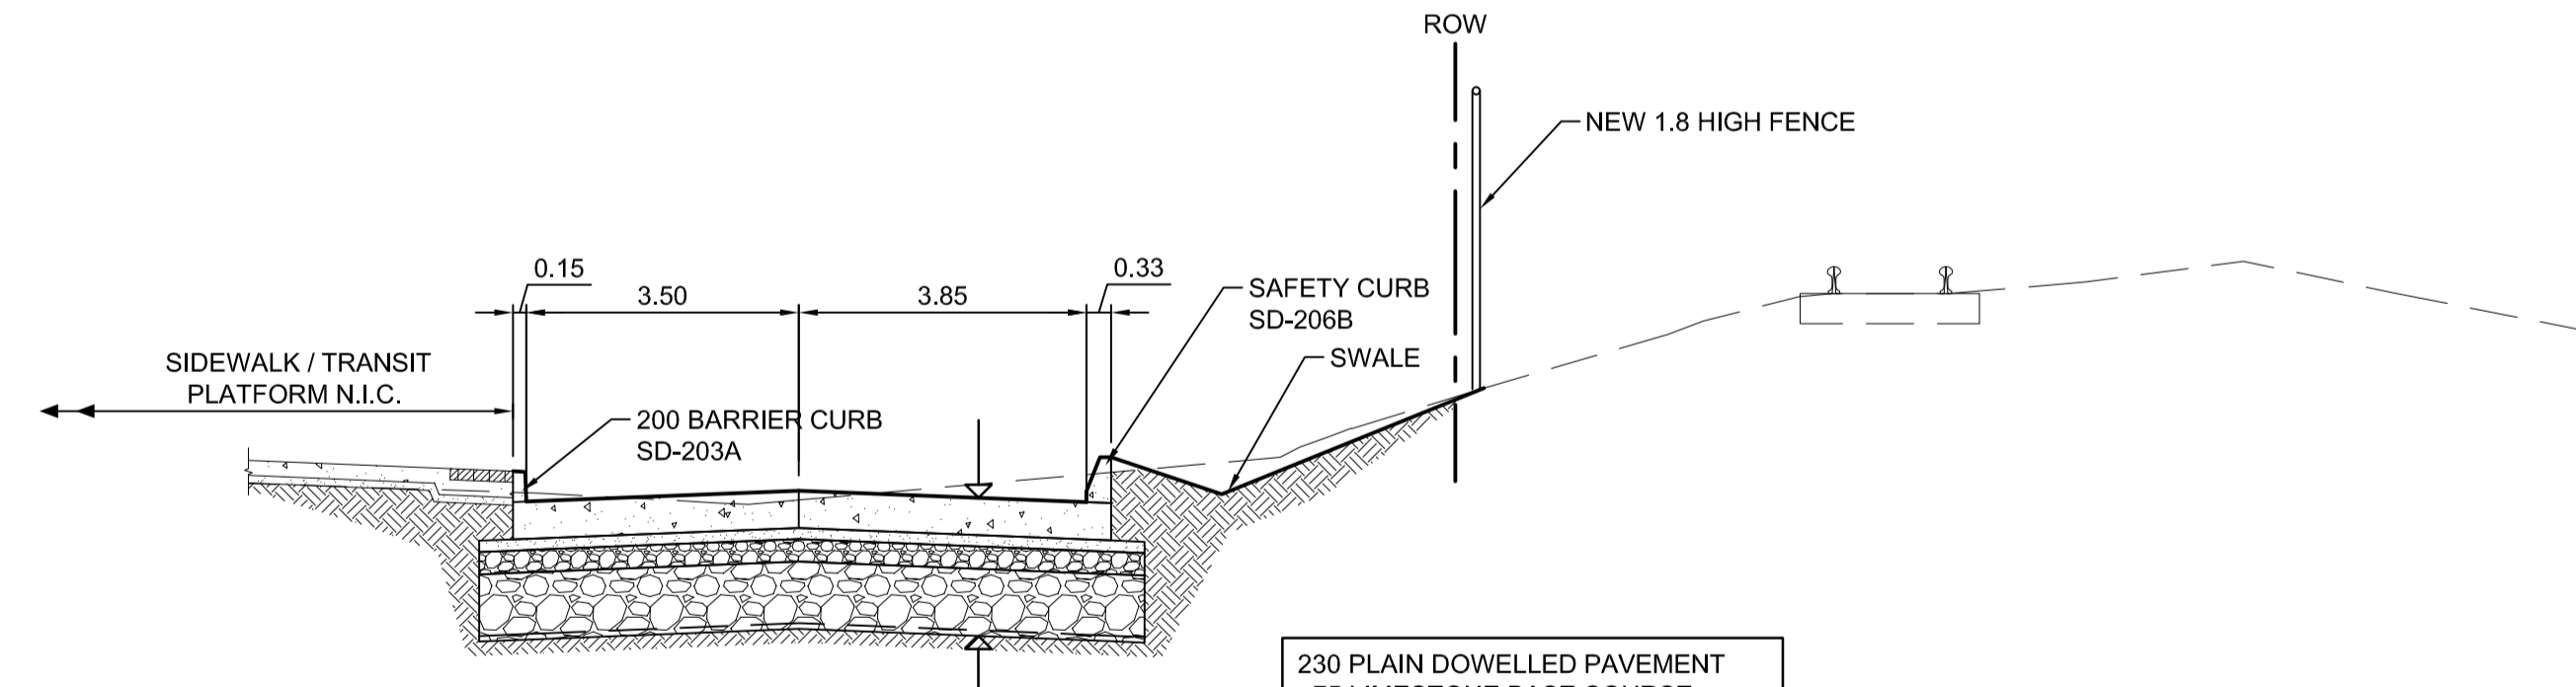

**D** TRANSITWAY SECTION - STA. 13+060  
SCALE H=1:100 V=1:50

230 PLAIN DOWELLED PAVEMENT  
75 LIMESTONE BASE COURSE  
150 CRUSHED LIMESTONE SUBBASE  
MAX. AGGREGATE SIZE 50mm  
450 CRUSHED LIMESTONE SUBBASE  
MAX. AGGREGATE SIZE 150mm  
SEPERATION GEOTEXTILE FABRIC

**CONSTRUCTION NOTES:**  
1. INSTALL 6 m OF 150 mm SUB DRAIN IN BOTH DIRECTIONS PARALLEL TO ROADWAY AT EACH CATCH BASIN AS PER SD-245 AND CAP ENDS.

**METRIC**  
WHOLE NUMBERS INDICATE MILLIMETRES  
DECIMALIZED NUMBERS INDICATE METRES.



LOCATION UNDERGROUND STRUCTURES	APPROVED STRUCTURES	B.M. 654265 (633392.694, 5525026.192) ELEV. 232.518	DESIGNED BY DBW/RTP		ENGINEER'S SEAL PROVINCE OF MANITOBA ORIGINAL SIGNED BY T.J. PETERS 04-29-09 Member 22309 REGISTERED PROFESSIONAL ENGINEER		THE CITY OF WINNIPEG TRANSIT DEPARTMENT											
SUPV. U/G STRUCTURES COMMITTEE	DATE		DRAWN BY TJH		RELEASSED FOR CONSTRUCTION ORIGINAL SIGNED BY RANDY FINGAS DATE 04/29/09		CONSULTANT PROJECT NO. 088813	SOUTHWEST RAPID TRANSIT CORRIDOR - STAGE 1 TRANSITWAY CONSTRUCTION, DONALD/HARKNESS RECONSTRUCTION & ASSOCIATED WORKS	CITY DRAWING NUMBER P-3299-41 SHEET 41 OF 64									
NOTE: LOCATION OF UNDERGROUND STRUCTURES AS SHOWN ARE BASED ON THE BEST INFORMATION AVAILABLE, BUT NO GUARANTEE IS GIVEN THAT ALL EXISTING UTILITIES ARE SHOWN OR THAT THE GIVEN LOCATIONS ARE EXACT. CONFIRMATION OF EXISTENCE AND EXACT LOCATION OF ALL SERVICES MUST BE OBTAINED FROM THE INDIVIDUAL UTILITIES BEFORE PROCEEDING WITH CONSTRUCTION.			CHECKED BY ORIGINAL SIGNED BY TARAN J. PETERS															
<table border="1"> <tr> <td>ISSUED FOR ADDENDUM #2</td> <td>05/15/09</td> <td>TJP</td> </tr> <tr> <td>ISSUED FOR TENDER</td> <td>04/29/09</td> <td>TJP</td> </tr> <tr> <td>SUBMITTED FOR 95% REVIEW</td> <td>02/13/09</td> <td>TJP</td> </tr> <tr> <td>NO. REVISIONS</td> <td>DATE</td> <td>BY</td> </tr>
