

1
AD03a **DELETION OF CURTAIN WALL**
SCALE 1:10

SEPARATE PRICE #6: DRAWING NOTES:
PROVIDE SEPARATE PRICE FOR DELETION OF ALUMINUM CURTAIN WALL FRAMING SYSTEM AT ENTRANCE VESTIBULE. PROVIDE AND INSTALL THE FOLLOWING IN LIEU:
- FIBREGLASS WINDOWS FOR OPENINGS.
- KAWNEER 451T (OR APPROVED EQUIVALENT) FRAMING SYSTEM FOR ENTRANCE FRAMING.
- ALUMINUM COLUMN ENCLOSURE.

harold funk architect inc.


Harold Funk Architect Inc.
Architecture and Urban Design

401-55 Donald Street, Winnipeg, Manitoba R3C 1L8
T (204) 943-5087 info@funkarchitect.com
F (204) 949-9231 funkarchitect.com

NOTE: THIS DRAWING IS PROVIDED FOR CLARIFICATION AND REVISION PURPOSES AND SHALL BE READ IN CONJUNCTION WITH OTHER CONSTRUCTION DOCUMENTATION. EXTRANEIOUS INFORMATION HAS BEEN REMOVED FOR CLARITY. NOTIFY THE CONTRACT ADMINISTRATOR IN THE EVENT OF QUESTIONS.

AD-03a
SINCLAIR PARK COMMUNITY CENTRE

Project # 08-011
Drawn: G.S.
Reviewed: H.F.
Date: 30th March 2010

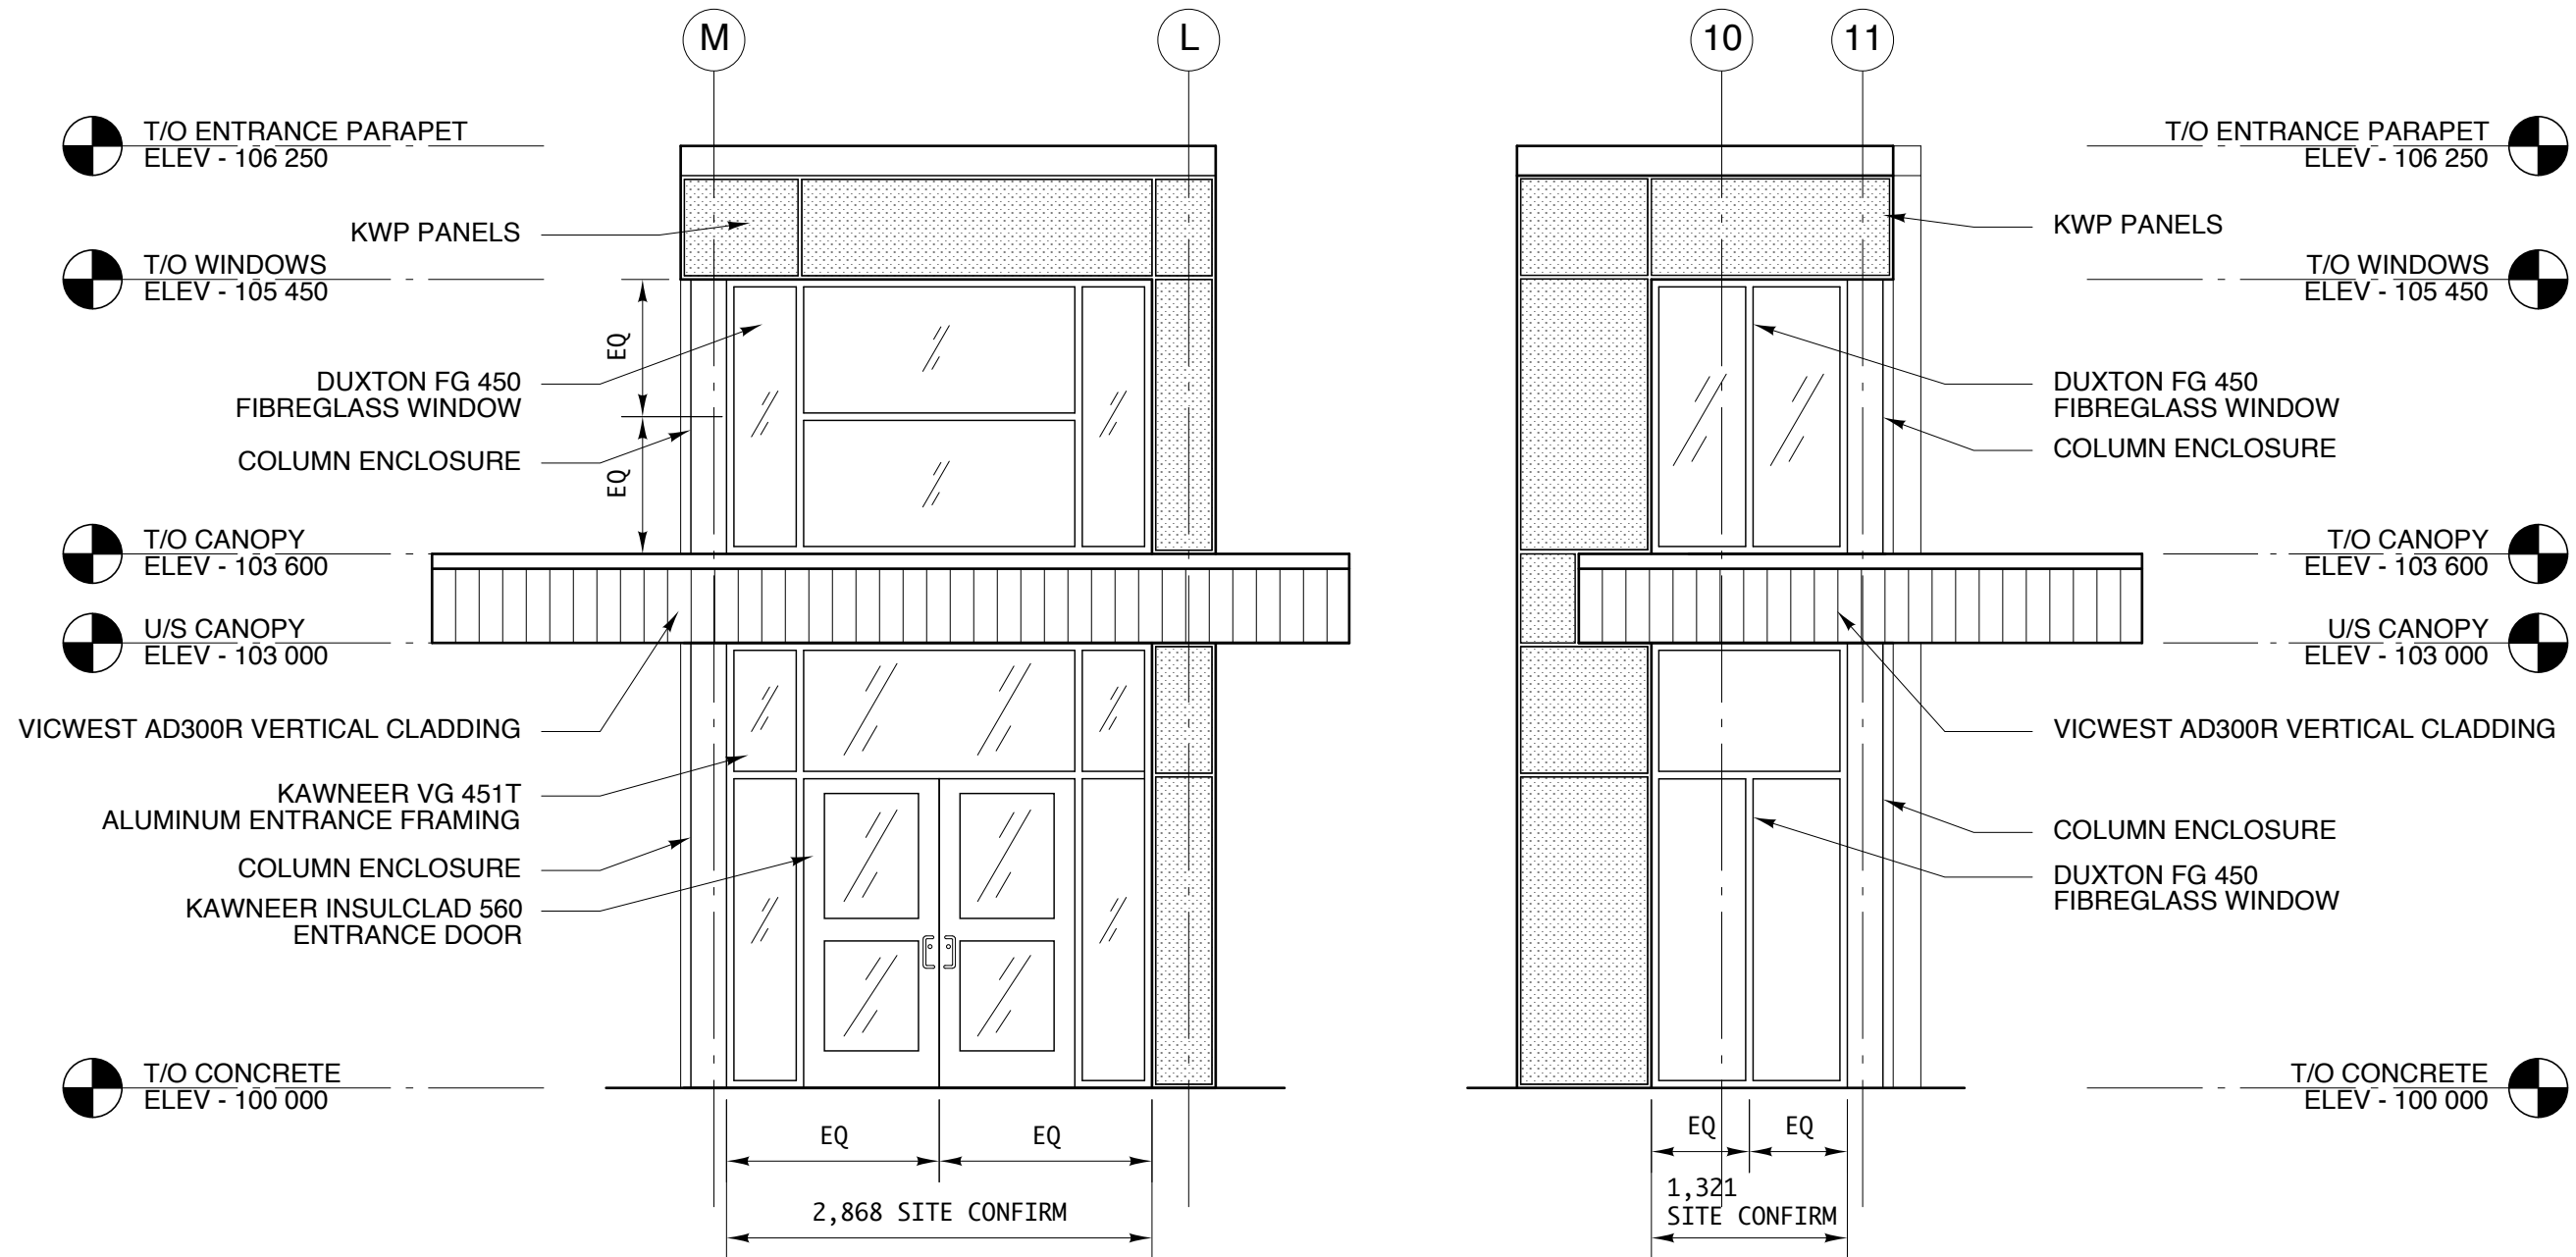

NOTE: TEMPERED GLASS WITH 6mm AND SULL SASH FOR ALL VESTIBULE GLAZING

1
AD03c **DELETION OF CURTAIN WALL**
 SCALE 1:50

harold funk architect inc.

Harold Funk Architect Inc.
 Architecture and Urban Design

401-55 Donald Street, Winnipeg, Manitoba R3C 1L8
 T (204) 943-5087 info@funkarchitect.com
 F (204) 949-9231 funkarchitect.com

NOTE: THIS DRAWING IS PROVIDED FOR CLARIFICATION AND REVISION PURPOSES AND SHALL BE READ IN CONJUNCTION WITH OTHER CONSTRUCTION DOCUMENTATION. EXTRANEOUS INFORMATION HAS BEEN REMOVED FOR CLARITY. NOTIFY THE CONTRACT ADMINISTRATOR IN THE EVENT OF QUESTIONS.


AD-03c
SINCLAIR PARK COMMUNITY CENTRE

Project # 08-011
 Drawn: G.S.
 Reviewed: H.F.
 Date: 30th March 2010

11

ACHIEVE FULL SEAL FROM WINDOW FRAMING TO WALL AIR BARRIER - TYP.
RETURN GYPSUM C/W J-MOULD & CAULK - TYP.
LAP AIR BARRIER AROUND OPENING - SEAL TO VAPOUR BARRIER - TYP.

DUXTON FG 450 FIBREGLASS WINDOW UNIT
ROD & CAULK
PREFIN. METAL FLASHING - SLOPED
P.T. WOOD BLOCKING - CUT TO SLOPE
LAP MOD-BIT BASE SHEET INTO OPENING - SEAL TO AIR BARRIER & FLASHING FOR COMPLETE WATER SEAL

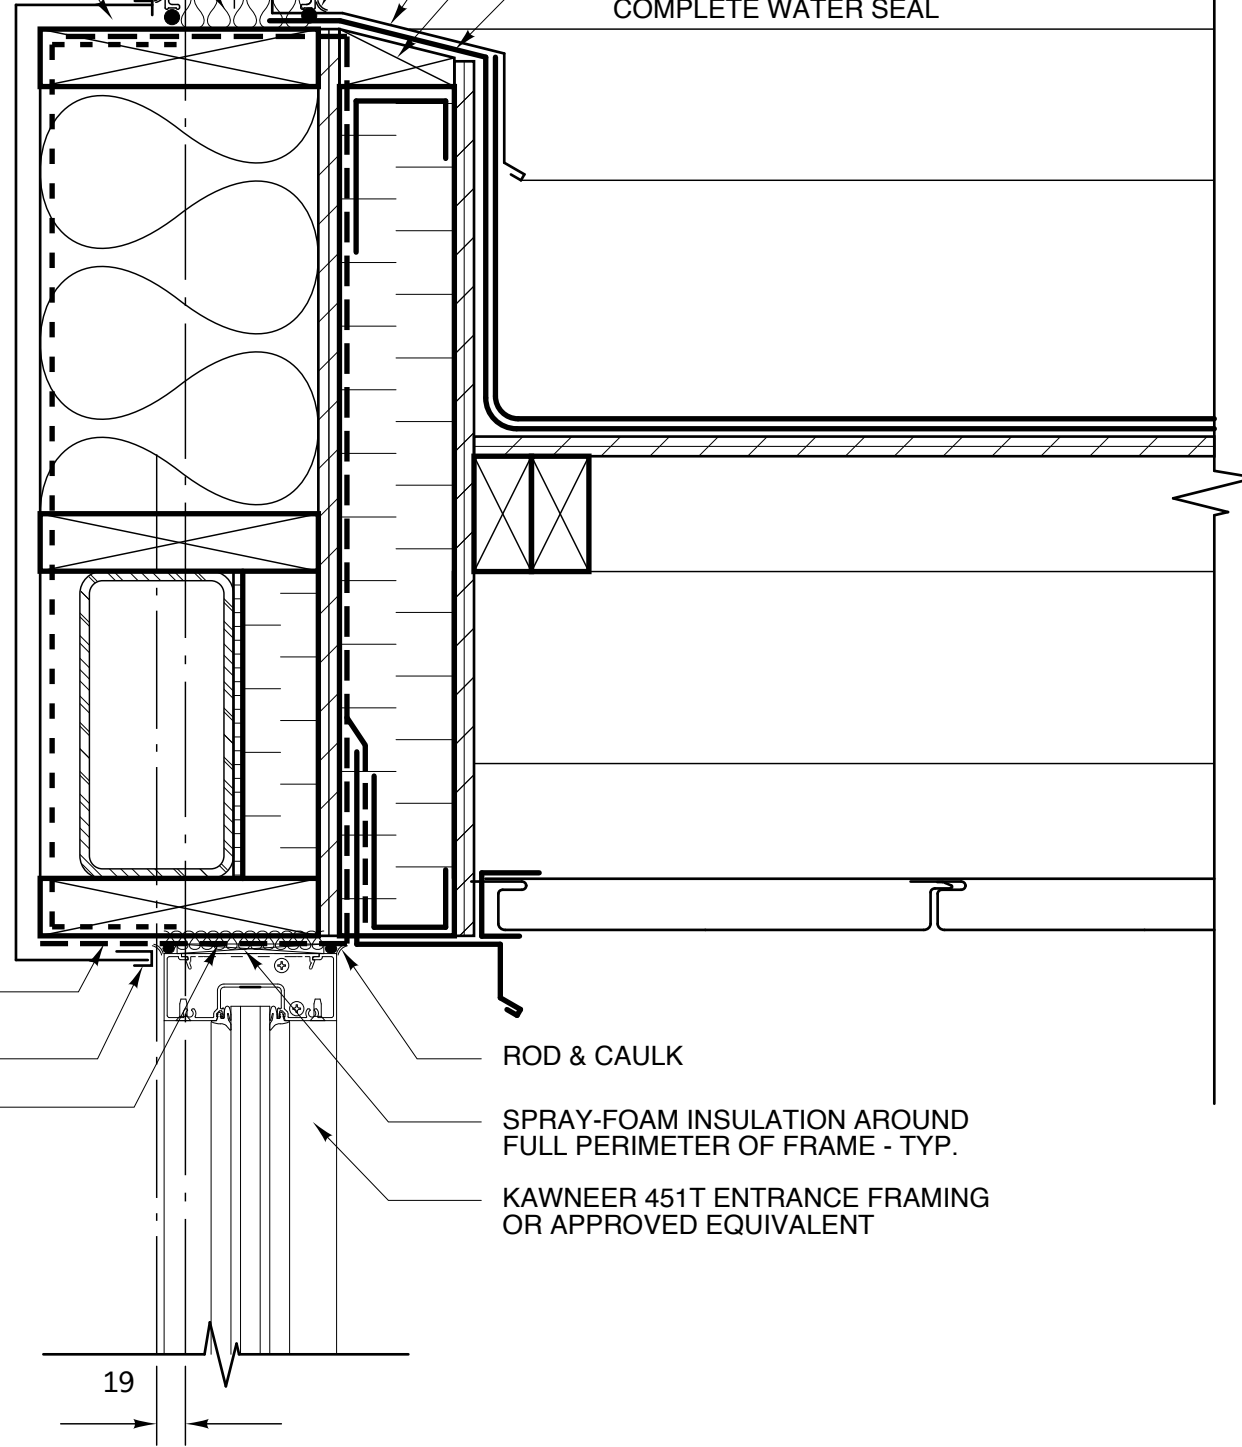

LAP AIR BARRIER AROUND OPENING - SEAL TO VAPOUR BARRIER - TYP.
RETURN GYPSUM C/W J-MOULD & CAULK - TYP.
ACHIEVE FULL SEAL FROM ALUMINUM FRAMING TO WALL AIR BARRIER - TYP.

ROD & CAULK
SPRAY-FOAM INSULATION AROUND FULL PERIMETER OF FRAME - TYP.
KAWNEER 451T ENTRANCE FRAMING OR APPROVED EQUIVALENT

1
AD03b

DELETION OF CURTAIN WALL
SCALE 1:5

19

harold funk architect inc.

Harold Funk Architect Inc.
Architecture and Urban Design

401-55 Donald Street, Winnipeg, Manitoba R3C 1L8
T (204) 943-5087 info@funkarchitect.com
F (204) 949-9231 funkarchitect.com

NOTE: THIS DRAWING IS PROVIDED FOR CLARIFICATION AND REVISION PURPOSES AND SHALL BE READ IN CONJUNCTION WITH OTHER CONSTRUCTION DOCUMENTATION. EXTRANEIOUS INFORMATION HAS BEEN REMOVED FOR CLARITY. NOTIFY THE CONTRACT ADMINISTRATOR IN THE EVENT OF QUESTIONS.

AD-03b
SINCLAIR PARK COMMUNITY CENTRE

Project # 08-011
Drawn: G.S.
Reviewed: H.F.
Date: 30th March 2010