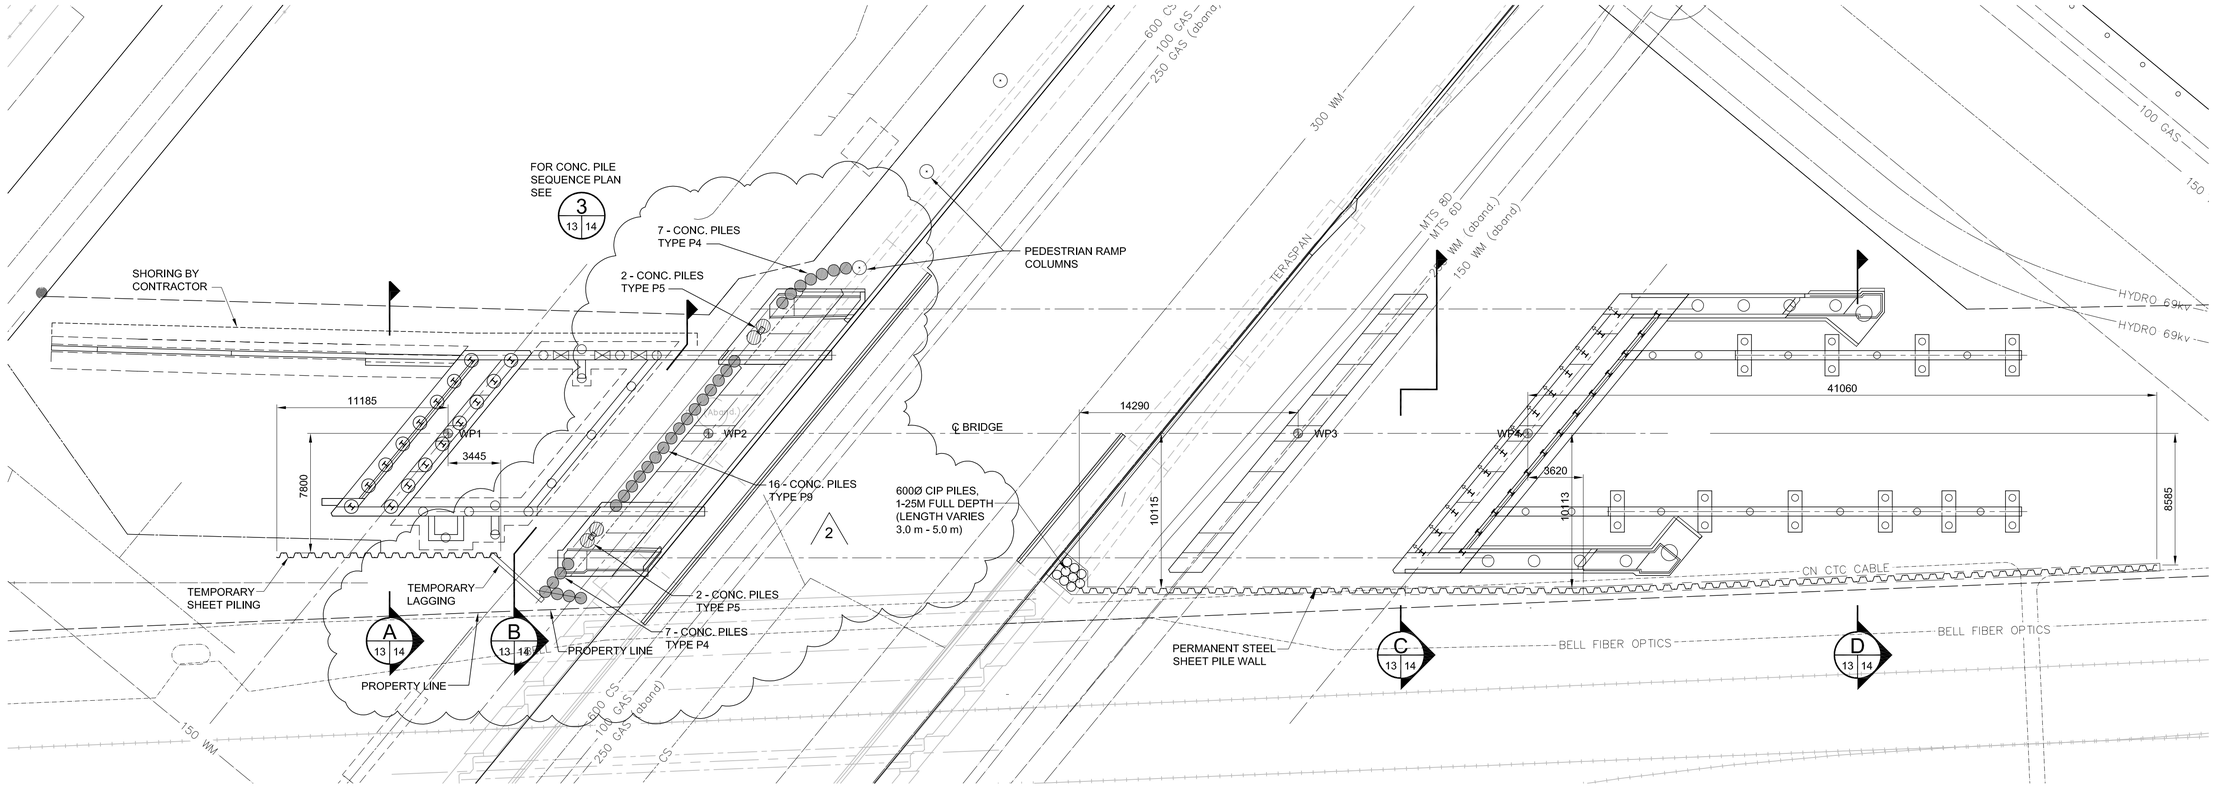

PLAN

SCALE: 1:200

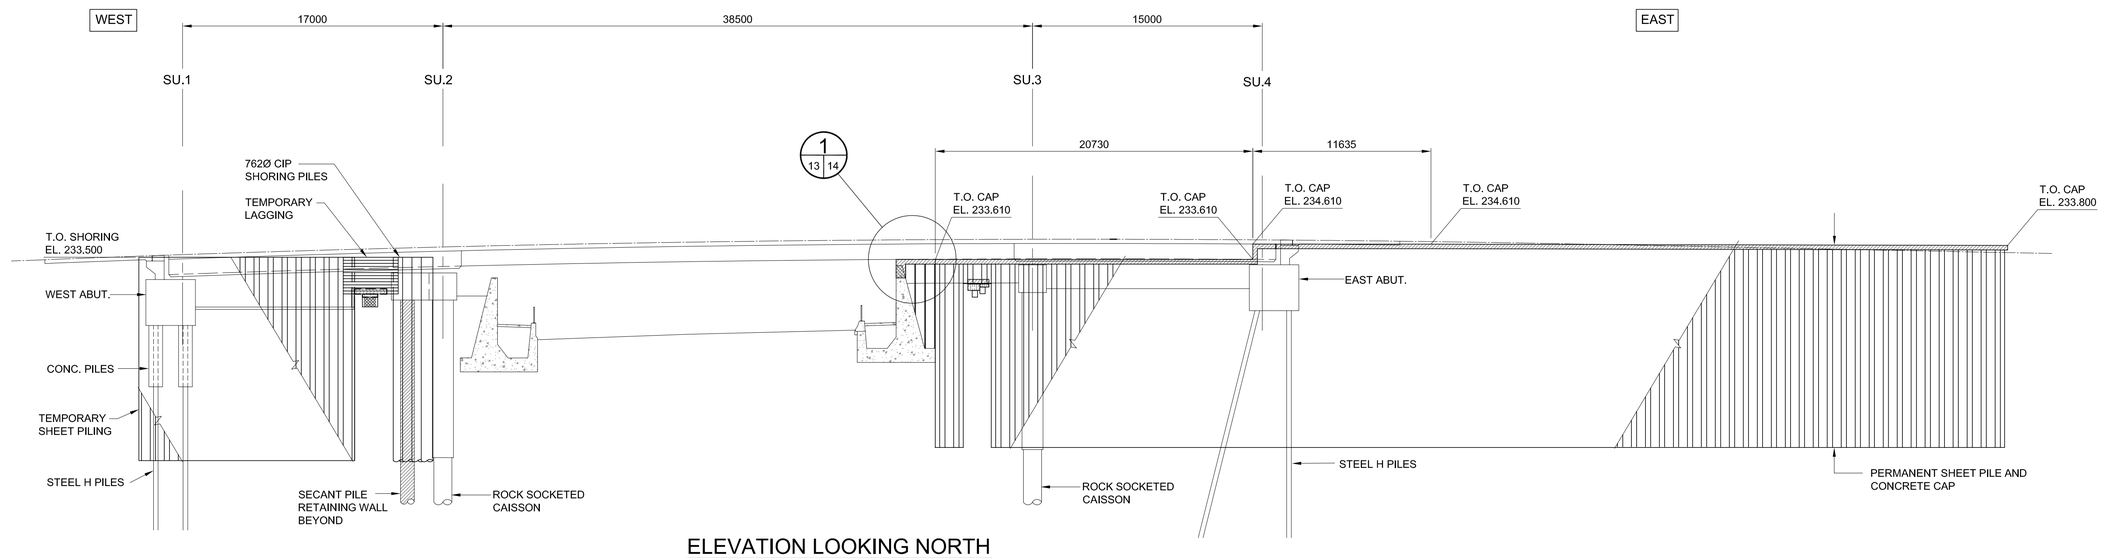

ELEVATION LOOKING NORTH

SCALE: 1:200

APEGM
Certificate of Authorization
AECOM Canada Ltd.
No. 4671 Date: 2010/05/14

DO NOT SCALE THIS DOCUMENT. ALL MEASUREMENTS MUST BE OBTAINED FROM STATED DIMENSIONS.
This drawing has been prepared for the use of AECOM's client and may not be used, reproduced or relied upon by third parties, except as agreed by AECOM and its client, as required by law or for use by governmental reviewing agencies. AECOM accepts no responsibility, and denies any liability whatsoever, to any party that modifies this drawing without AECOM's express written consent.

LOCATION UNDERGROUND STRUCTURES APPROVED

SUPV. U/G STRUCTURES COMMITTEE DATE

NOTE:
LOCATION OF UNDERGROUND STRUCTURES AS SHOWN ARE BASED ON THE BEST INFORMATION AVAILABLE, BUT NO GUARANTEE IS GIVEN THAT ALL EXISTING UTILITIES ARE SHOWN OR THAT THE GIVEN LOCATIONS ARE EXACT. CONFIRMATION OF EXISTENCE AND EXACT LOCATION OF ALL SERVICES MUST BE OBTAINED FROM THE INDIVIDUAL UTILITIES BEFORE PROCEEDING WITH CONSTRUCTION.

B.M. ELEV.

NO.	REVISIONS	DATE	BY
1	ISSUED FOR TENDER	10/05/14	KAA

DESIGNED BY FK
DRAWN BY KAA
CHECKED BY
APPROVED BY
HOR. SCALE
VERTICAL
DATE 2010/05/14

AECOM

RELEASED FOR CONSTRUCTION
ORIGINAL SIGNED BY RANDY FINGAS
DATE 2010/05/14

ENGINEER'S SEAL
PROVINCE OF MANITOBA
ORIGINAL STAMPED BY
F. A. KEMP
2010/05/14
REGISTERED ENGINEER

CONSULTANT PROJECT NO.
088813

Winnipeg

THE CITY OF WINNIPEG
TRANSIT DEPARTMENT

SOUTHWEST RAPID TRANSIT CORRIDOR - STAGE 1

OSBORNE STATION & ASSOCIATED WORKS

SHORING PLAN AND ELEVATION

CITY DRAWING NUMBER B237-10-13
SHEET 13 OF 121
CONSULTANT DRAWING NUMBER C5-S1001-T

C:_CAD_088813_Contract_Contract 5--Osborne Station\Current_Bridge_C5--S1001--SHORING PLAN.dwg