


TRUSS TYPE 'A' SECTION
SCALE 1:100

1
85 87

NOTE:
ALL FORCES ARE IN kN
ALL FORCES ARE FACTORED LOADS


NOTE:
COLUMNS & W BEAMS
ARE NOT SHOWN IN
TRUE VIEW

PROVIDE 13 Ø DRAIN HOLES
IN ALL HSS FRAMING &
IN WEB OF W690 TRUSS BOTTOM CHORD

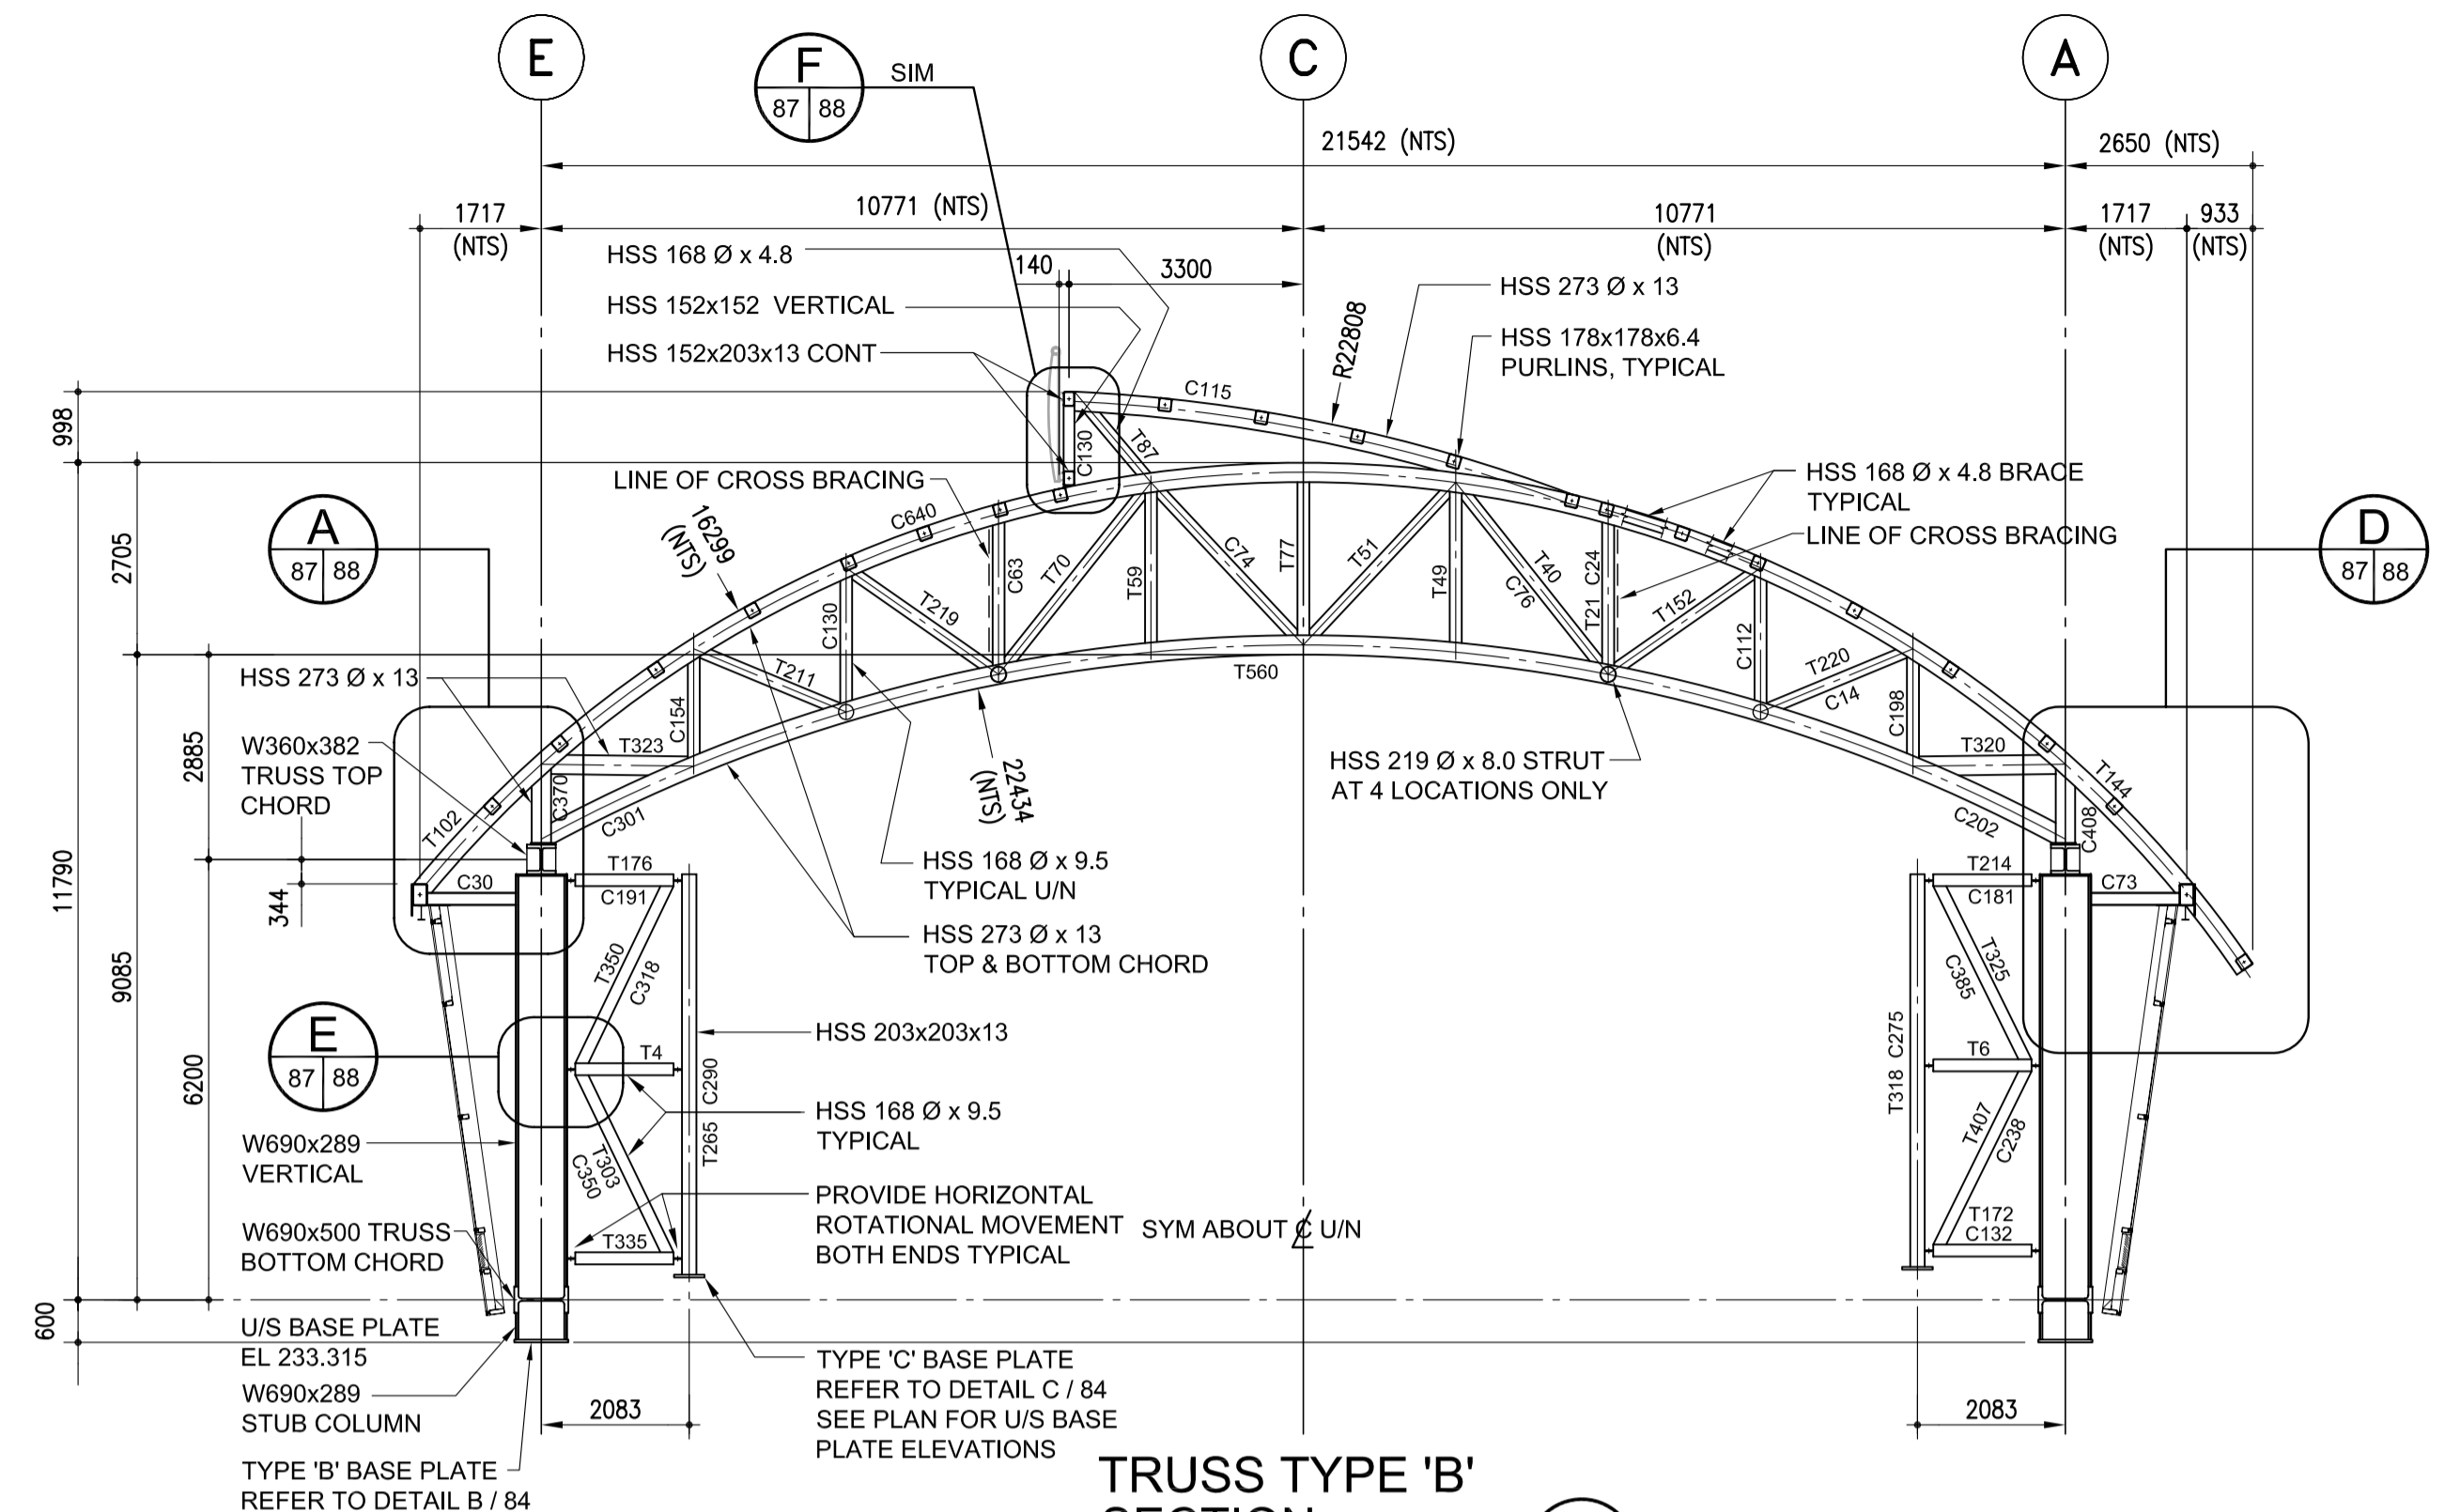


TRUSS TYPE 'B' SECTION
SCALE 1:100

2
85 87

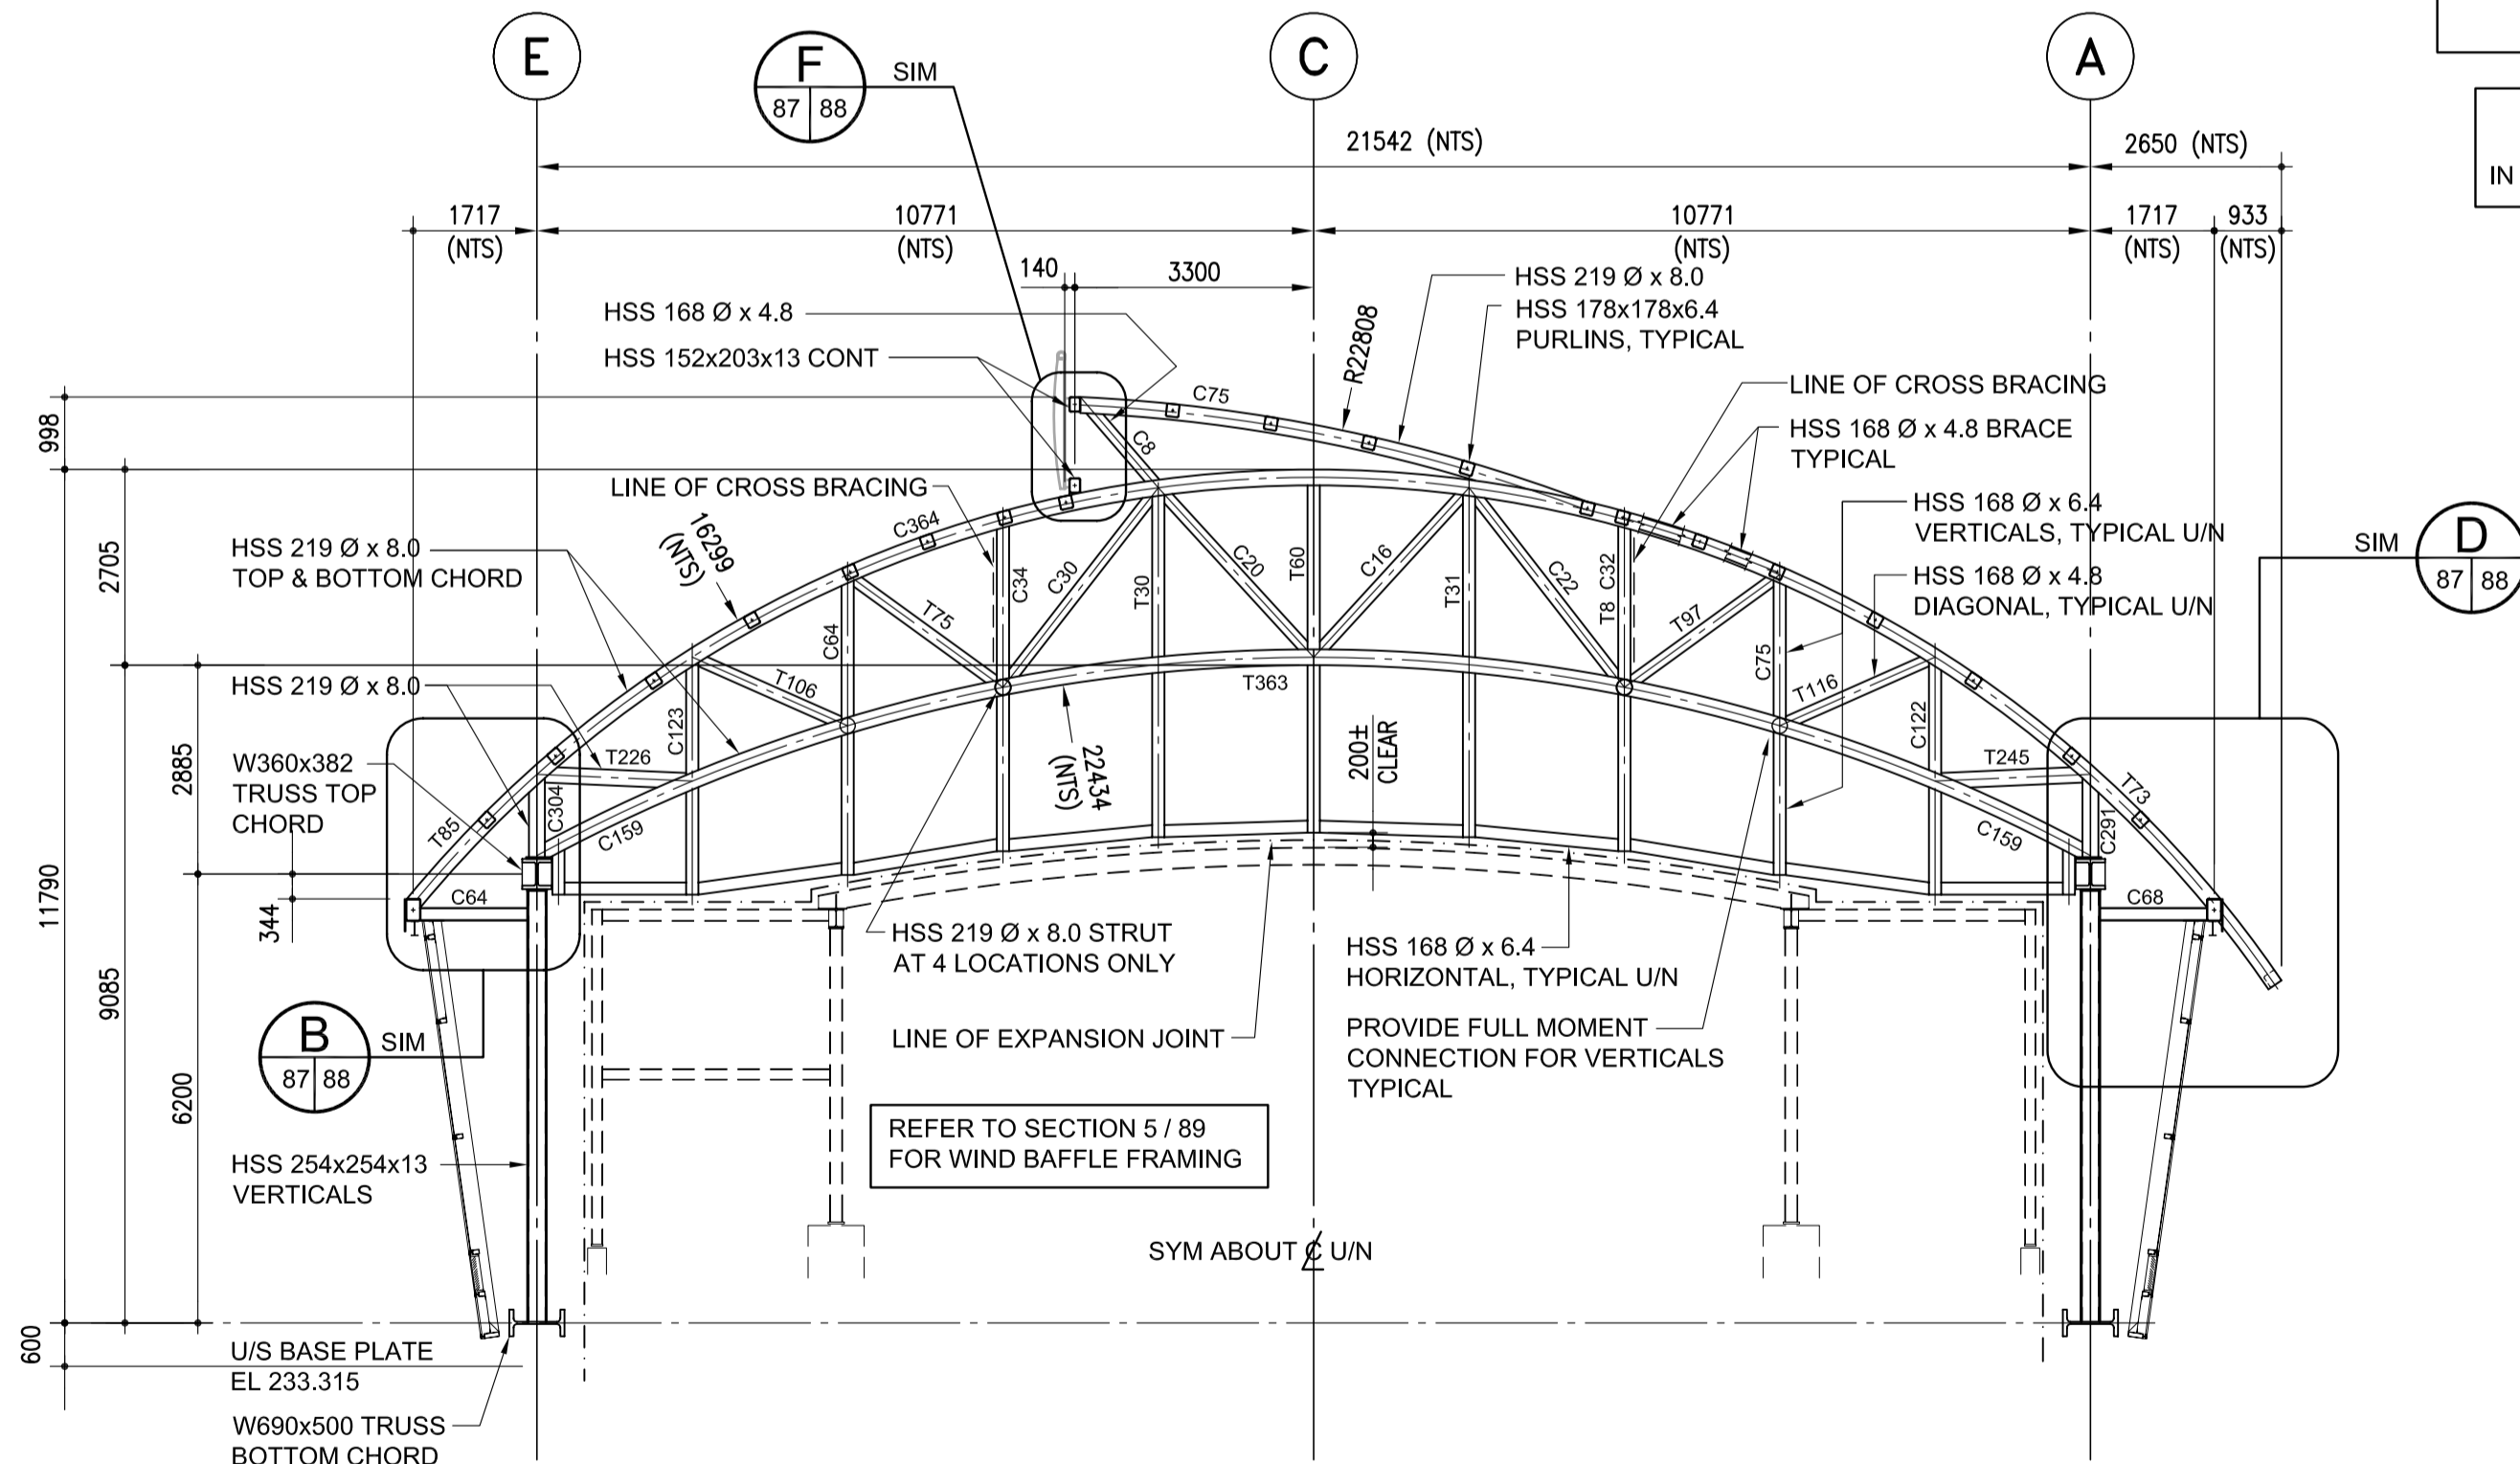

TRUSS TYPE 'C' SECTION
SCALE 1:100

3
85 87

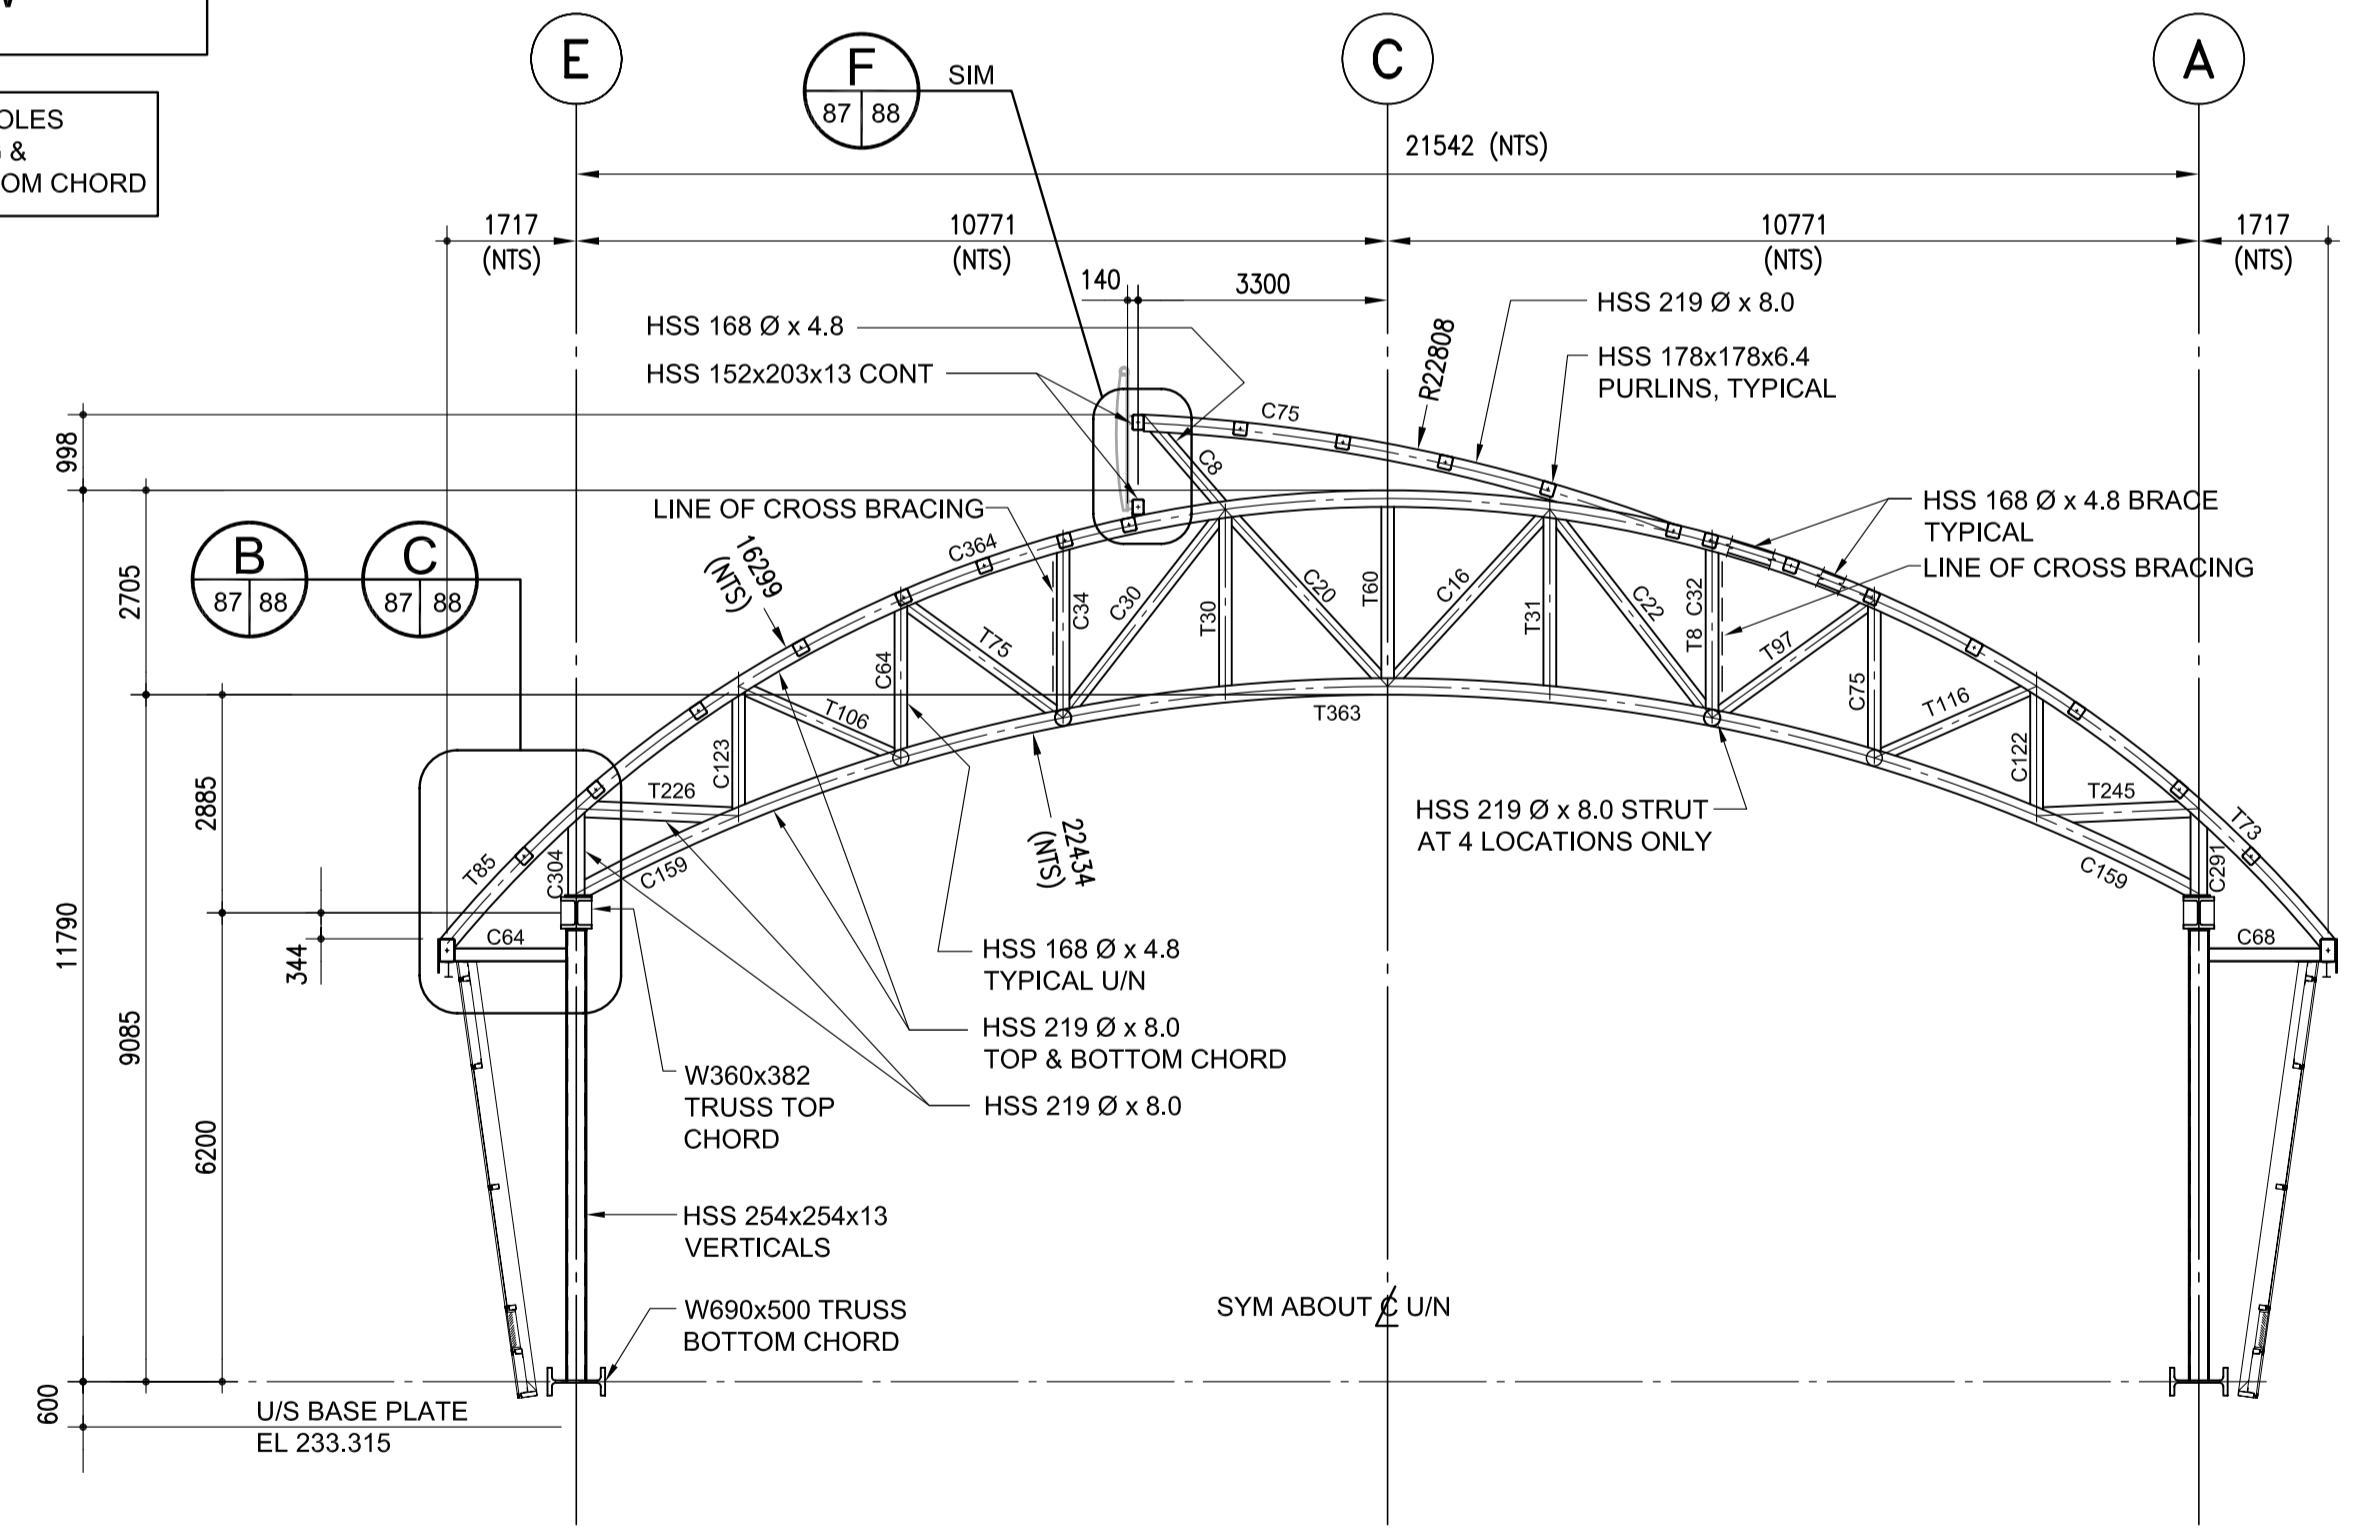

TRUSS TYPE 'D' SECTION
SCALE 1:100

4
85 87

REFER TO ADDENDUM #2 FOR
WRITTEN DESCRIPTION OF
REVISIONS MADE TO DRAWINGS.

APCGM
Certificate of Authorization
Crosier Kilgour & Partners Ltd.
No. 235 Date: May 14, 2010

Crosier Kilgour
& Partners Ltd.
CONSULTING STRUCTURAL ENGINEERS

LOCATION UNDERGROUND	APPROVED STRUCTURES	B.M. ELEV.
SUPV. U/G STRUCTURES COMMITTEE	DATE	
NOTE: LOCATION OF UNDERGROUND STRUCTURES AS SHOWN ARE BASED ON THE BEST INFORMATION AVAILABLE BUT NO GUARANTEE IS GIVEN THAT ALL EXISTING UTILITIES ARE SHOWN OR THAT THE GIVEN LOCATIONS ARE EXACT. CONFIRMATION OF EXISTENCE AND EXACT LOCATION OF ALL SERVICES MUST BE OBTAINED FROM THE INDIVIDUAL UTILITIES BEFORE PROCEEDING WITH CONSTRUCTION.		

NO.	REVISIONS	DATE	BY	DATE
2	ISSUED FOR ADDENDUM #2	10/06/11	TKM	
1	ISSUED FOR TENDER	10/05/14	TKM	

DESIGNED BY	DRAWN BY	CHECKED BY	APPROVED BY
BMN / TKM	CL	BMN / TKM	

DILLON CONSULTING

RELEASED FOR CONSTRUCTION
ORIGINAL SIGNED BY RANDY FINGAS
DATE 2010/05/14

ENGINEER'S SEAL
PROVINCE OF MANITOBA
ORIGINAL STAMPED BY
T.K. MALKIEWICZ
2010/05/14
REGISTERED PROFESSIONAL ENGINEER

CONSULTANT PROJECT NO.
088813

THE CITY OF WINNIPEG
TRANSIT DEPARTMENT

Winnipeg

SOUTHWEST RAPID TRANSIT CORRIDOR - STAGE 1
OSBORNE STATION & ASSOCIATED WORKS

CITY DRAWING NUMBER
B237-10-87

SHEET 87 OF 121

CONSULTANT DRAWING NUMBER
C5-S2103-T

SECTIONS