



ADDRESS: 989 SARGENT AV. PROJECT No: 557-2010 DESCRIPTION: SECOND FLOOR PLAN-CONSTRUCTION DATE: July 2010 FILE NAME: CINDY KLASSEN RENOVATION.DWG

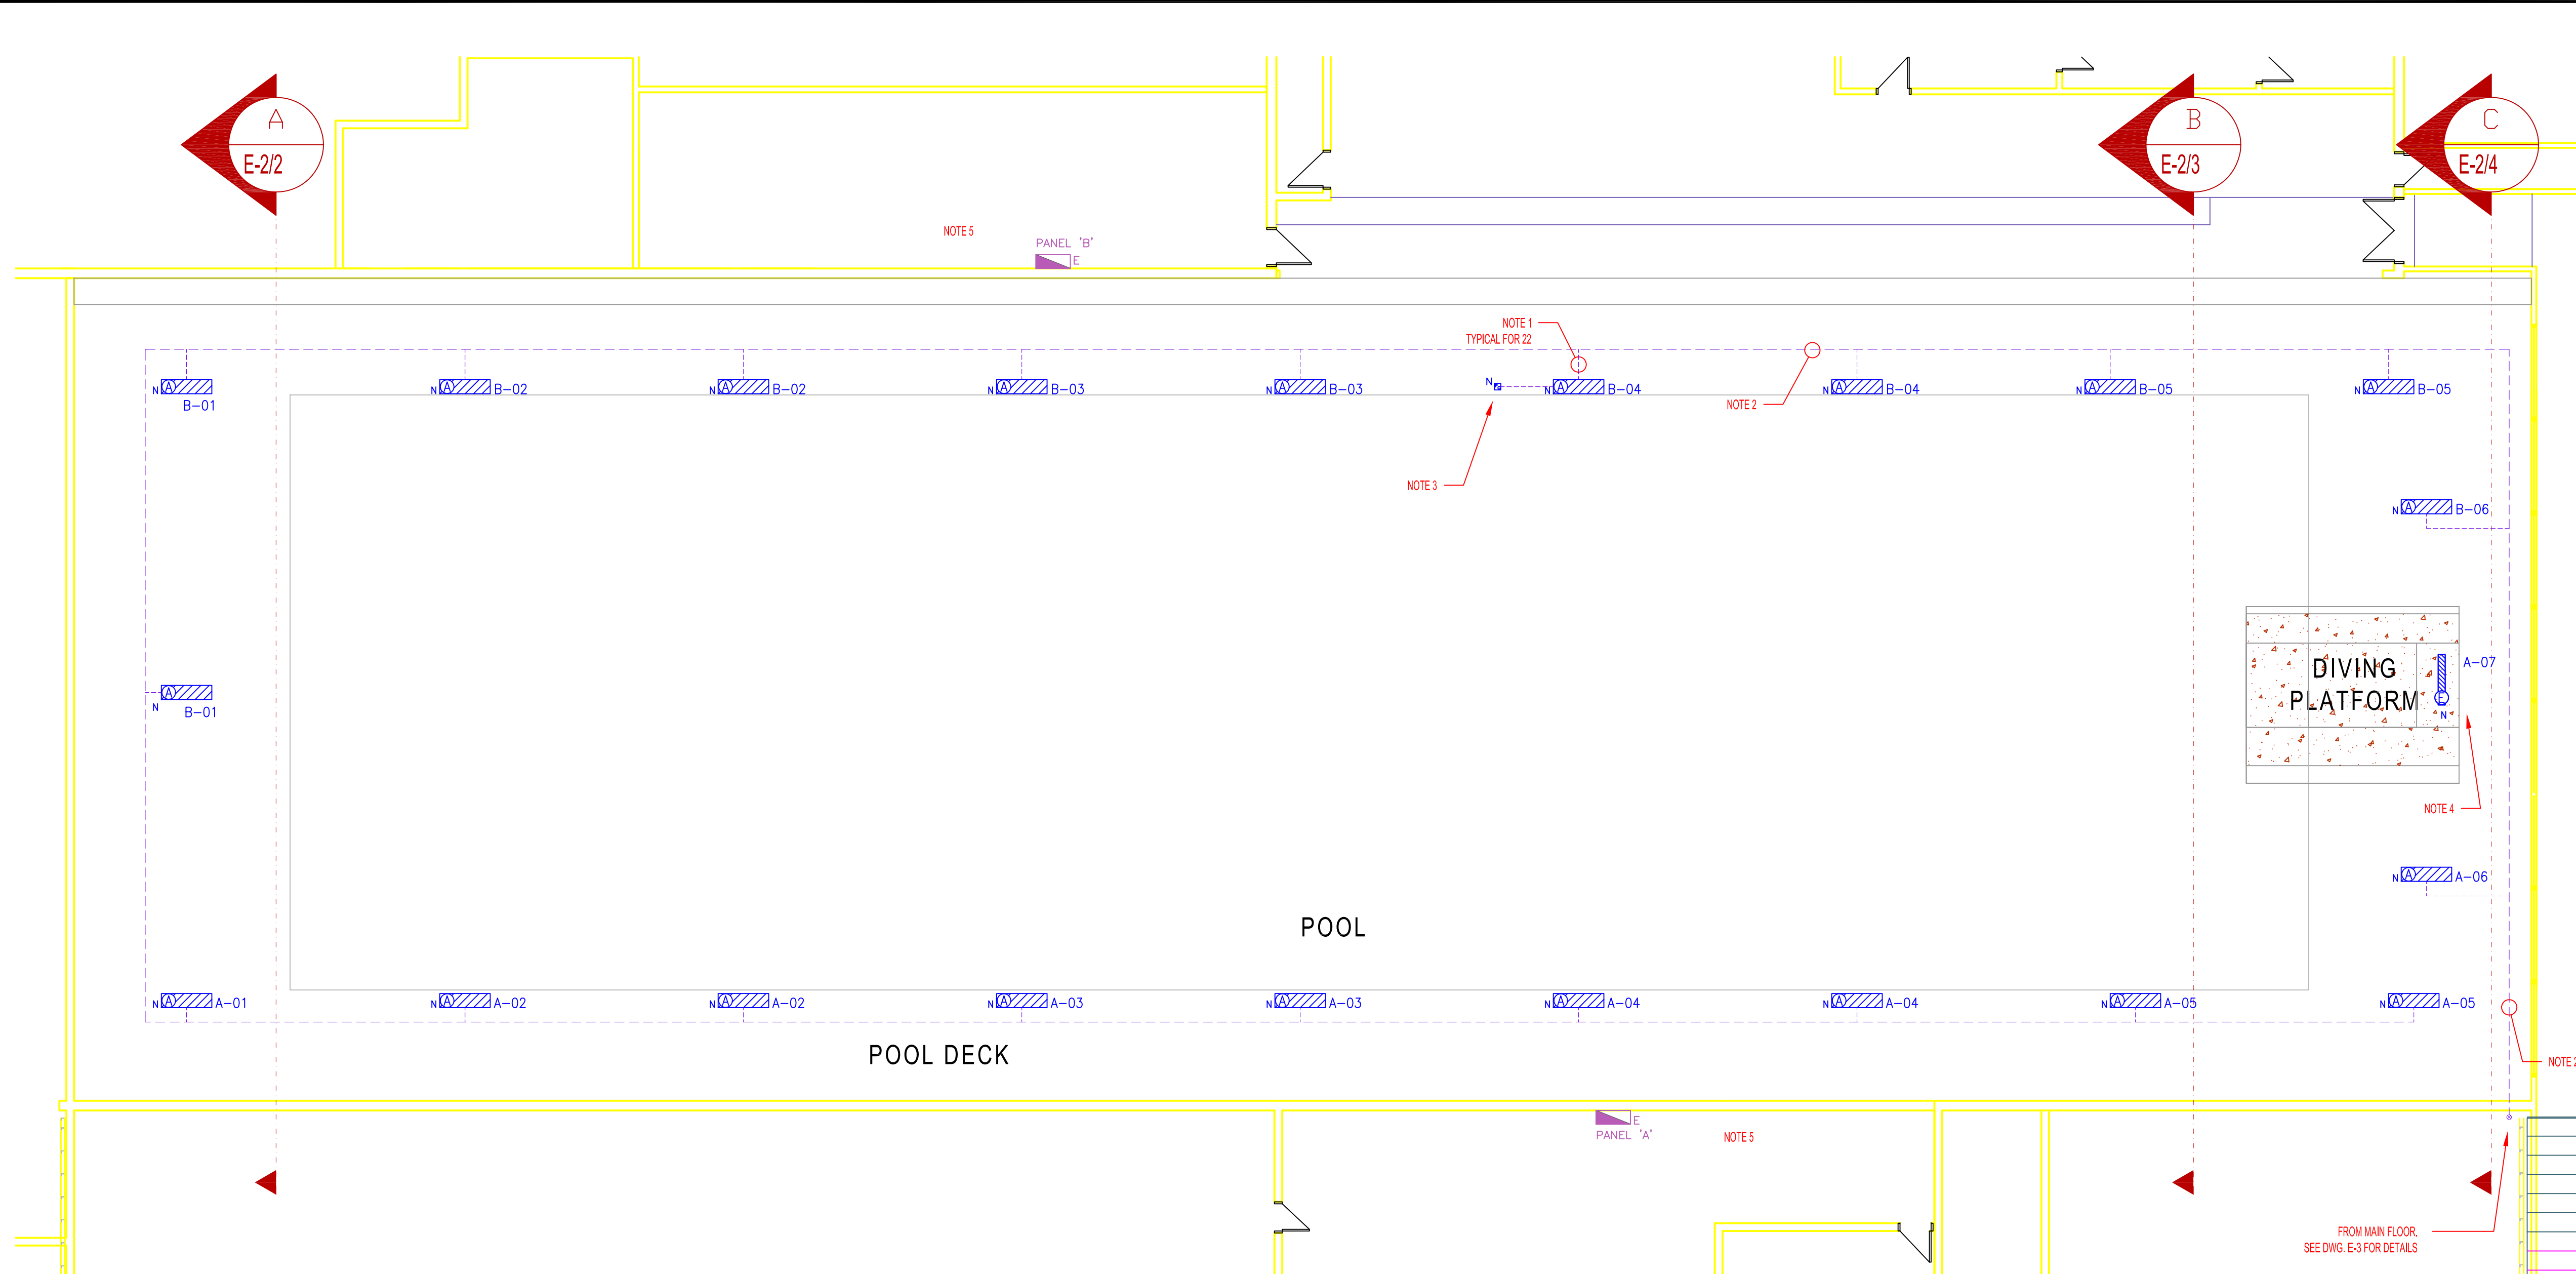


- NOTES:
1. ECOSYSTEM LINK LUTRON CABLE:
C-CBL-216-GR-1 (2 #16 CONDUCTOR NON-PLENUM) OR APPROVED EQUAL IN ACCORDANCE WITH B6,
 2. ECOSYSTEM LINK LUTRON CABLE:
C-CBL-216-GR-1 (2 #16 CONDUCTOR NON-PLENUM) OR APPROVED EQUAL IN ACCORDANCE WITH B6, IN CONDUIT 16mm.
 3. PHOTOCELL IN TRANSPARENT ACRYLIC ENCLOSURE, SEE DWG-E-4 FOR DETAILS. CONFIRM MOUNTING LOCATION WITH CONTRACT ADMINISTRATOR PRIOR TO INSTALL.
 4. PLATFORM-CEILING MOUNTED LUMINAIRE AT 2m HEIGHT. LUMINAIRE AT 100% OUTPUT FOR 24h PER DAY.
 5. WIRING FOR POWER:
 - 5.1. WIRE SIZE SHALL BE MINIMUM #12 RW90Cu
 - 5.2. ALL WIRING TO BE RUN IN CONDUIT.


1 SECOND FLOOR ELECTRICAL LAYOUT
E-2 SCALE: 1:100

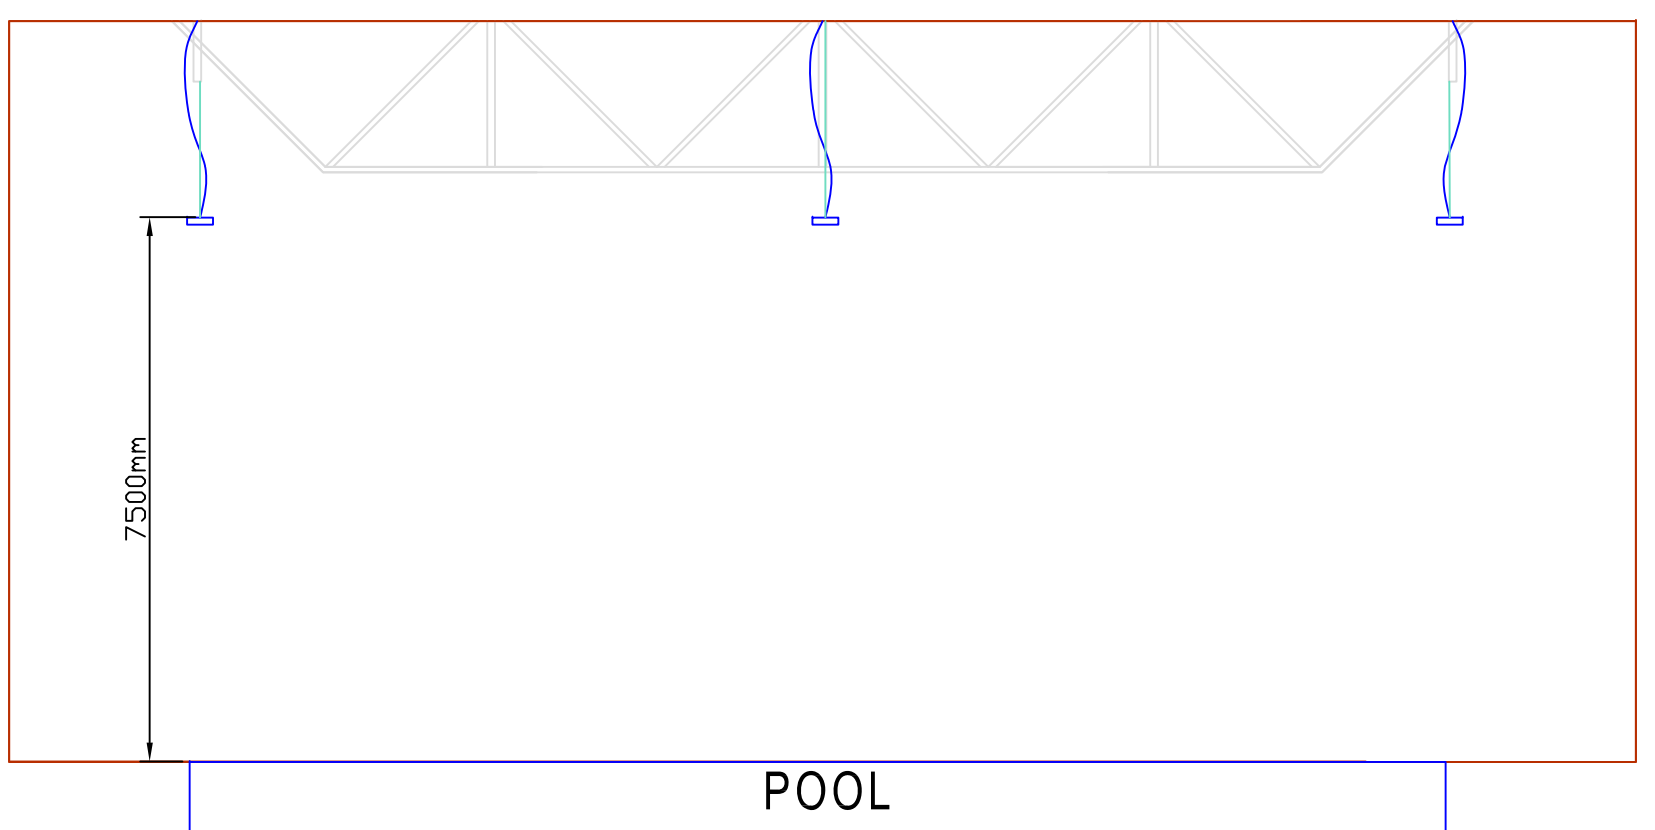

2 DETAIL A
E-2 SCALE: 1:100

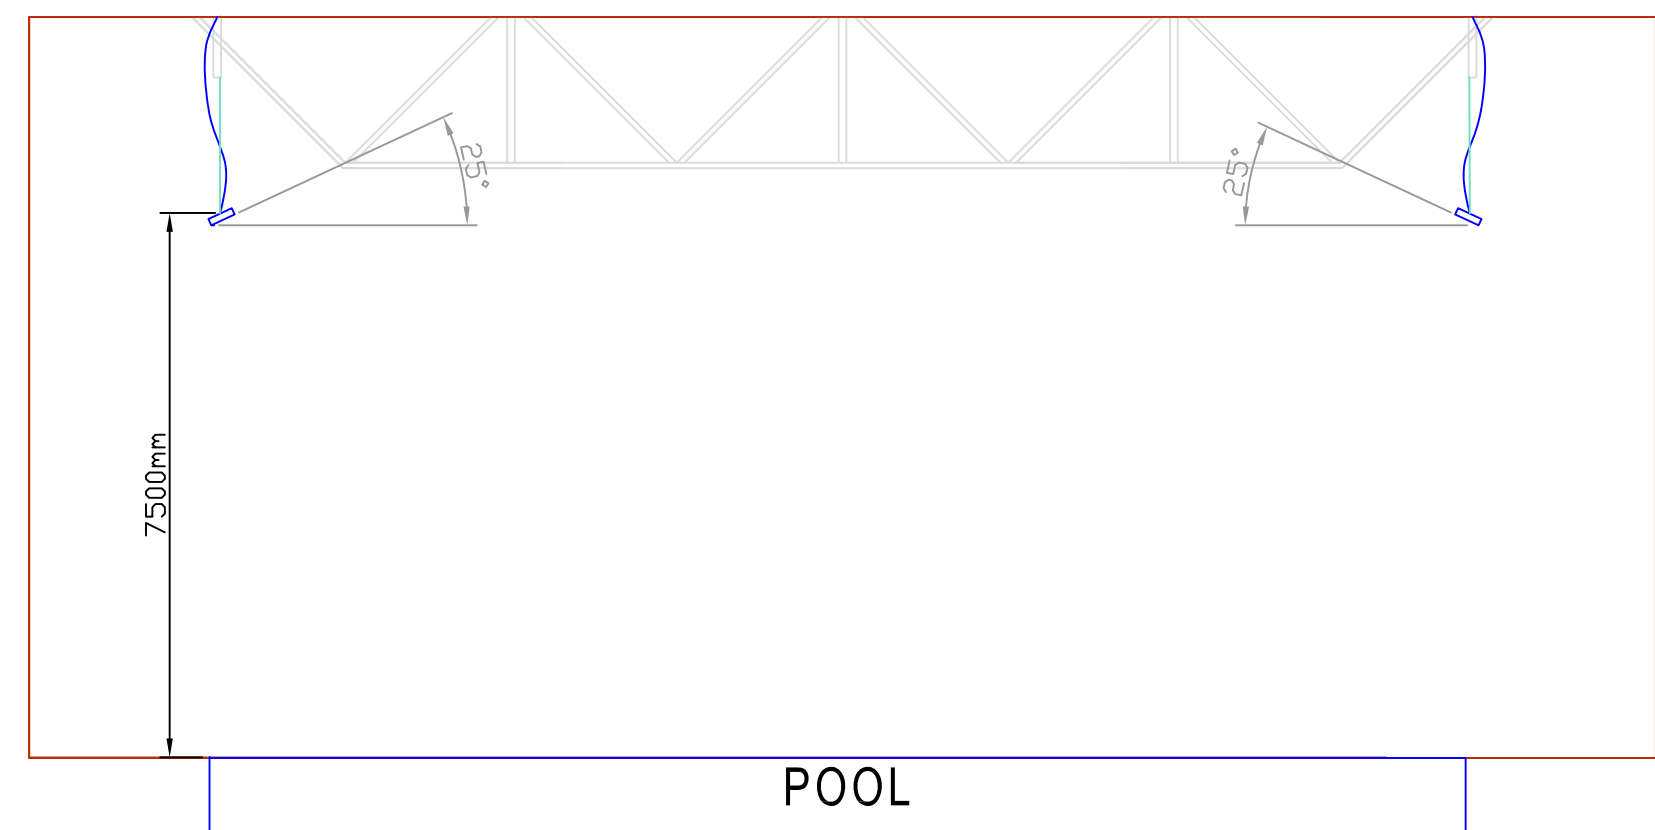

3 DETAIL B
E-2 SCALE: 1:100

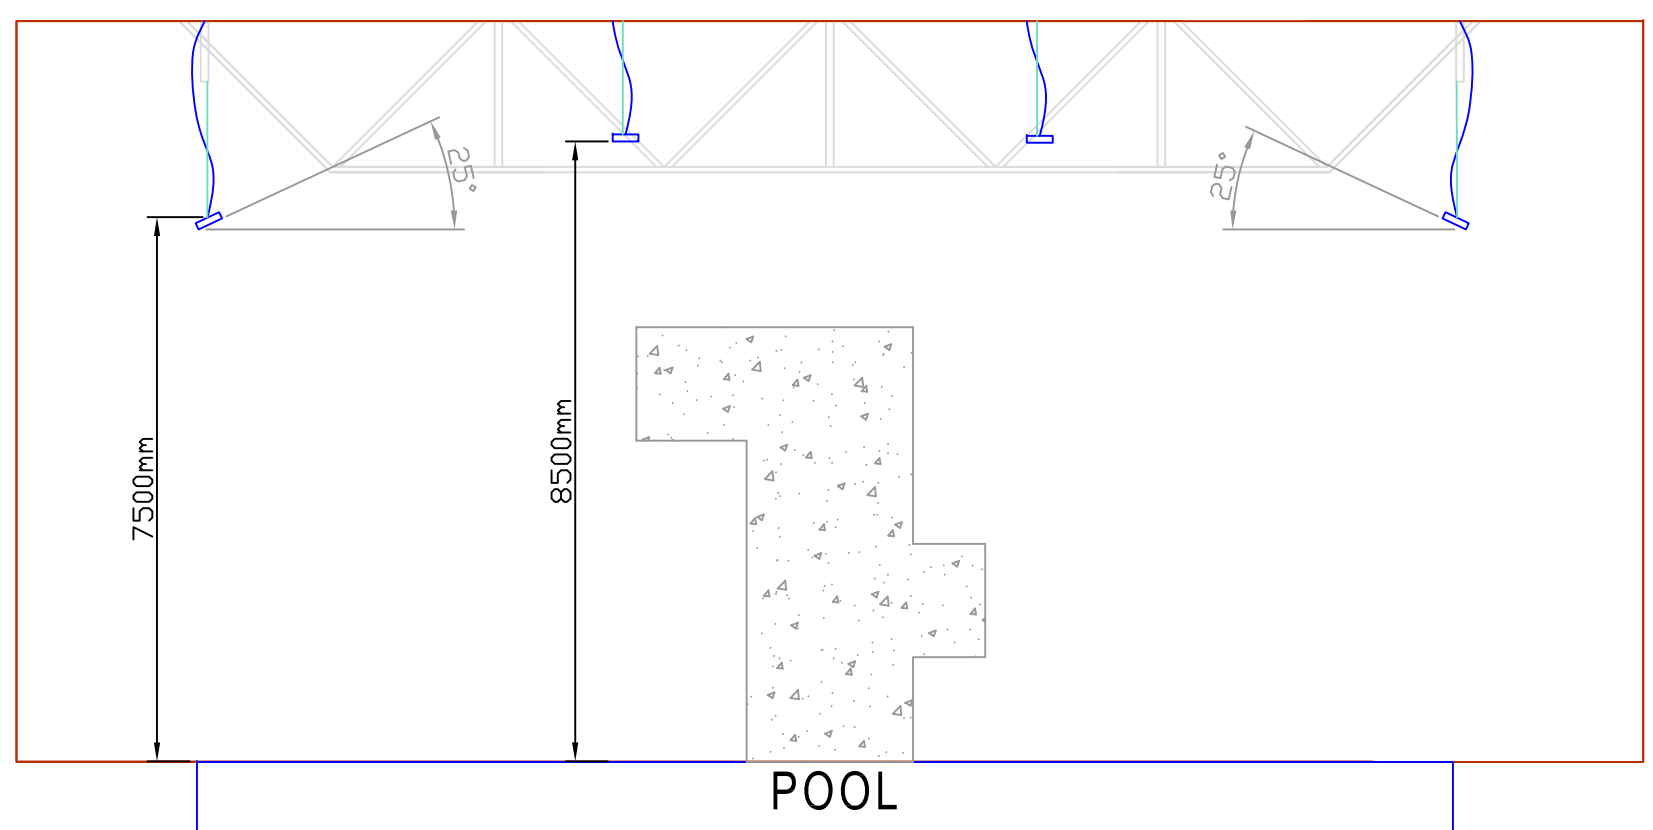

4 DETAIL C
E-2 SCALE: 1:100

NO.	REVISION/DESCRIPTION	BY	DATE
SEALS			
R-01	CHANGES IN LUMINAIRE LOCATION, POWER FEEDING LUMINAIRE AND NOTE 4	vc	7/27/2010

DRAWN BY	VC	CHECKED BY	APPROVED	DATE
				July 2010

CITY OF WINNIPEG
PLANNING, PROPERTY AND DEVELOPMENT DEPARTMENT
Municipal Accommodations Division
185 King St Winnipeg, MB R3B 1J1

PROJECT
CINDY KLASSEN POOL
REPLACE LIGHTING ON POOL DECK

989 SARGENT AV.
SHEET TITLE
SECOND FLOOR PLAN
CONSTRUCTION

SCALE	PROJECT NO.	SHEET NO.
1:100	557-2010	E-2

DRAWING SHEET SIZE: A1 (841mm x 594mm) PLOT 1:1