



MAIN STREET

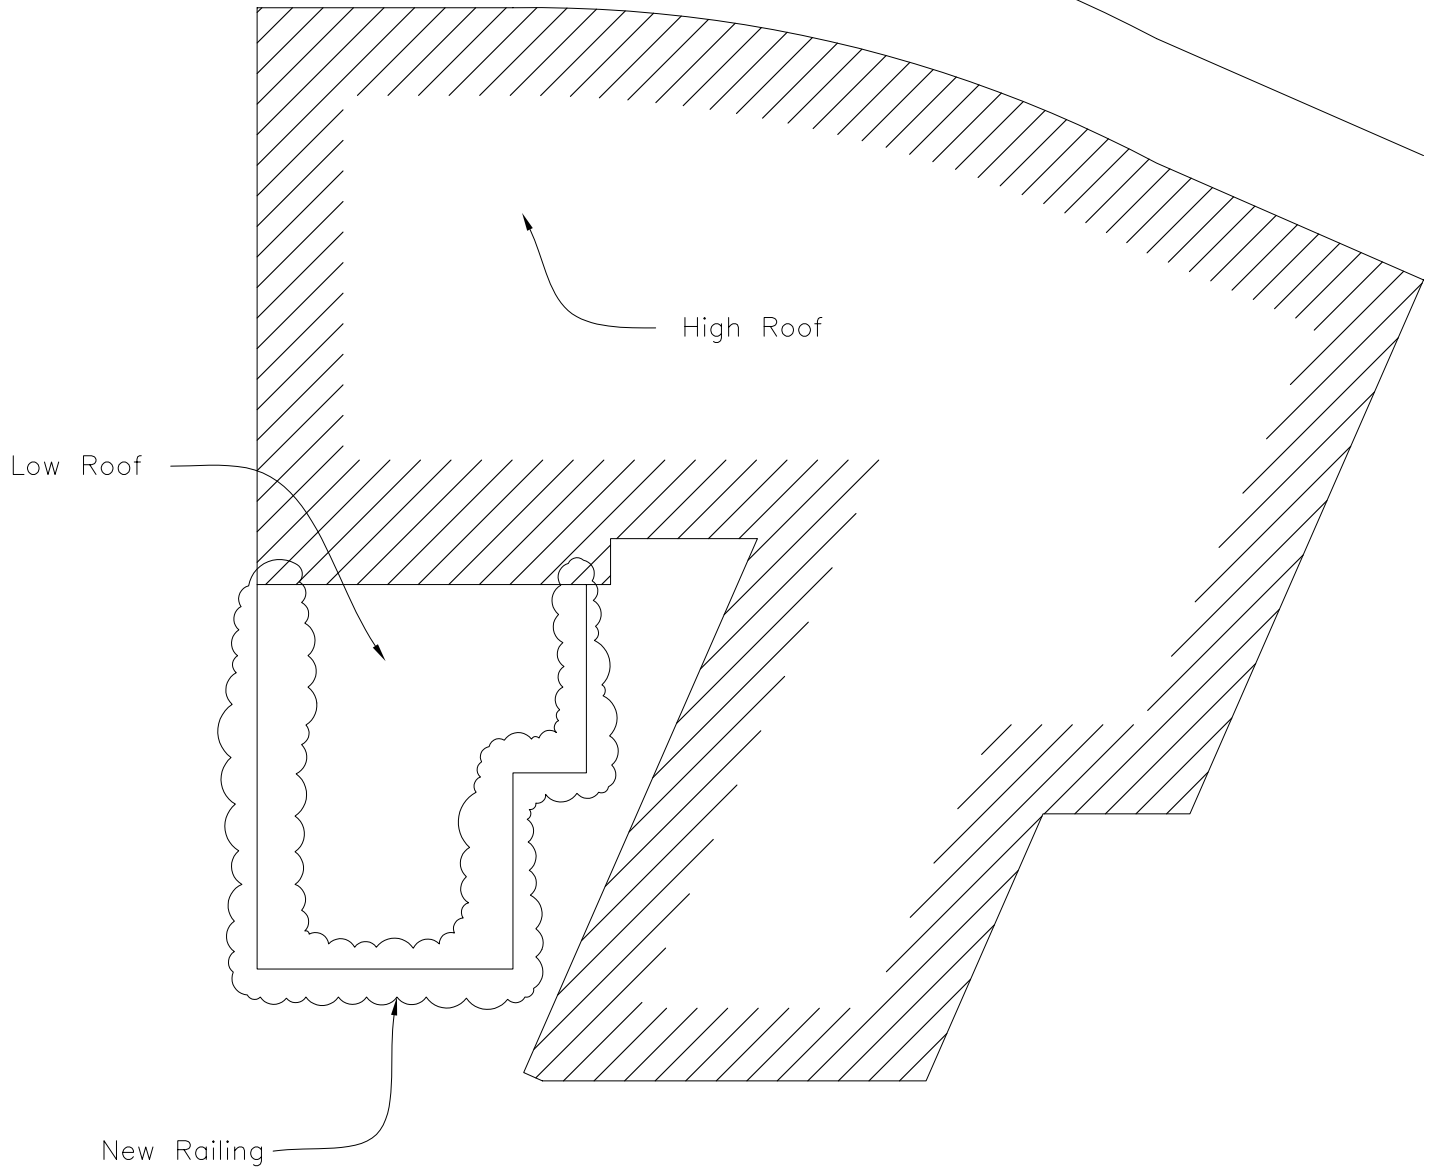

Roof Plan
NTS

SK-1

New Handrail on Low Roof
Confederation Building
457 Main Street
Winnipeg MB R3B 1B5

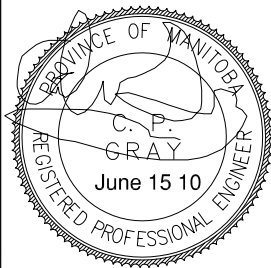

GC ENGINEERING LTD.
675 ELM ST.
WINNIPEG MB R3M 3N8
PH 793-3948 FAX 487-4616
EMAIL CALGRAY@MTS.NET