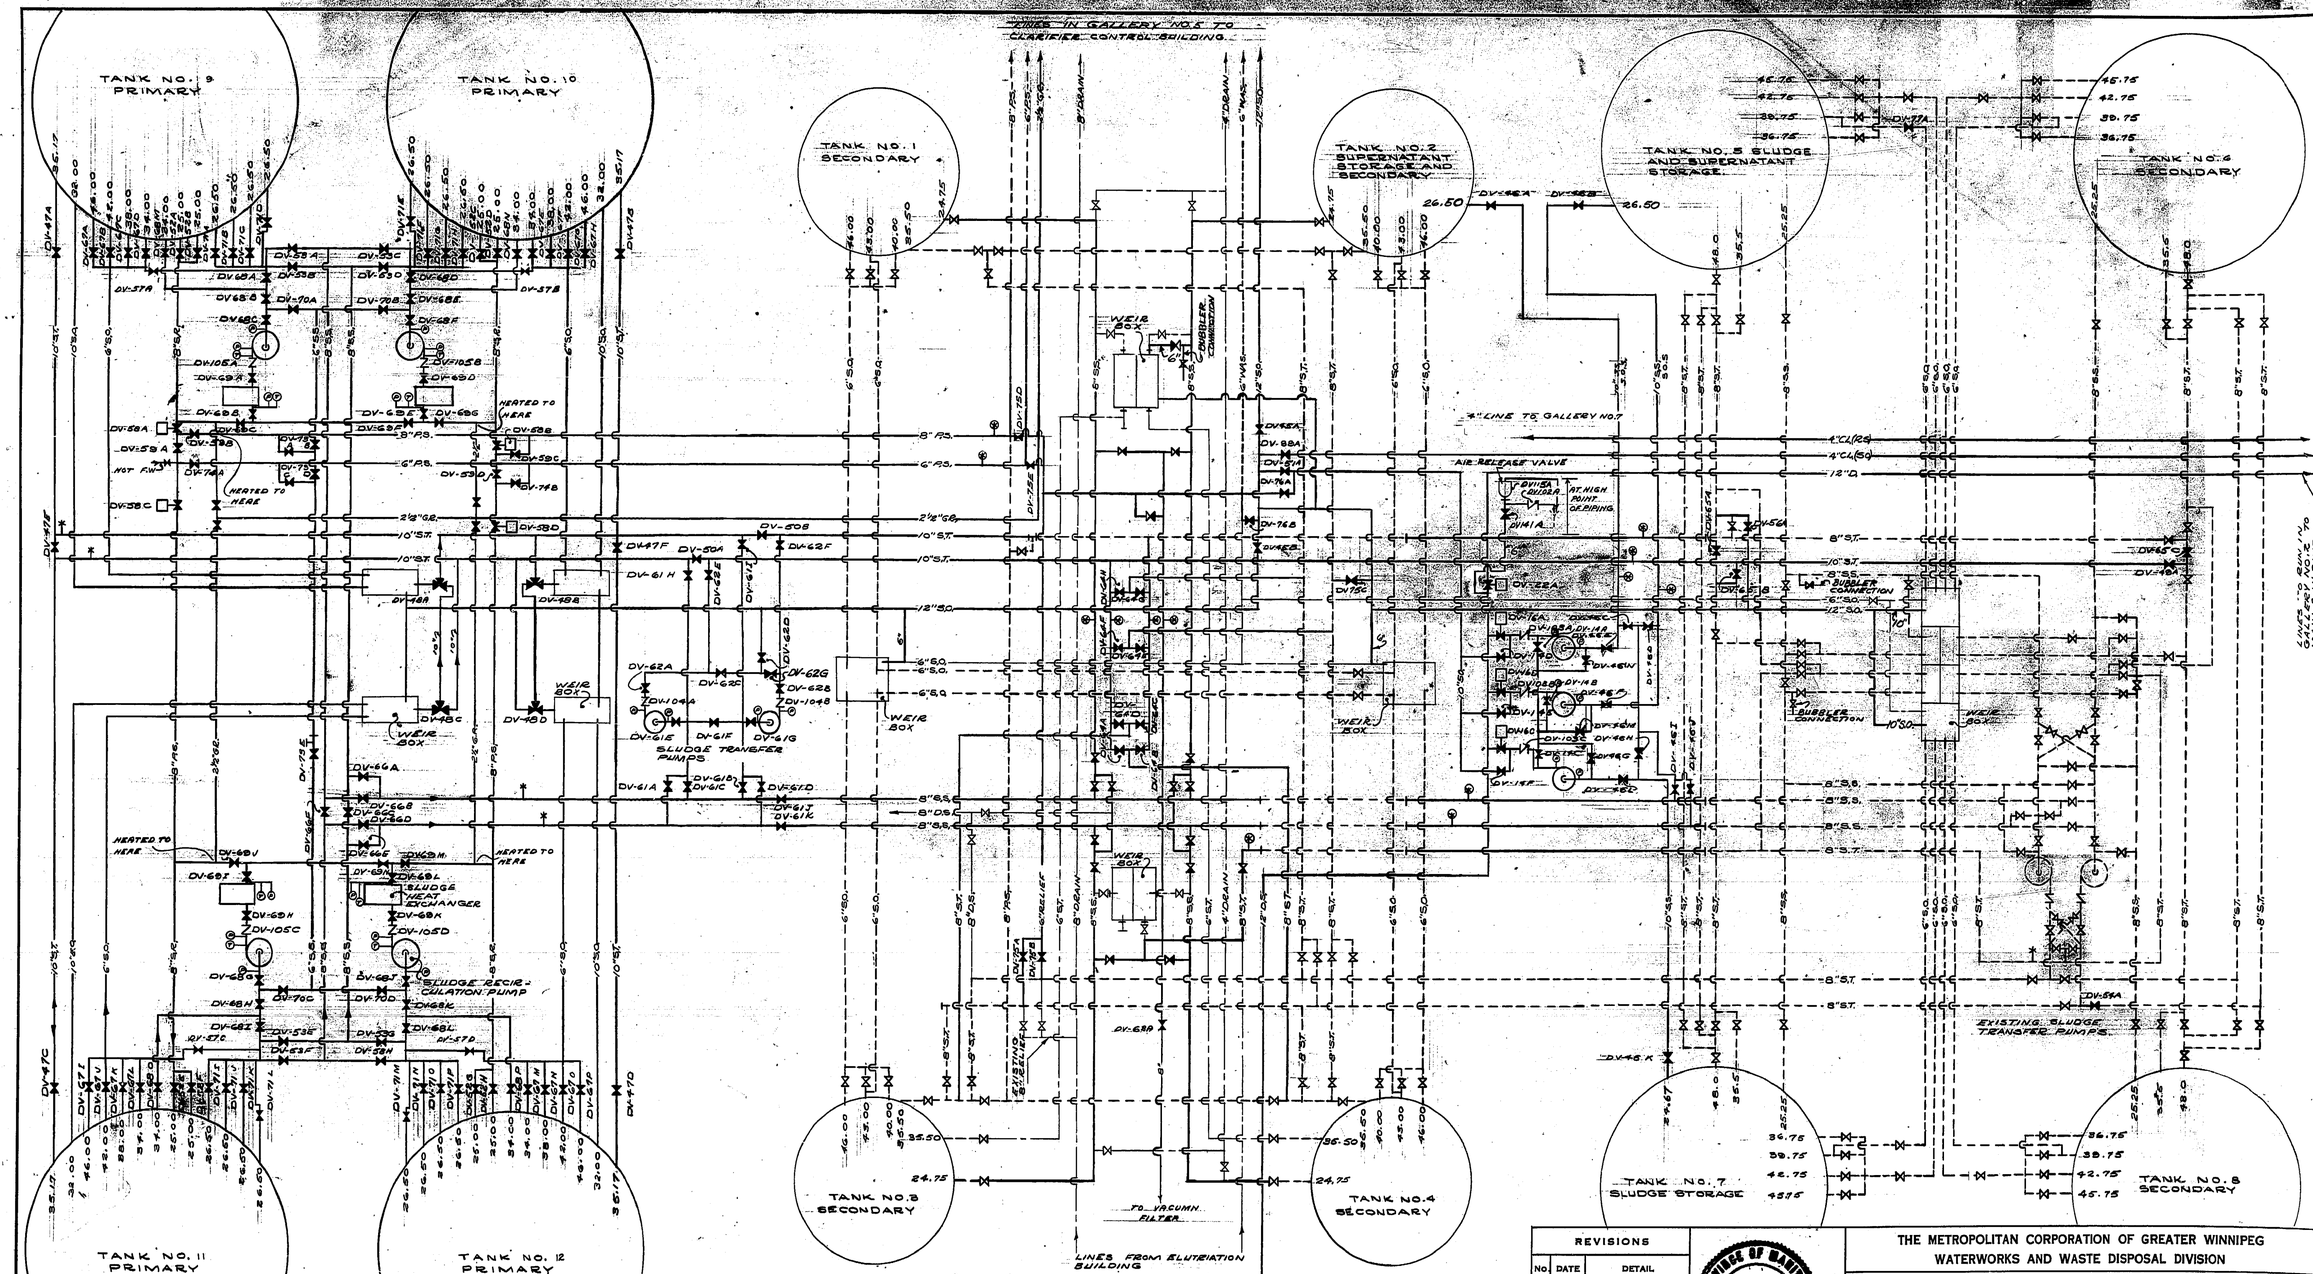

REVISIONS		
No.	DATE	DETAIL

AS BUILT

PROVINCE OF MANITOBA J. W. MacLAREN REGISTERED ENGINEER

PROVINCE OF MANITOBA J. L. GREER REGISTERED ENGINEER

THE METROPOLITAN CORPORATION OF GREATER WINNIPEG
WATERWORKS AND WASTE DISPOSAL DIVISION

NORTH END SEWAGE TREATMENT PLANT

CONTRACT A - DIGESTION GALLERIES MECHANICAL SLUDGE FLOW DIAGRAM

JAMES F. MacLAREN LIMITED ENGINEERS TORONTO

W.L. WARDROP ASSOCIATES (MANAGEMENT) LIMITED ENGINEERING CONSULTANTS WINNIPEG

APPROVED
ENGINEER OF DESIGN
ENGINEER OF WASTE DISPOSAL
DIRECTOR & CHIEF ENGINEER

DATE	SCALE	DWG. No.	
MARCH 11, 1963	N.T.S.	123 OF 217	NEP-123

FILE 530-D-4661

REF. OF DRAWING No. NEP-123

DETAILS

HUGHES & CO. SINCE 1900