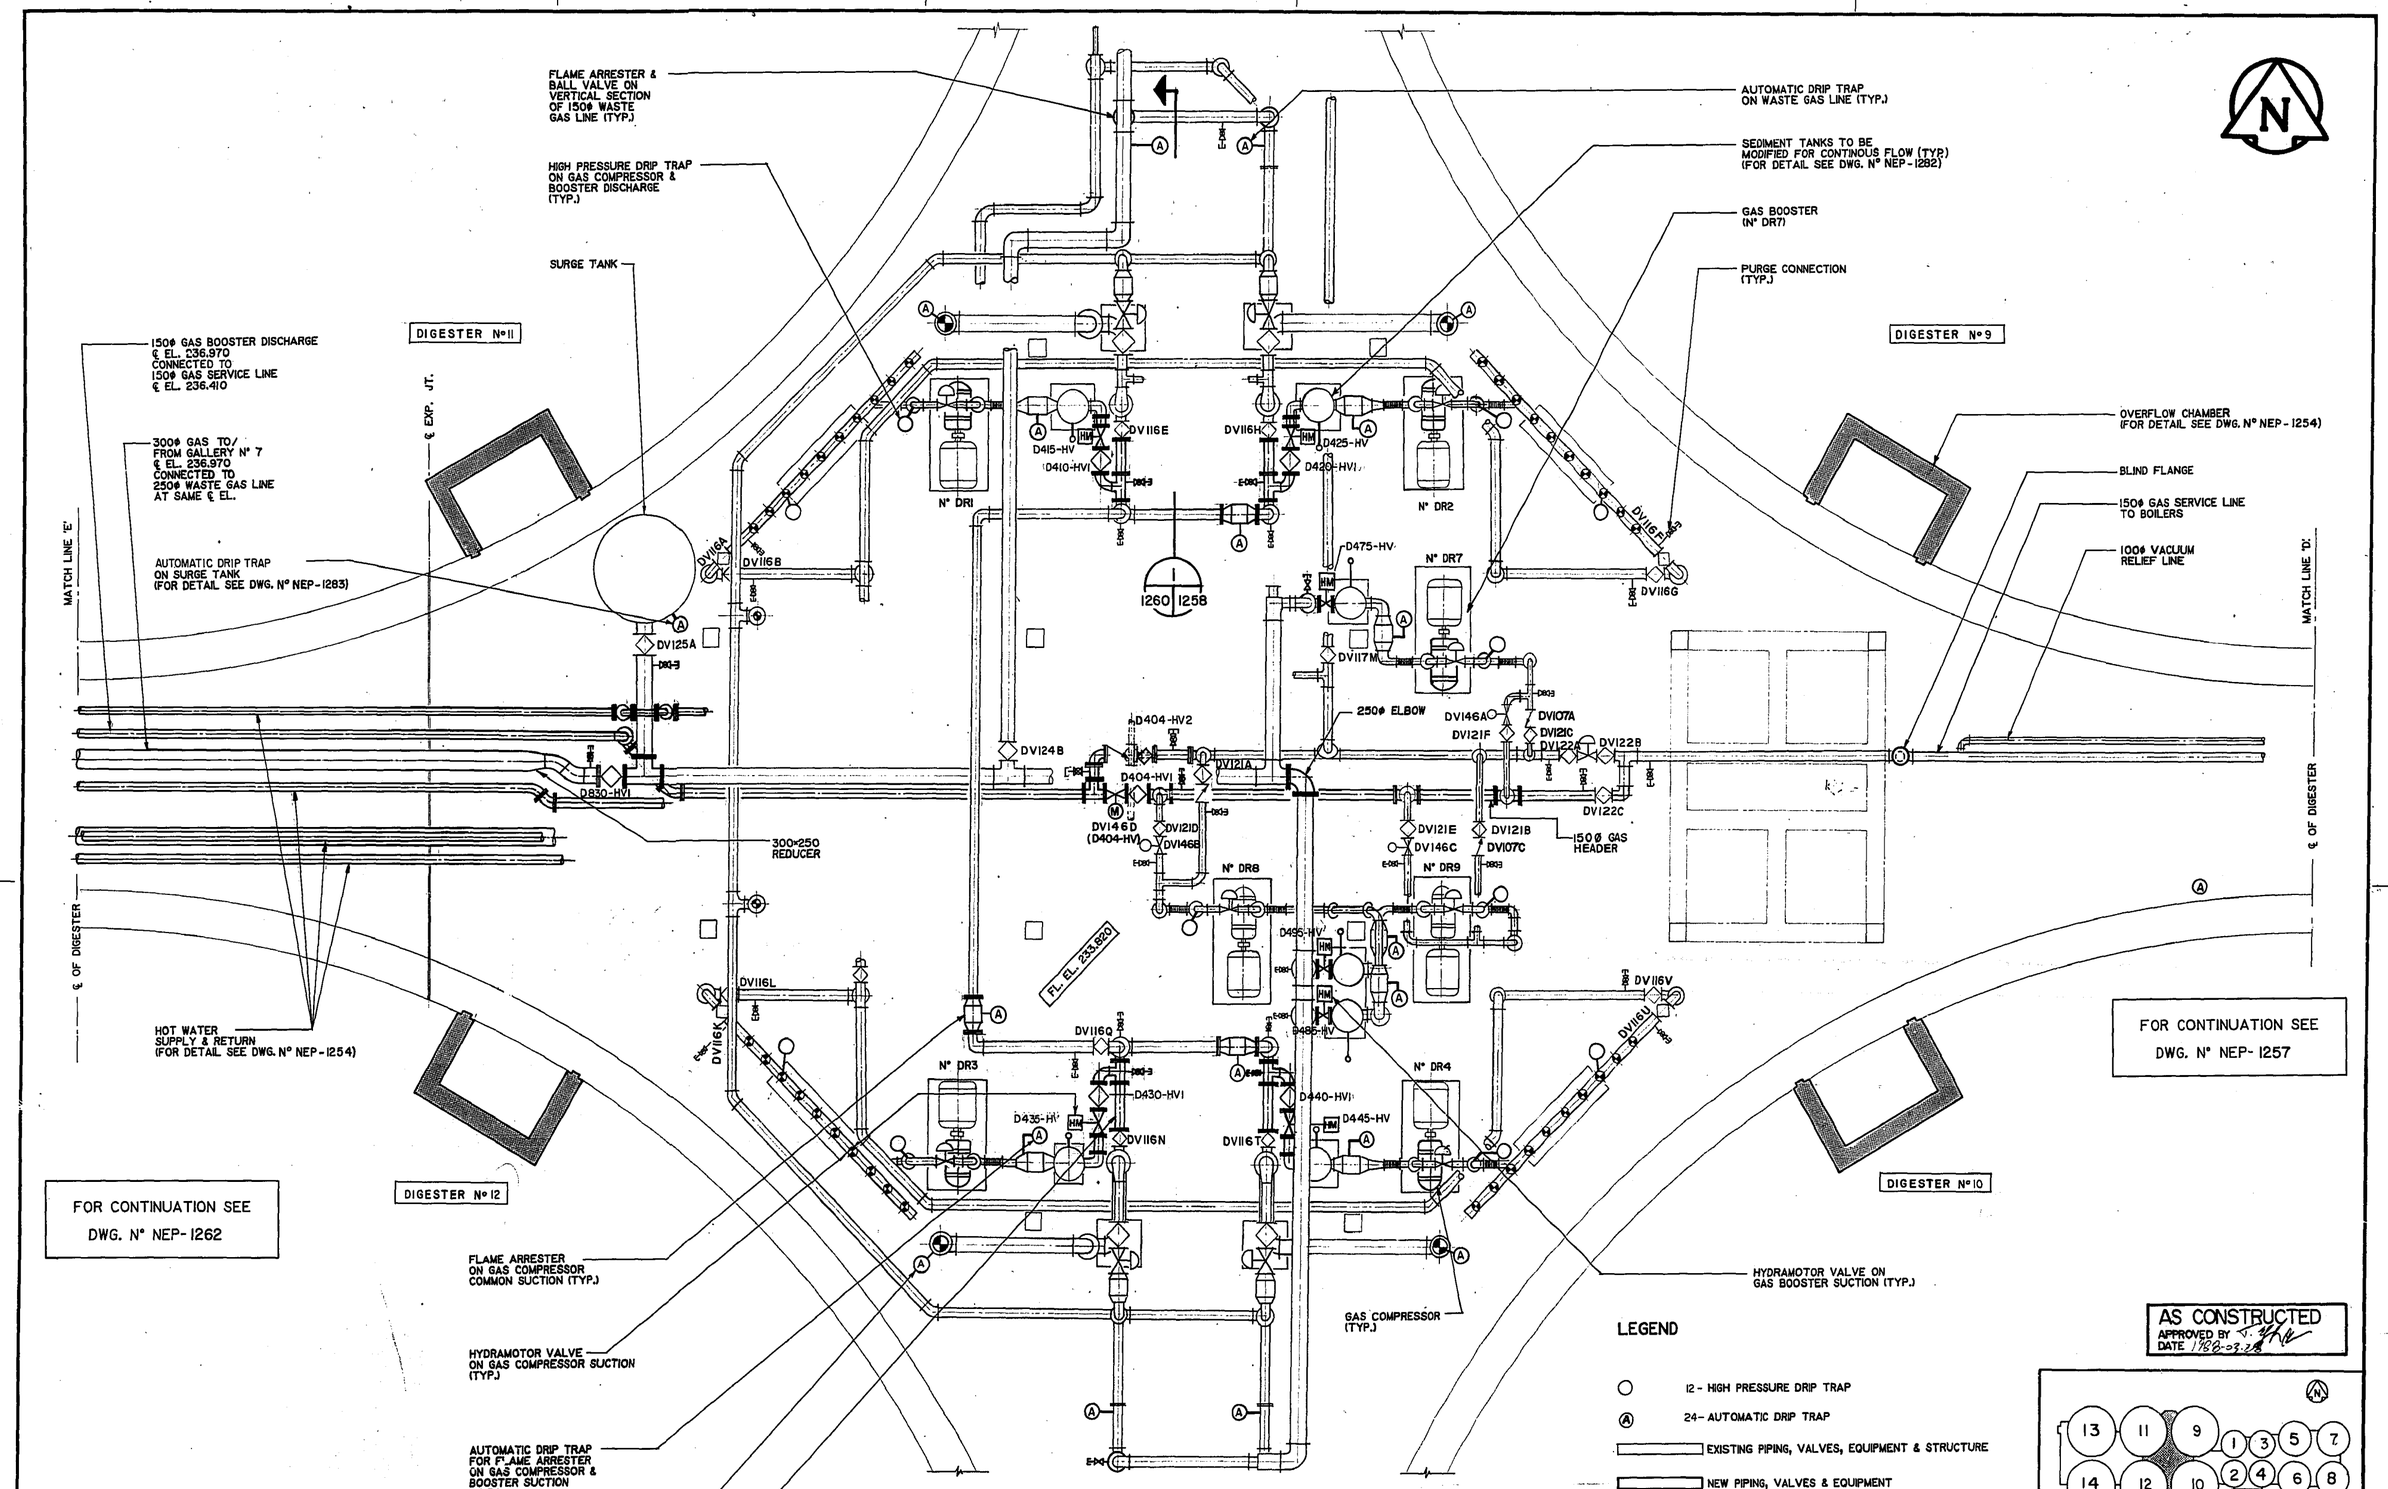

PLAN AT ELEV. 237.000

FOR SHOP DRAWING INFORMATION REFER TO THE SHOP DRAWING CROSS REFERENCE INDEX

NO.	REVISIONS	DATE	APP.
A	REVISED TO AS CONSTRUCTED	17/6/85	

REGISTERED PROFESSIONAL ENGINEER G. G. POWELL PROVINCE OF ONTARIO

A.P.E.M.-112-84(R)
EXP. DATE: 85-10-15
ENGINEER'S SEAL

Underwood McLellan Ltd.
Consulting Engineers and Planners
GORE & STORRIE LIMITED
CONSULTING ENGINEERS

DESIGNED BY: J. CHENG	DRAWN BY: S.C. S.N.
CHECKED BY: J. CHENG	DATE: JUNE/85
APPROVED BY:	DATE: JUNE/85

THE CITY OF WINNIPEG
WORKS & OPERATIONS DIVISION
WATERWORKS, WASTE & DISPOSAL DEPARTMENT

NORTH END WATER POLLUTION CONTROL CENTRE
SLUDGE DIGESTION EXPANSION

DIGESTION GALLERY No. 5
PROCESS (LEVEL 233.820)
GAS SYSTEM ALTERATIONS

RELEASED FOR CONSTRUCTION: DATE: 17/6/85
SCALE: AS NOTED
DRAWING NO.: NEP-1260

G & S FILE 651.01-AI-04044

REF. or DRAWING No. NEP-1260
DETAILS DIGESTION GALLERY No. 5 PROCESS (LEVEL 233.820) GAS SYSTEM ALTERATIONS

Hughes-Owens (Manitoba) 1985 Ltd.
Hughes-Owens (Manitoba) 1985 Ltd.