



EXTERIOR PANEL VIEW
SCALE: NTS

INTERIOR PANEL VIEW
SCALE: NTS

BILL OF MATERIAL				
ITEM	QTY	DESCRIPTION	MANUFACTURER	CATALOG NUMBER
1	1	ENCLOSURE, 356x305x152	HOFFMAN	A1412CHQR
2	1	PANEL FOR ITEM 1	HOFFMAN	A14P12
3	1	BIX 25 PAIR DISTRIBUTION CONNECTOR	-	-
4	1	BIX 50 PAIR MOUNT	-	-
5	1	GROUNDING STRIP - SUITABLE FOR 3 - 10AWG CONDUCTORS	ILSCO	-

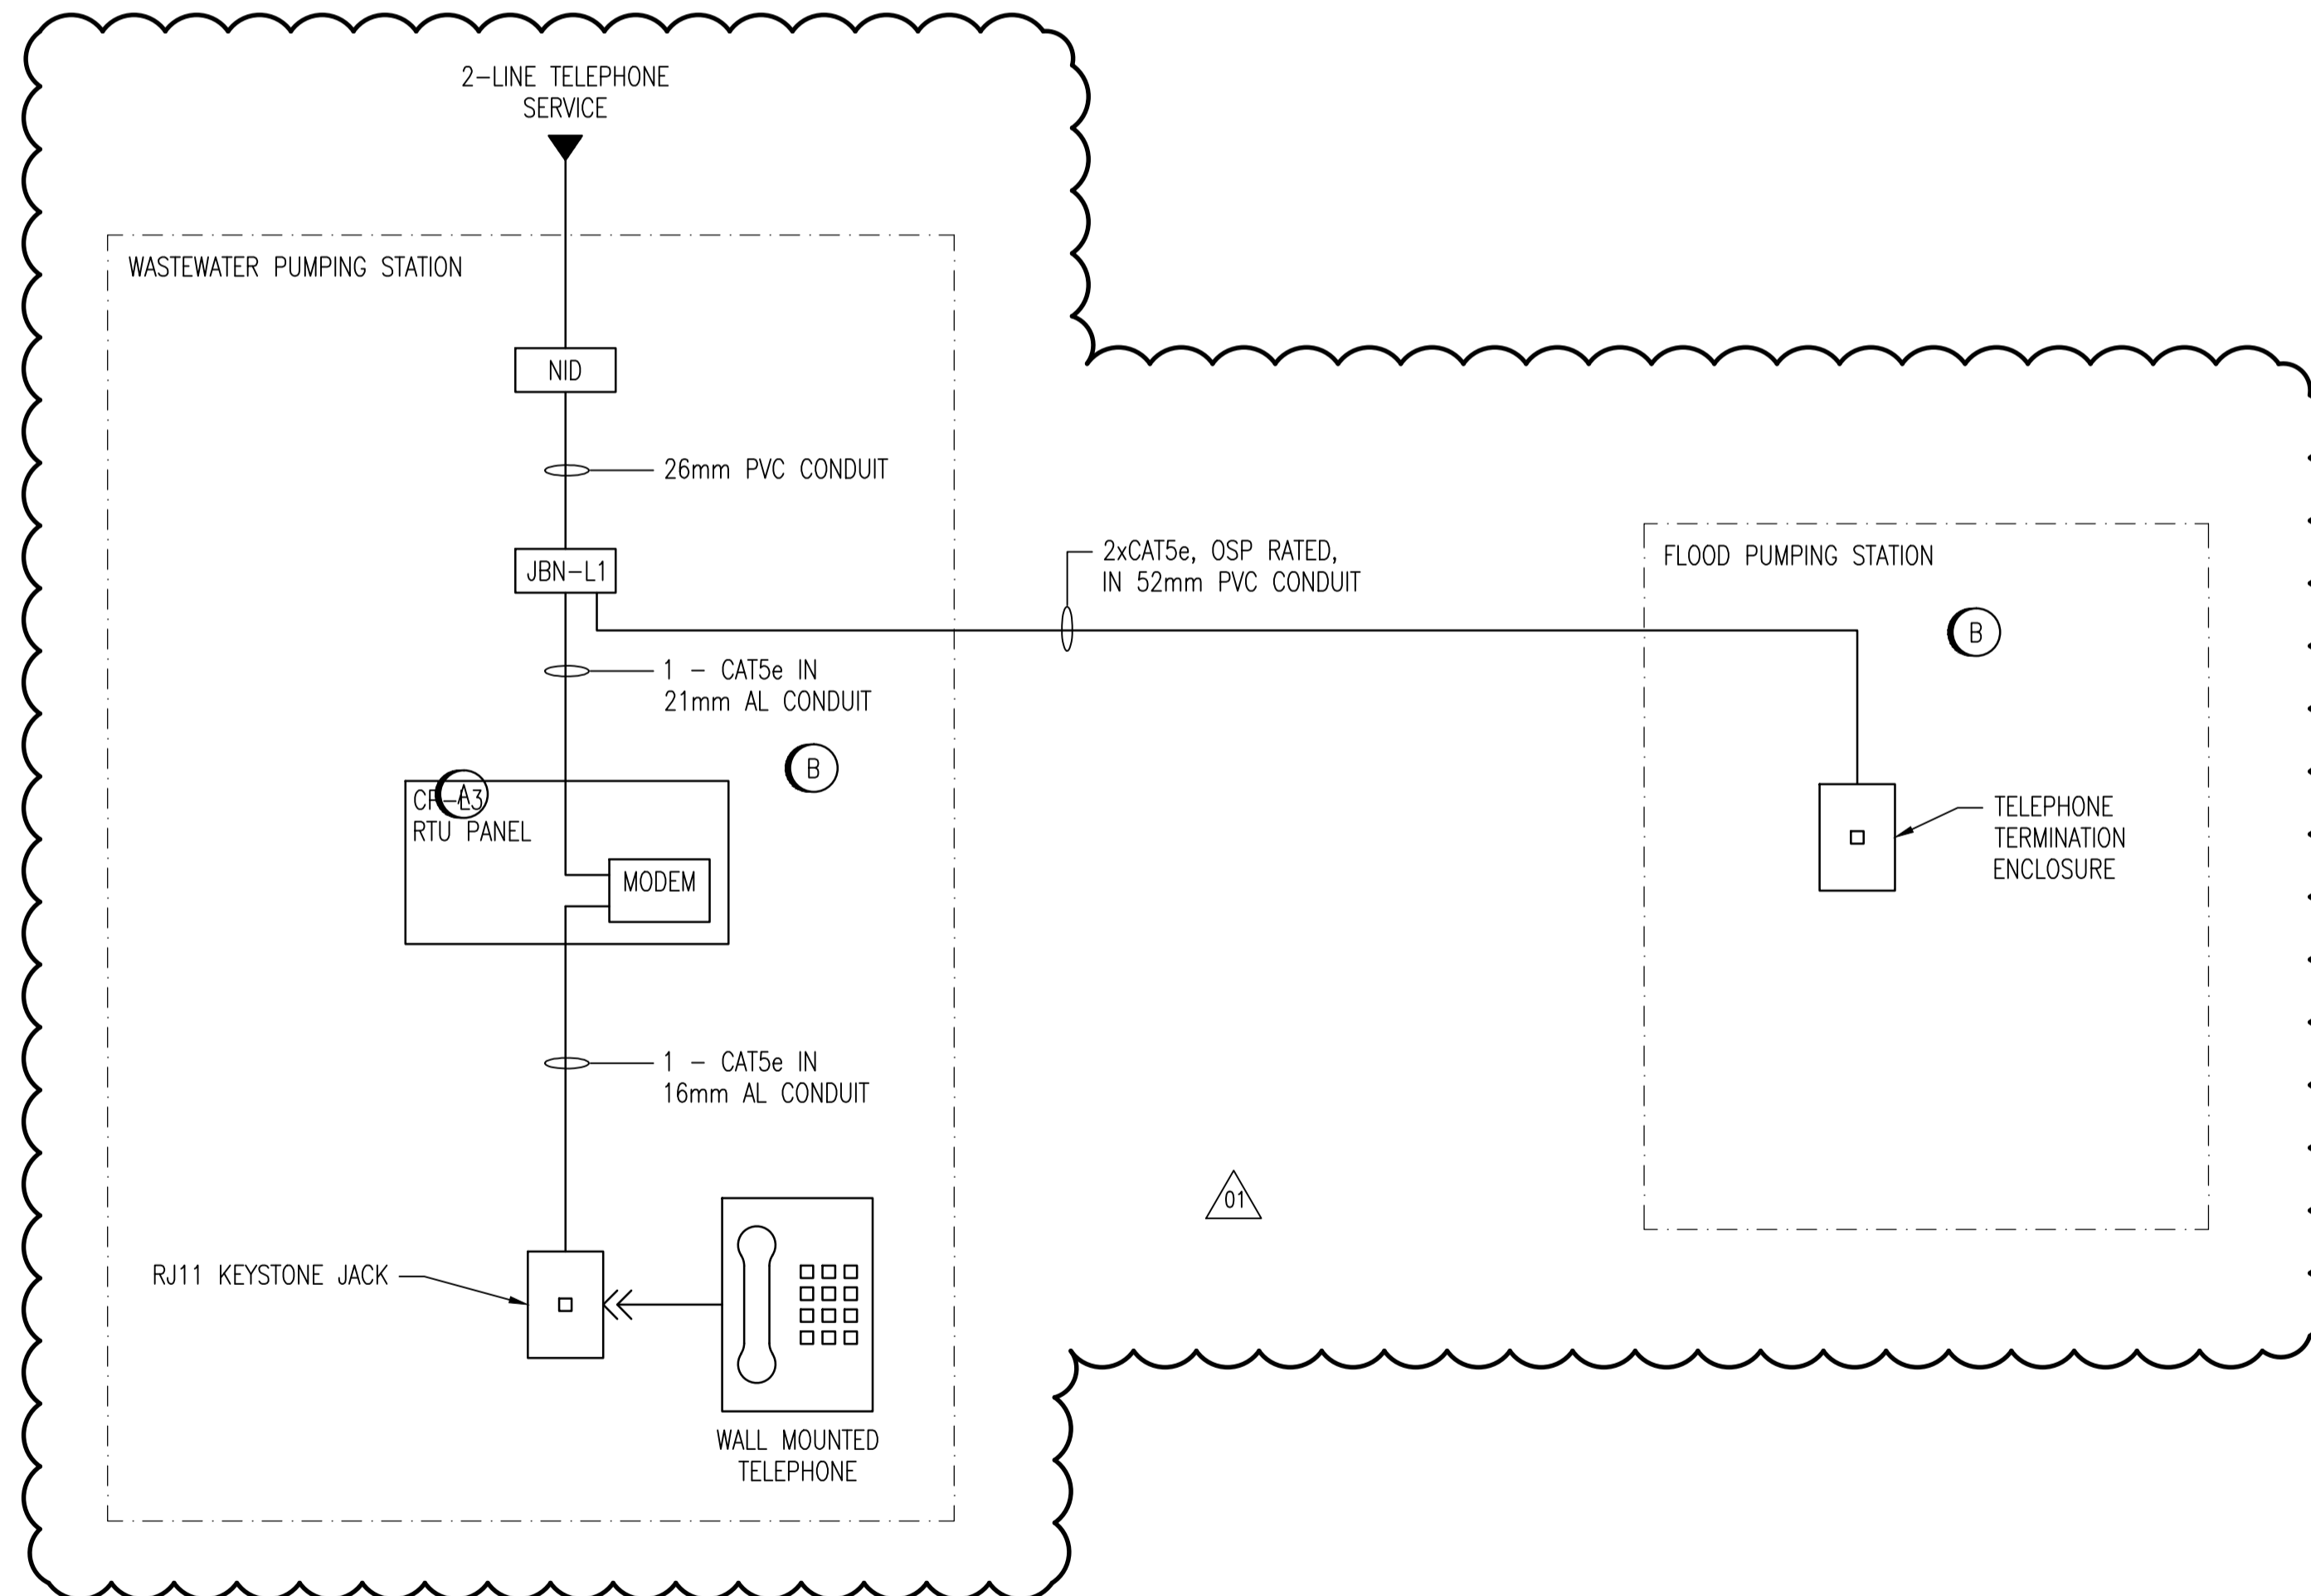

TELEPHONE BLOCK DIAGRAM
SCALE: NTS

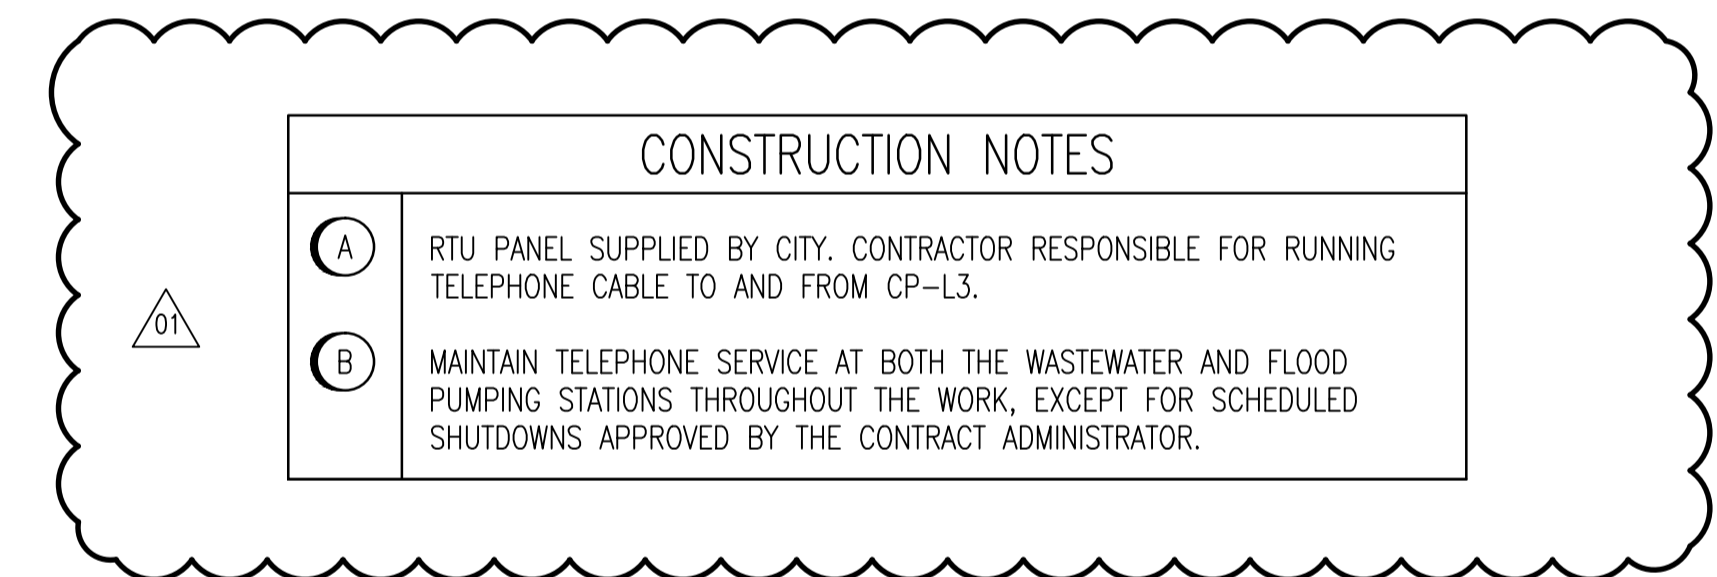

NO.	REVISIONS	DATE	DESIGN	CHECK
01	ADDENDUM 3	2010/10/18	BC	CJR
00	ISSUED FOR TENDER	2010/09/29	BC	CJR

		SNC-LAVALIN INC. 148 Nature Park Way Winnipeg, MB, Canada R3P 0X7 204-786-8080	
DESIGNED BY:	B. CLEVEN	CHECKED BY:	C. REIMER
DRAWN BY:	S. COATES	APPROVED BY:	C. REIMER
SCALE:	NTS	RELEASED FOR CONSTRUCTION BY:	K. ZUREK
DATE:	2010/08/19	DATE:	2010/10/04
CONSULTANT NO.:	113368-0000-47DD-0015		

ENGINEER'S SEAL

ORIGINAL DRAWING
SEALED BY:
C. REIMER
SNC-LAVALIN INC.
2010/10/18
REV. 01

THE CITY OF WINNIPEG
 WATER AND WASTE DEPARTMENT

MARION WASTEWATER PUMPING STATION
 INSTALLATION OF PUMPING UNITS & BUILDING UPGRADES
 DETAILS
 TELEPHONE NETWORK

CITY DRAWING NUMBER: 1-0159L-E0015
 SHEET: 001
 REV.: 01
 SIZE: A1