


ISSUES:

| | | |
|---|---------------|--|
| 1 | APRIL 2010 | PHASE 1 - 70% COMPLETION |
| 2 | MAY 14, 2010 | PHASE 2 - 80% COMPLETION |
| 3 | SEPT 15, 2010 | PHASE 3 - BUILDING PERMIT PRELIMINARY REVIEW |
| 4 | SEPT 29, 2010 | ISSUED FOR BUILDING PERMIT / TENDER |
| 5 | FEB 14, 2011 | ISSUED FOR ADDENDUM 6 |

- GENERAL NOTES:
- REFER TO REFLECTED CEILING PLAN FOR BULKHEAD LOCATIONS & DIMENSIONS
 - REFER TO STRUCTURAL DRAWINGS FOR STRUCTURAL REQUIREMENTS
 - REFER TO MECHANICAL DRAWINGS FOR EXTERIOR WALL PENETRATIONS
 - REFER TO FLOOR PLANS FOR PARTITION TYPES
 - REFER TO ROOM FINISH SCHEDULE FOR ROOM FINISHES

© COPYRIGHT MURPHY & MURPHY ARCHITECT 2010
 NOT TO BE REPRODUCED WITHOUT CONSENT OF ARCHITECT.

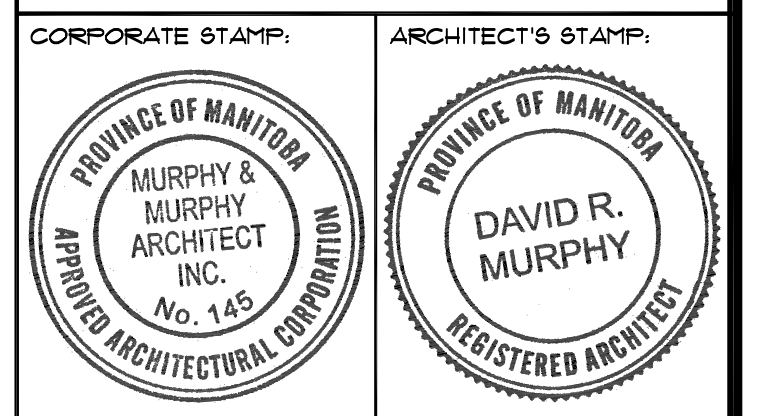

MURPHY & MURPHY ARCHITECT INC.
 775 WATERLOO STREET, LONDON, ONTARIO N6A 3W5
 PH: (519) 433-5161 FAX: (519) 433-5163

CONTRACTOR SHALL CHECK ALL DIMENSIONS ON THE DRAWINGS AND REPORT ANY DISCREPANCIES TO THE ARCHITECT BEFORE PROCEEDING. ALL DRAWINGS AND SPECIFICATIONS ARE PROPERTY OF THE ARCHITECT AND MUST BE RETURNED AT THE COMPLETION OF THE WORK. DRAWINGS ARE NOT TO BE SCALED. USE ONLY THE LATEST REVISED DRAWINGS OR THOSE THAT ARE MARKED 'ISSUED FOR CONSTRUCTION'. ANY UNAUTHORIZED USE IS PROHIBITED. AREA CALCULATIONS ARE APPROXIMATE.

PROJECT NAME:
NEW WINNIPEG STATION No. 27 PROJECT

SAGE CREEK, WINNIPEG, MANITOBA

DRAWING TITLE:
WALL SECTIONS 1-10

PROJECT NORTH: STAMP:

SCALE: 1:20 PROJECT NO: **2261**

DATE: FEBRUARY 14, 2011 FILE NAME:

ISSUED: SEPTEMBER 29, 2010 DRAWING NO:

DRAWN BY: JES **A6.4**

CHECKED BY: DR1

NOTE:
 SEE DRAWING A6.3 & A6.4 FOR OTHER CANOPY WALL SECTIONS THRU MAIN ENTRANCE CANOPY, STAFF ENTRANCE AND TYPICAL CANOPY SECTION.