


**PART FOUNDATION PLAN AND FLOOR SLAB
LEFT - RIGHT DIRECTION REINFORCING**

SCALE: 1: 75

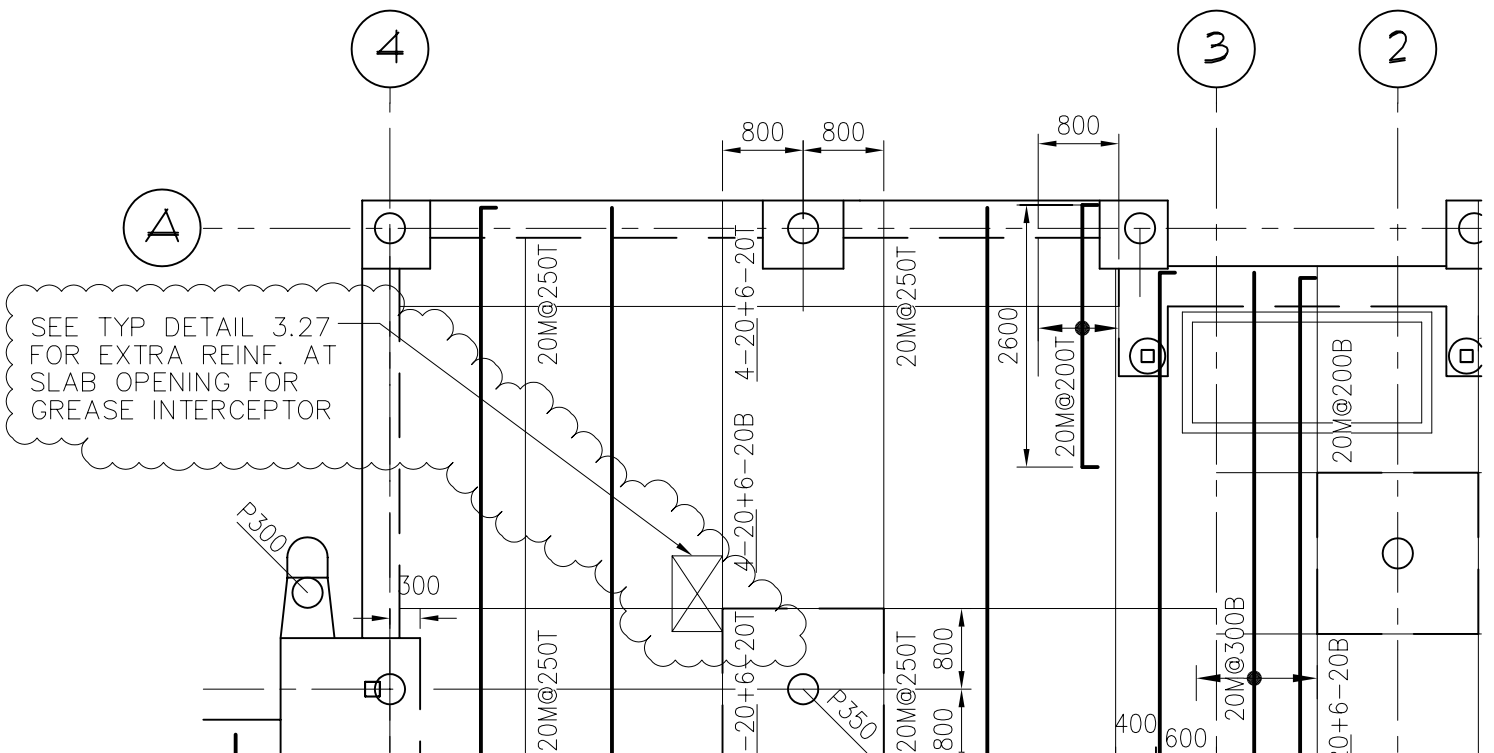

PART FLOOR SLAB FRONT - REAR DIRECTION REINFORCING

SCALE: 1: 75

NEW WINNIPEG FIRE
STATION, NO. 27 PROJECT

WINNIPEG, MANITOBA

VB & S VanBoxmeer & Stranges Ltd.
STRUCTURAL ENGINEERS
458 Queens Ave, London, ON, Canada N6B 1X9
tel. (519) 433-4661 fax. (519) 433-6420

DRAWN BY:
GVB

PROJECT #:
10123

CHECKED BY:
RAS

DRAWING #:

DATE:
FEB 15, 2011

SK1.1B