




A S.B. WEST SIDE EARTH WORK SECTION
15 16 1:100

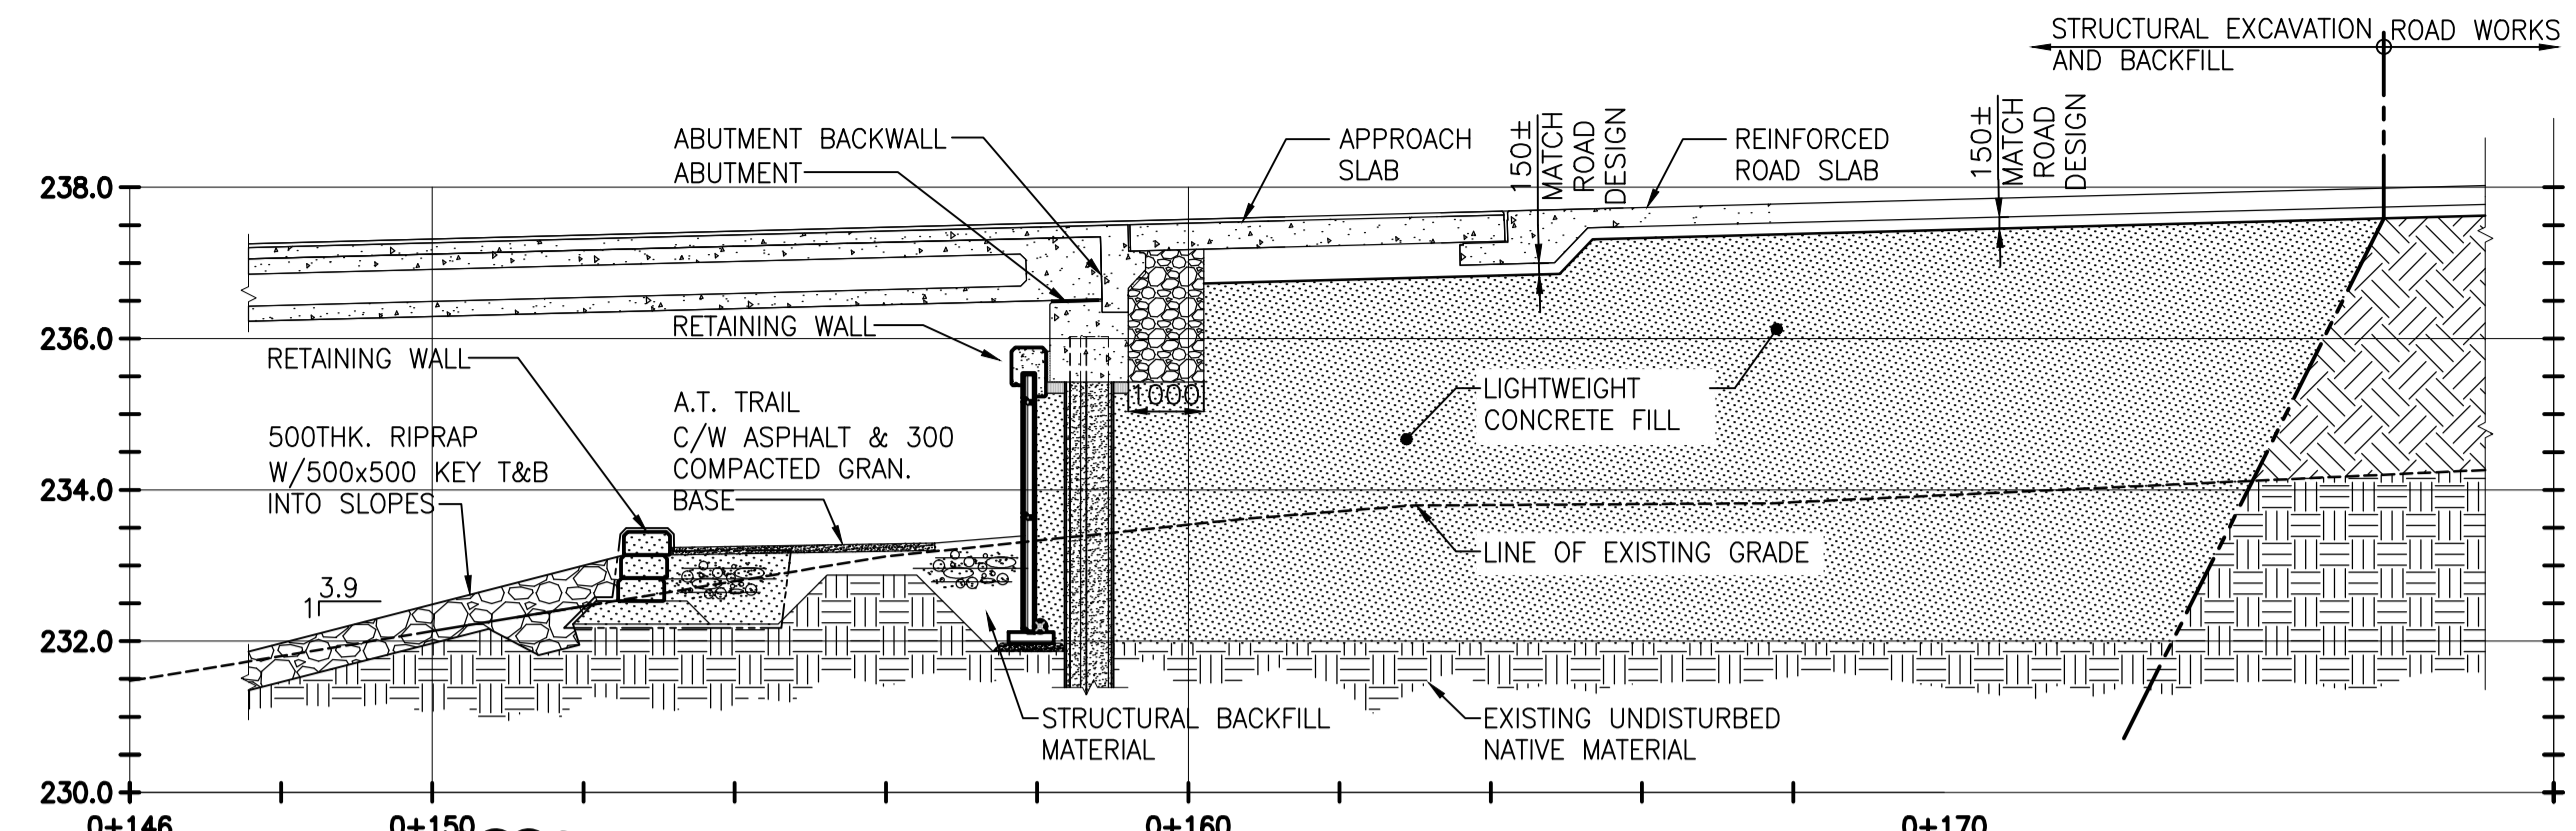


B S.B. WEST SIDE EARTH WORK SECTION
15 16 1:100

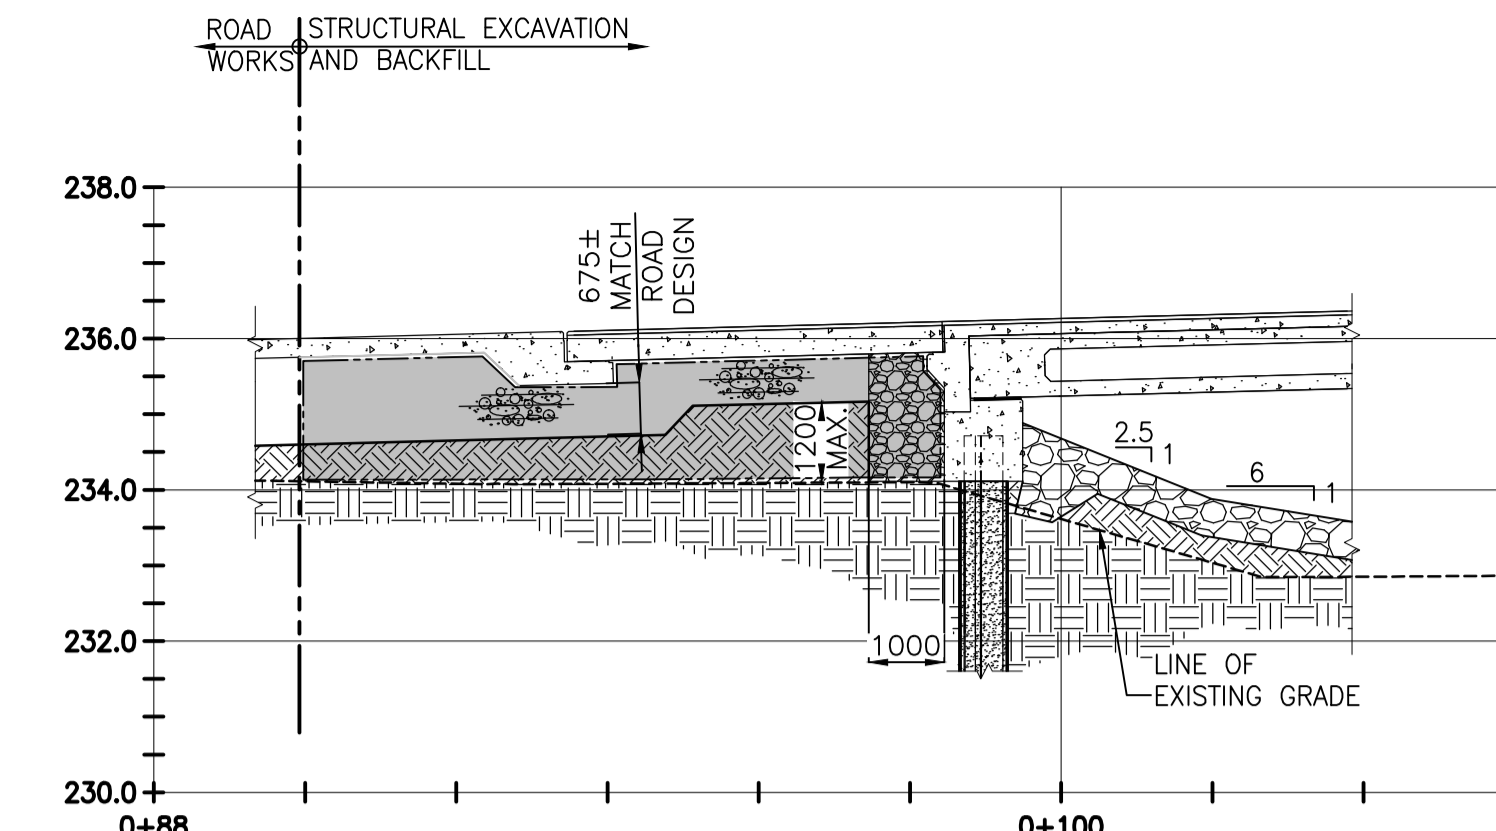


C N.B. WEST SIDE EARTH WORK SECTION
15 16 1:100

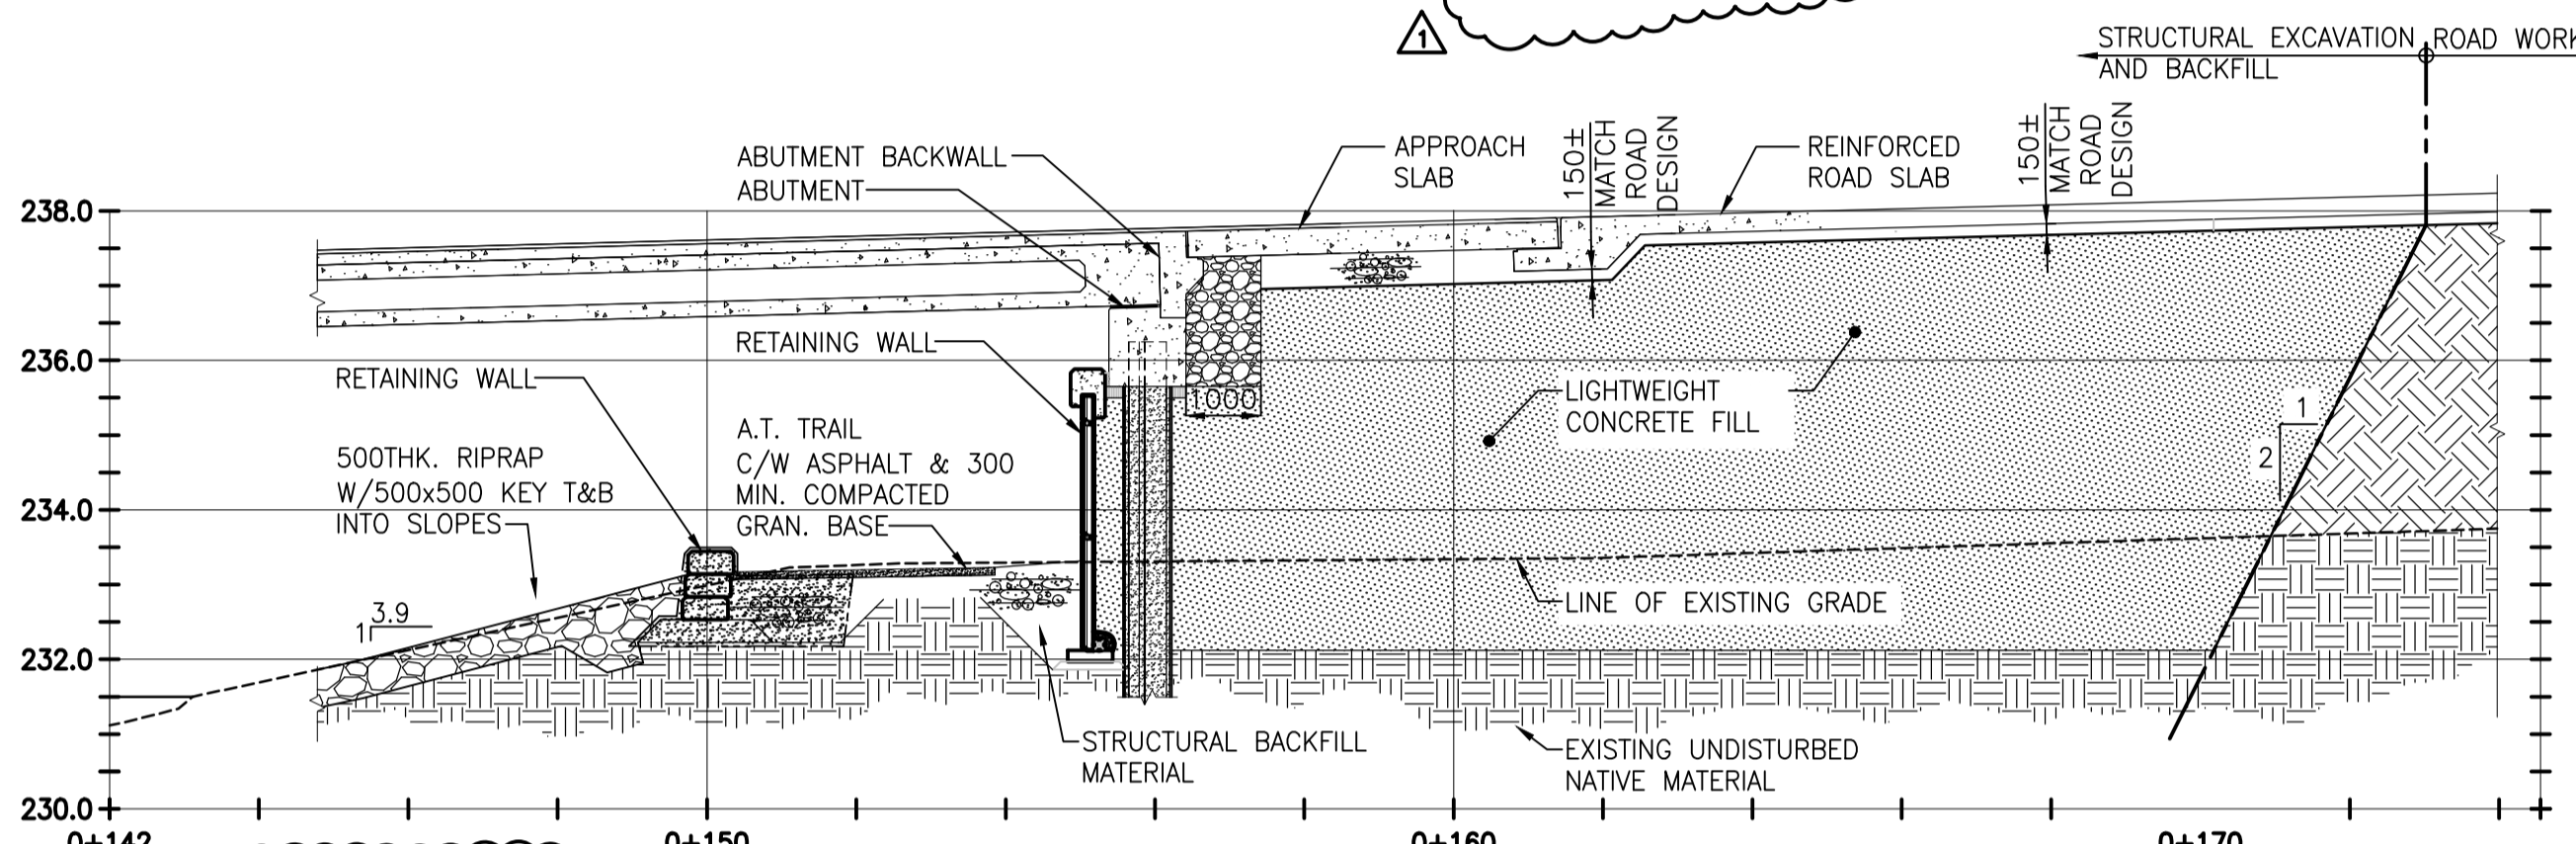


D N.B. WEST SIDE EARTH WORK SECTION
15 16 1:100

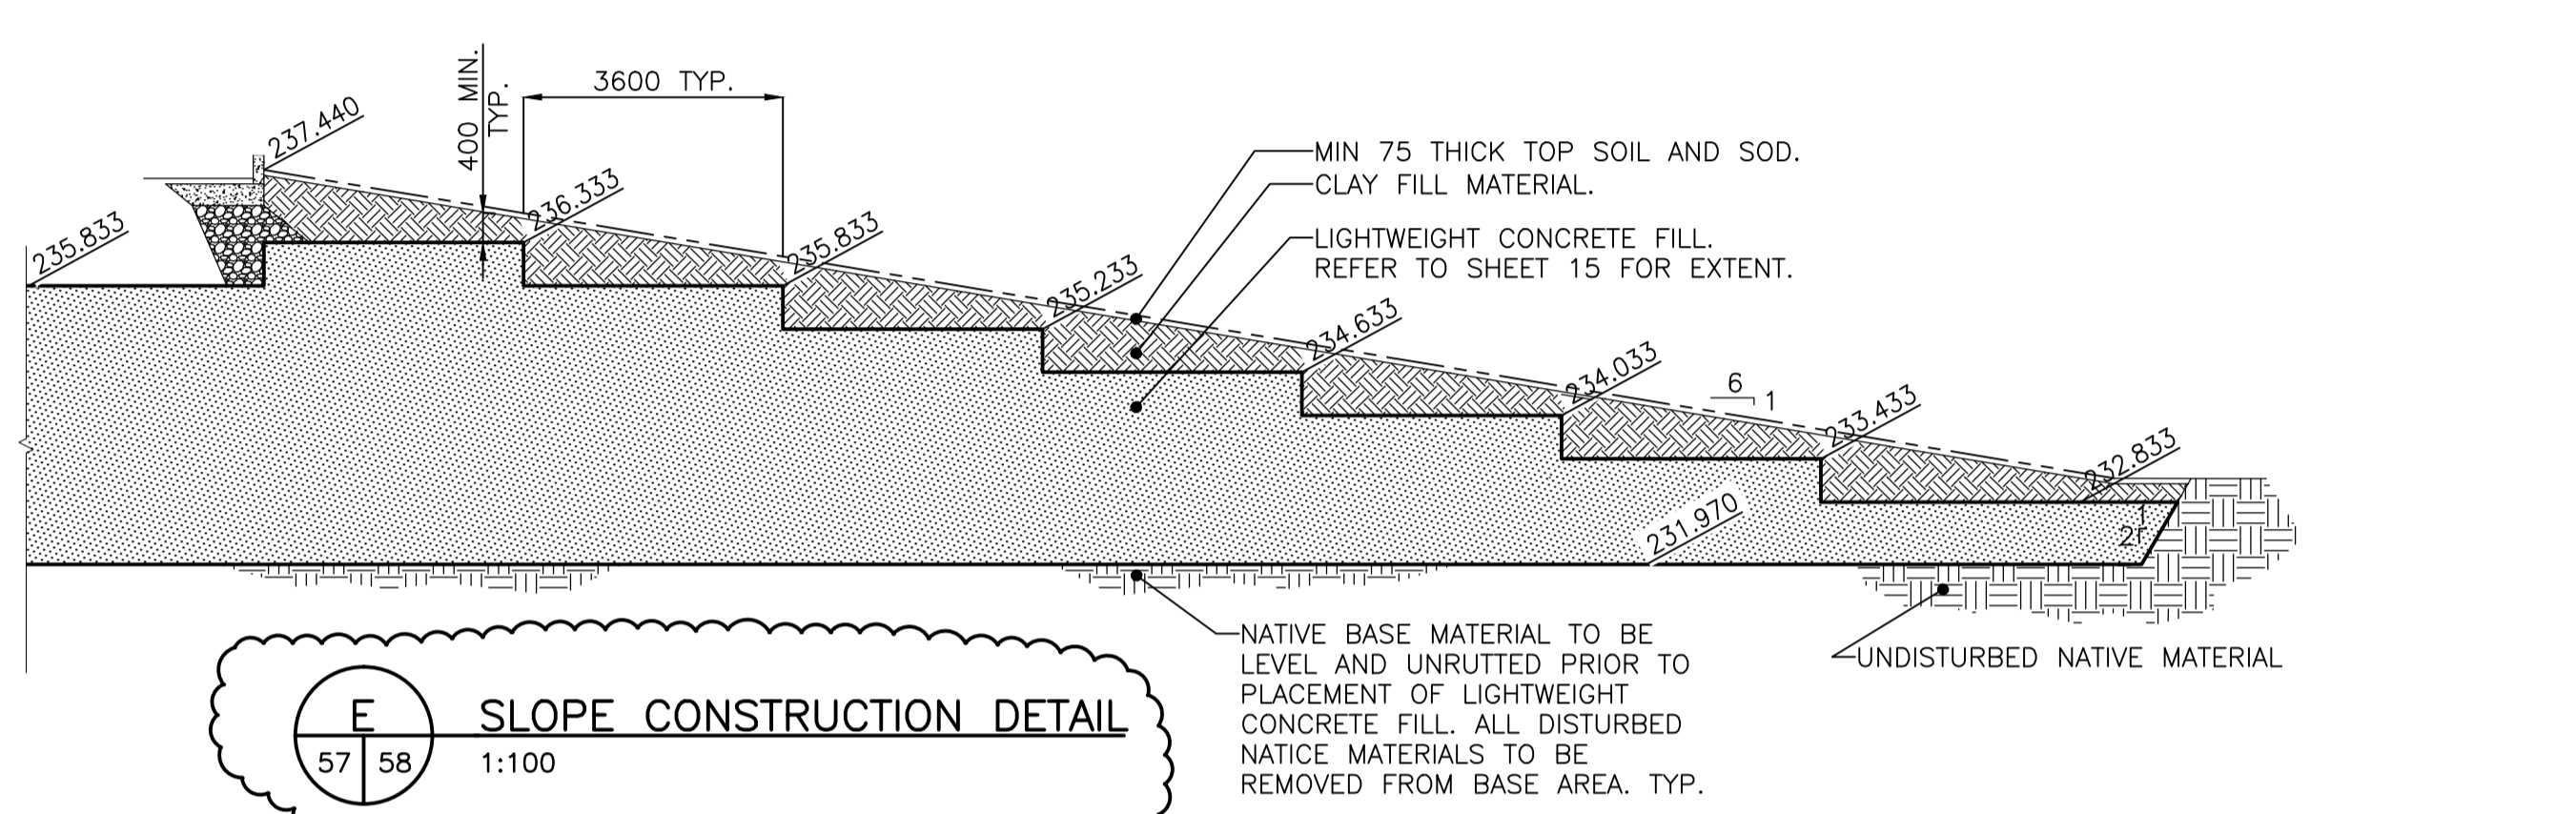


E SLOPE CONSTRUCTION DETAIL
57 58 1:100

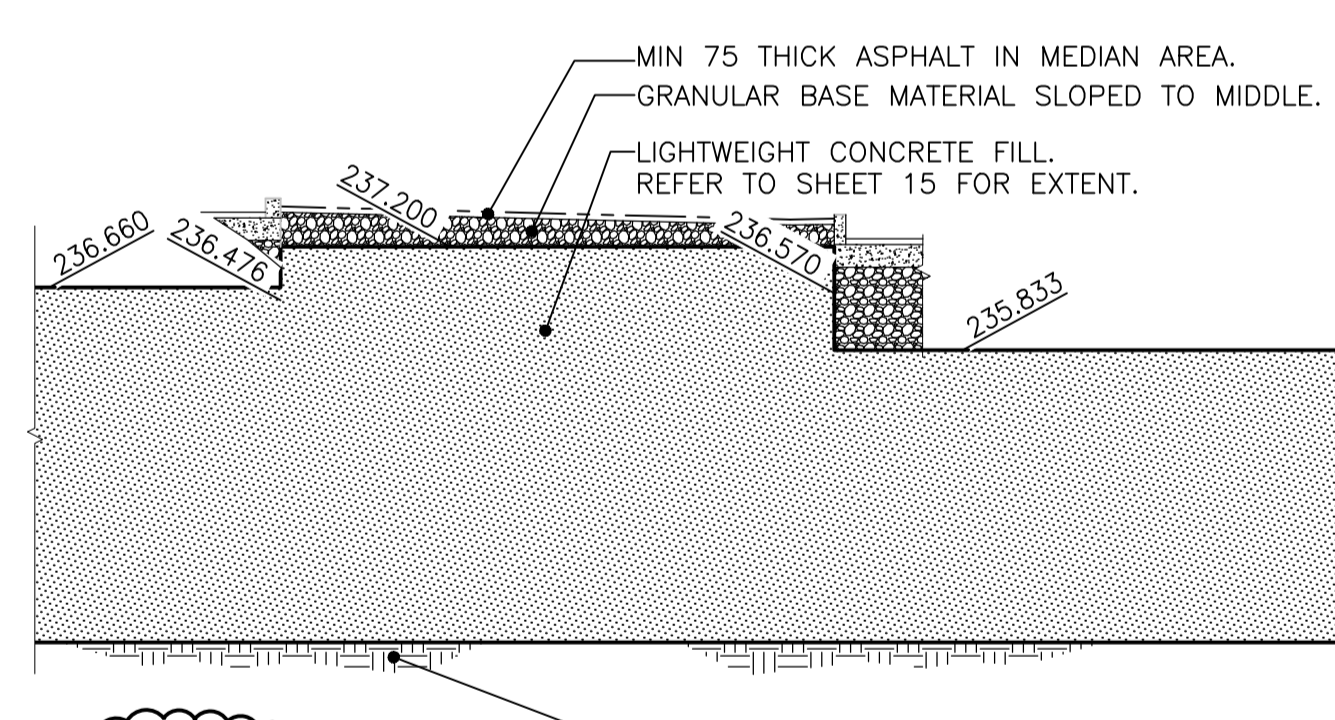

F SLOPE CONSTRUCTION DETAIL
57 58 1:100 NOTE: SECTION IS CUT ON A SKEW AND CANNOT BE SCALED TO DEFINE AREA. REFER TO PLAN ON SHEET 15

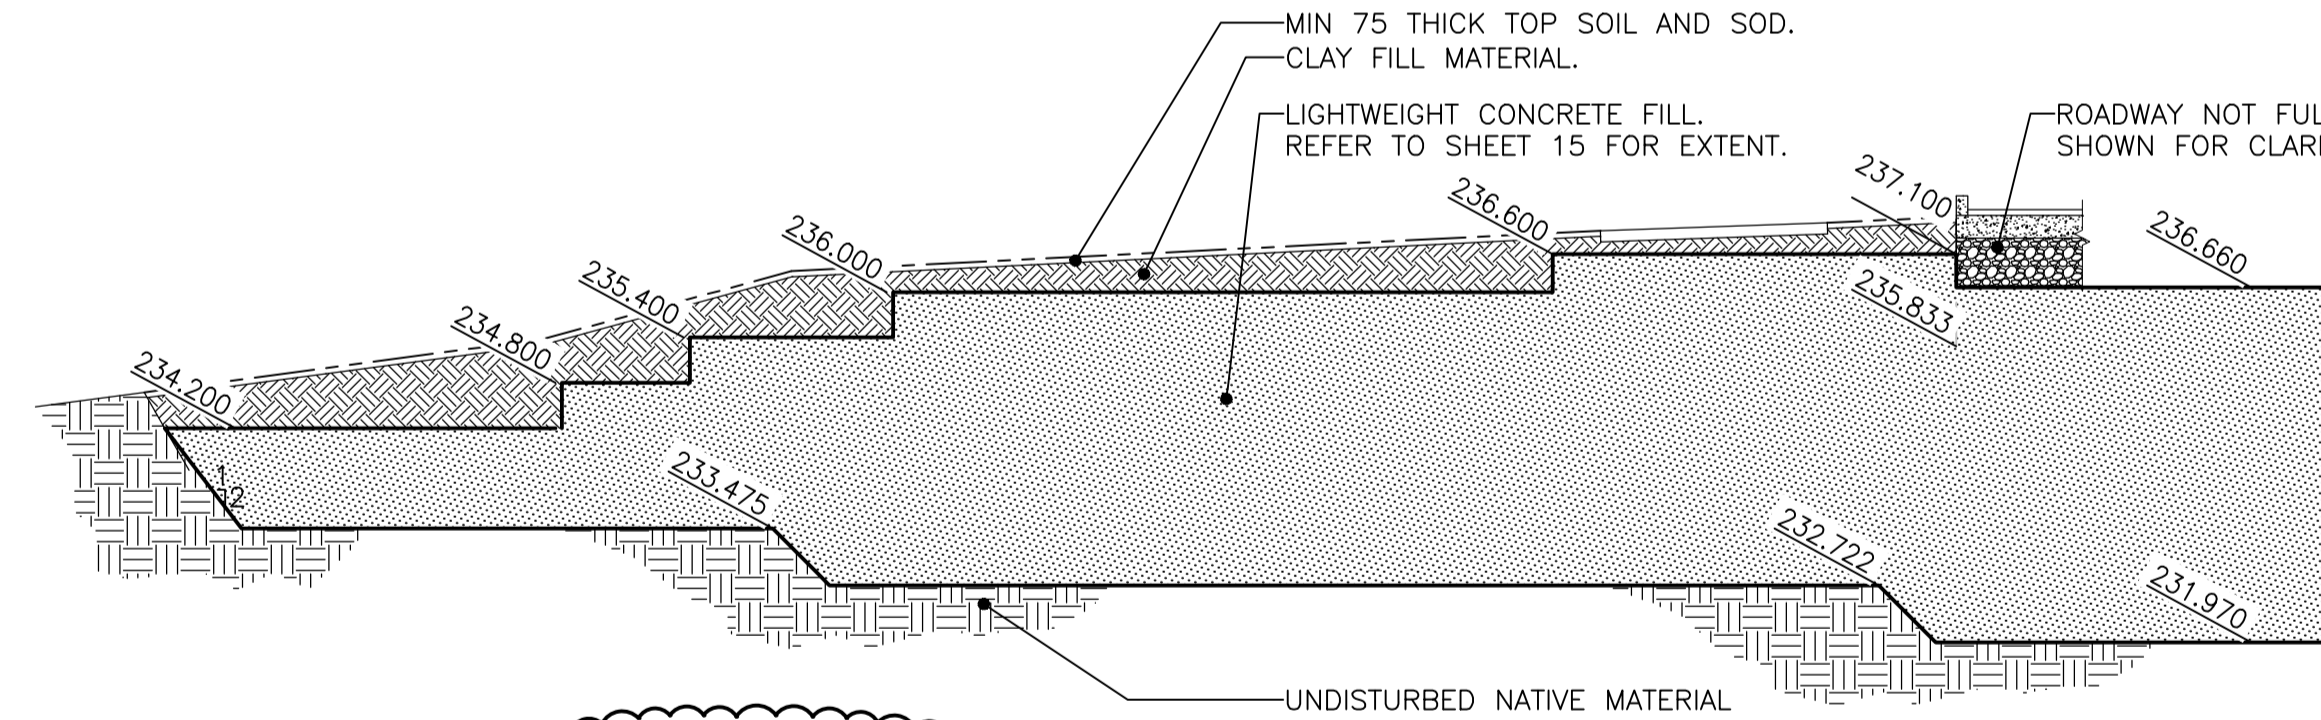

G SLOPE CONSTRUCTION DETAIL
57 58 1:100 NOTE: SECTION IS CUT ON A SKEW AND CANNOT BE SCALED TO DEFINE AREA. REFER TO PLAN ON SHEET 15

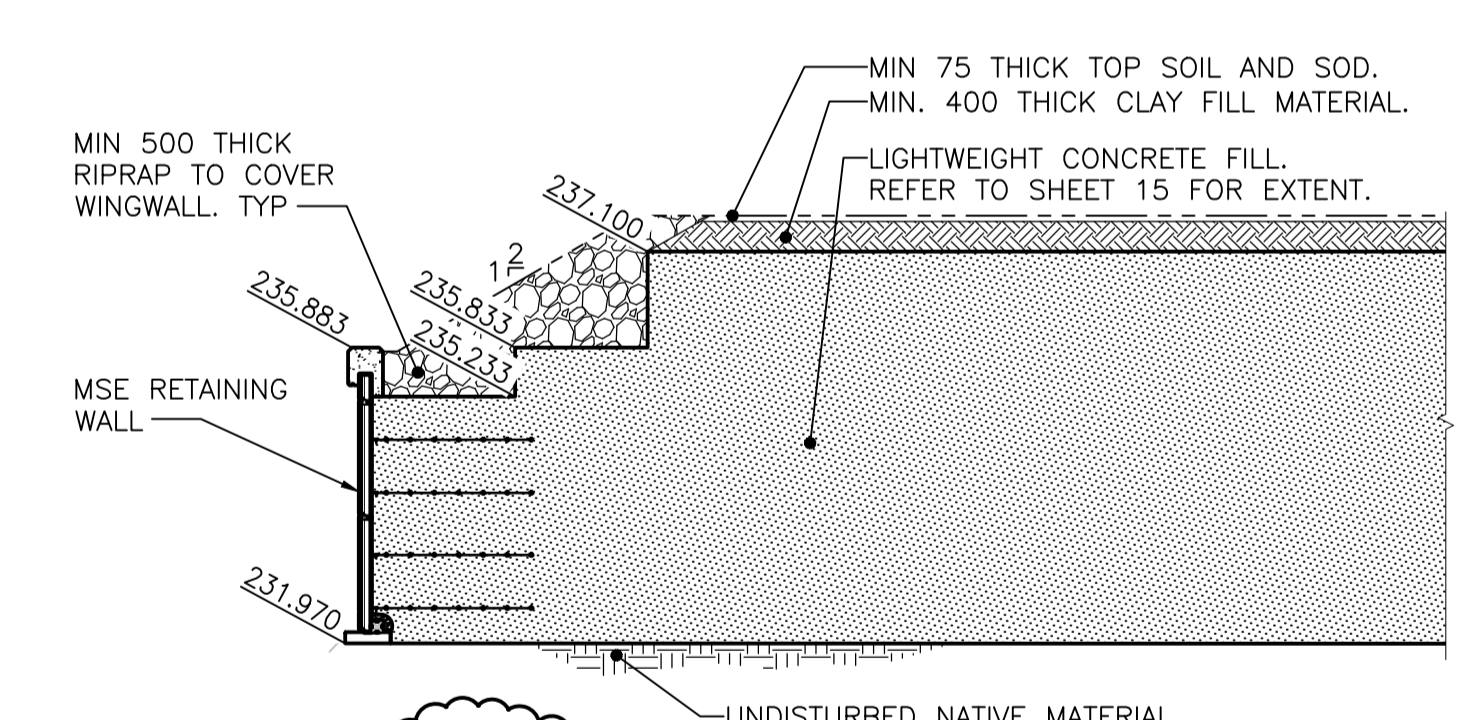

H SLOPE CONSTRUCTION DETAIL
57 58 1:100 NOTE: SECTION IS CUT ON A SKEW AND CANNOT BE SCALED TO DEFINE AREA. REFER TO PLAN ON SHEET 15

V:\1137\active\1137\1590\drawing\403_addenda\sheet_files\bridge\31590s-108-767.dwg Date: 2012 Jan 16 5:27pm Login: Bremeris, James



METRIC
WHOLE NUMBERS INDICATE MILLIMETRES
DECIMALIZED NUMBERS INDICATE METRES

LOCATION APPROVED UNDERGROUND STRUCTURES			
SUPV. U/G STRUCTURES COMMITTEE	DATE		
NOTE: LOCATION OF UNDERGROUND STRUCTURES AS SHOWN ARE BASED ON THE BEST INFORMATION AVAILABLE BUT NO GUARANTEE IS GIVEN THAT ALL EXISTING UTILITIES ARE SHOWN OR THAT THE GIVEN LOCATIONS ARE EXACT. CONFIRMATION OF EXISTENCE AND EXACT LOCATION OF ALL SERVICES MUST BE OBTAINED FROM THE INDIVIDUAL UTILITIES BEFORE PROCEEDING WITH CONSTRUCTION.			

B.M. 83R592 ELEV. 236.590 m			
NO.	REVISIONS	DATE	BY
1	REVISED PER ADDENDUM No.1	12.01.18	K.S.A.
0	ISSUED FOR TENDER	11.12.15	K.S.A.

Stantec Consulting Ltd.			
100-1355 Taylor Ave., Winnipeg, Manitoba Tel 204-928-8840 Fax 204-284-4795			
DESIGNED BY	K.S.A.	CHECKED BY	K.S.A.
DRAWN BY	V.J.F.	APPROVED BY	B.J.W.
HOR. SCALE: AS SHOWN		RELEASED FOR CONSTRUCTION:	
VERTICAL:		DATE	
DATE DEC. 15, 2011		DATE	

ENGINEER'S SEAL
CONSULTANT DRAWING NO. S-108

THE CITY OF WINNIPEG PUBLIC WORKS DEPARTMENT ENGINEERING DIVISION	
STURGEON ROAD BRIDGE REPLACEMENT PORTAGE AVENUE TO HALLONQUIST DRIVE GENERAL EXCAVATION, BACKFILL & RIPRAP SECTIONS	
SHEET 16	OF 82
CAD FILE DRAWING NUMBER 31590s-107-767.dwg	
CITY DRAWING NUMBER B120-12-016	