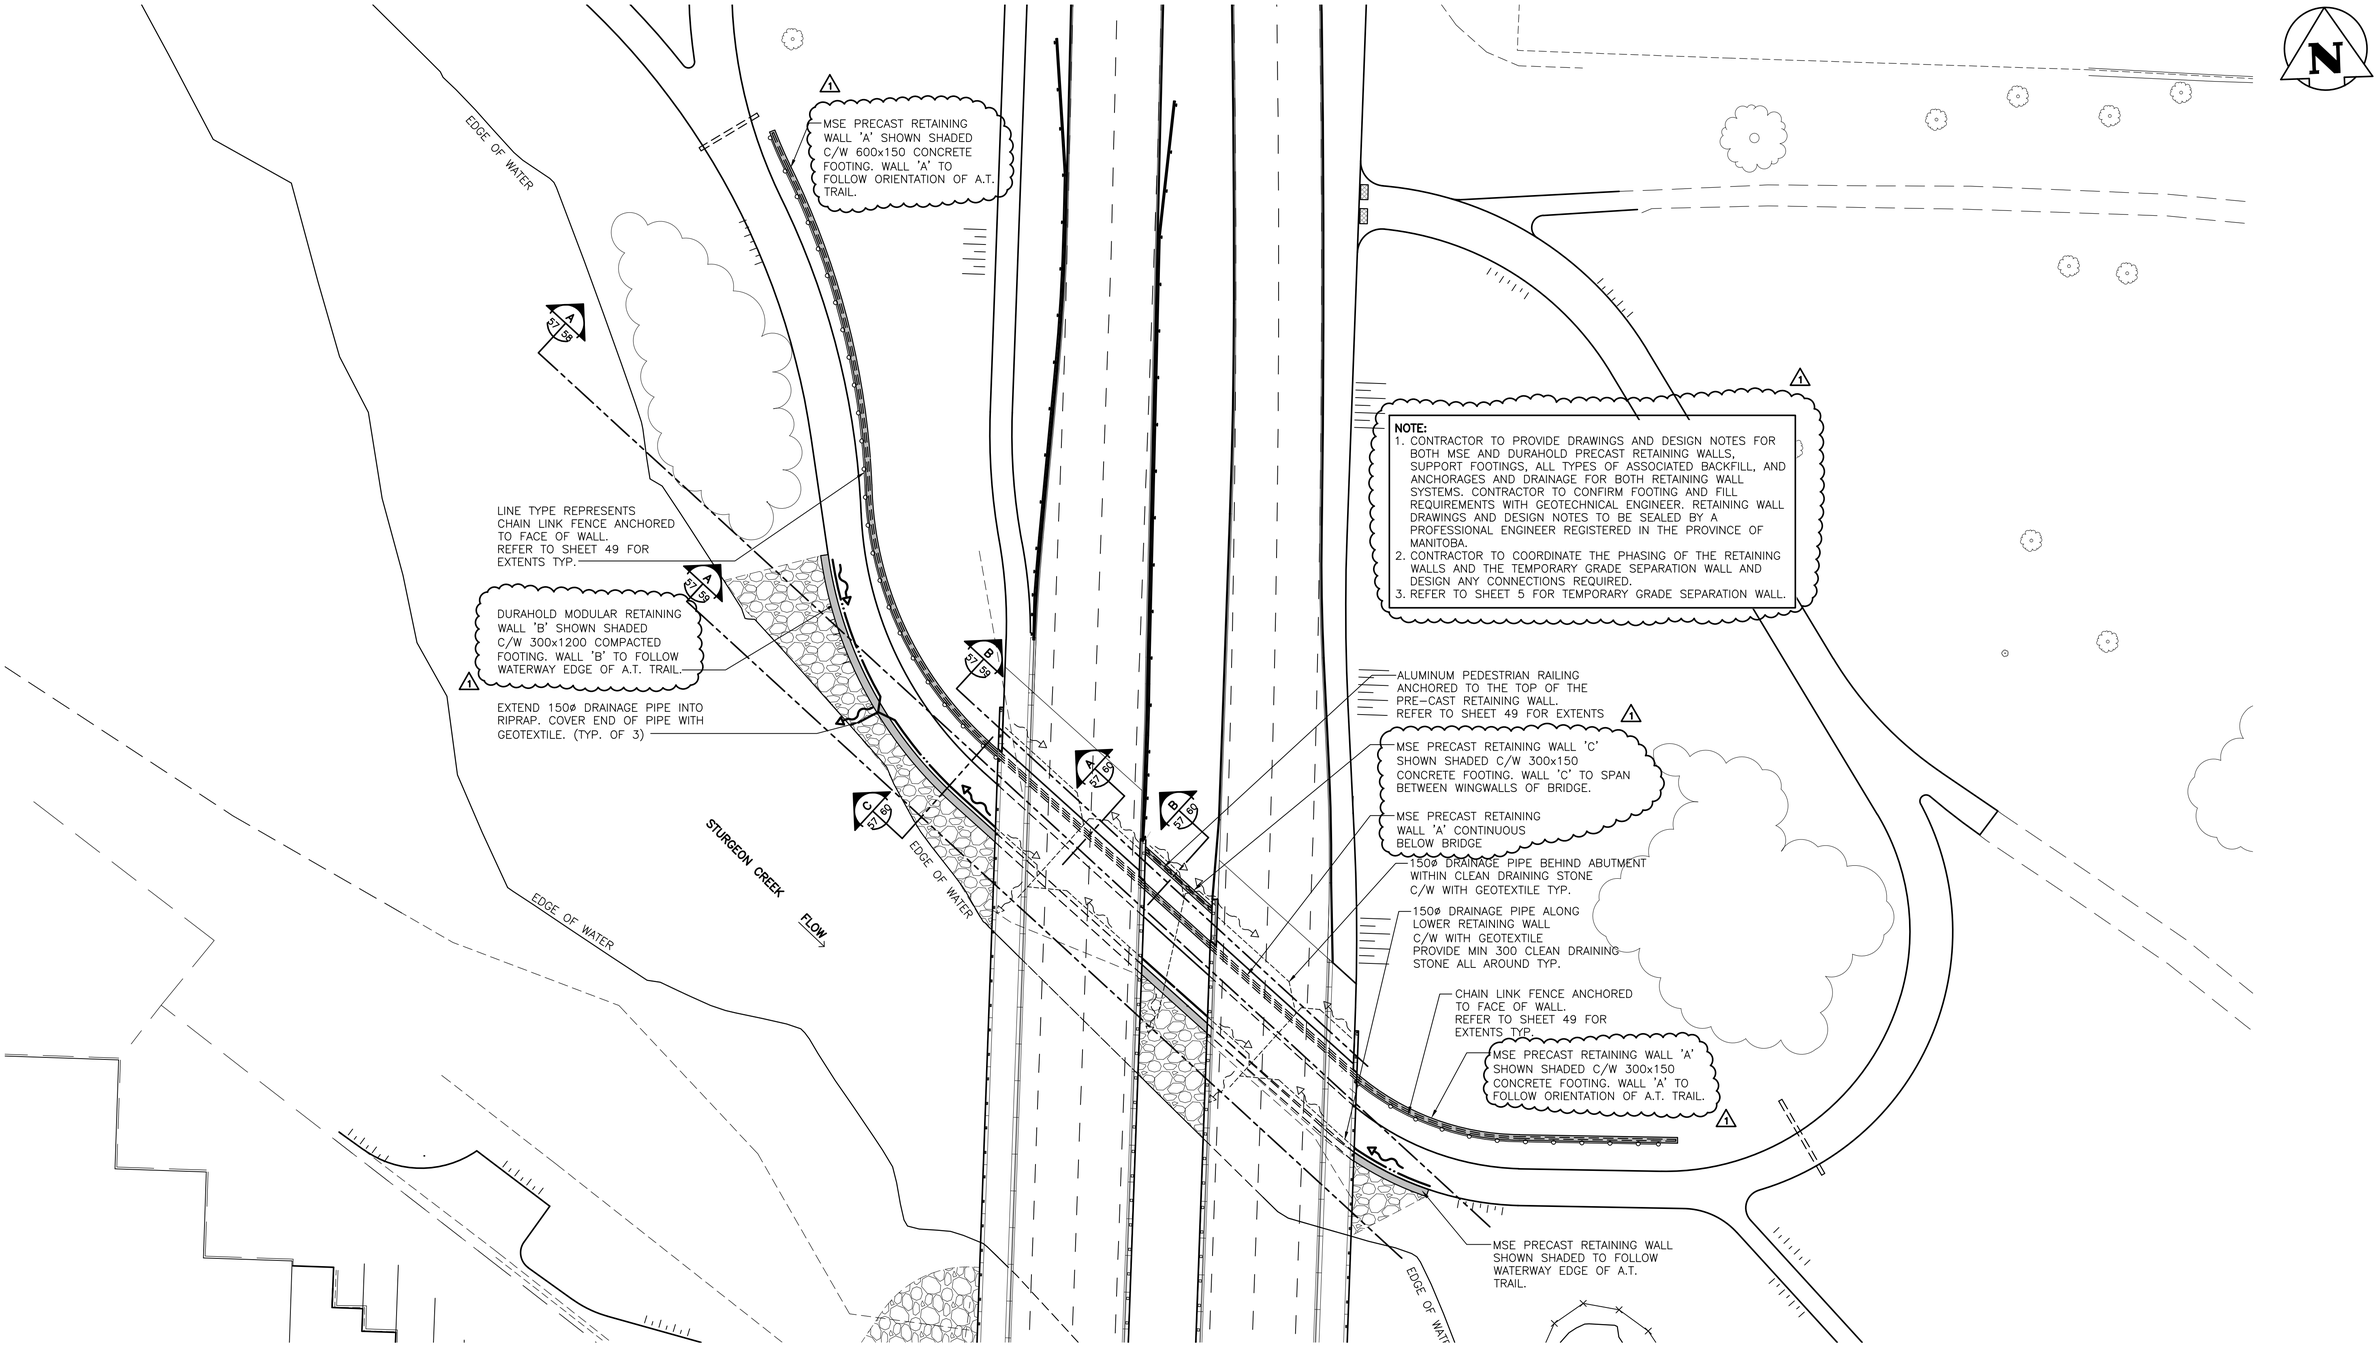

RETAINING WALL LAYOUT – NORTH EMBANKMENT

APEGM
Certificate of Authorization
Stantec Consulting Ltd.
No. 1301 Date:_____

METRIC
WHOLE NUMBERS INDICATE MILLIMETRES
DECIMALIZED NUMBERS INDICATE METRES

LOCATION APPROVED
UNDERGROUND STRUCTURES

SUPV. U/G STRUCTURES COMMITTEE _____ DATE _____

NOTE:
LOCATION OF UNDERGROUND STRUCTURES AS SHOWN ARE BASED ON THE BEST INFORMATION AVAILABLE BUT NO GUARANTEE IS GIVEN THAT ALL EXISTING UTILITIES ARE SHOWN OR THAT THE GIVEN LOCATIONS ARE EXACT. CONFIRMATION OF EXISTENCE AND EXACT LOCATION OF ALL SERVICES MUST BE OBTAINED FROM THE INDIVIDUAL UTILITIES BEFORE PROCEEDING WITH CONSTRUCTION.

B.M.
ELEV.

NO.	REVISIONS	DATE	BY
1	REVISED PER ADDENDUM No.1	12.01.18	K.S.A.
0	ISSUED FOR TENDER	11.12.15	K.S.A.

Stantec Consulting Ltd.
905 Waverley Street, Winnipeg, Manitoba
Tel 204-489-5900 Fax 204-453-9012

DESIGNED BY	K.S.A.	CHECKED BY	K.S.A.
DRAWN BY	V.J.F.	APPROVED BY	B.J.W.
HOR. SCALE:	1:250	RELEASED FOR CONSTRUCTION:	
VERTICAL:			
DATE	DEC. 15, 2011	DATE	

ENGINEER'S SEAL

CONSULTANT DRAWING NO.
S-801

THE CITY OF WINNIPEG
PUBLIC WORKS DEPARTMENT
ENGINEERING DIVISION

STURGEON ROAD
BRIDGE REPLACEMENT
PORTAGE AVENUE TO HALLONQUIST DRIVE
NORTH BANK MODULAR BLOCK RETAINING WALL LAYOUT

SHEET 57 OF 82
CAD FILE DRAWING NUMBER 31590s-801-767.dwg
CITY DRAWING NUMBER B120-12-057

V:\1137\active\113731590\drawing\403_addenda\sheet_files\bridge\31590s-801-767.dwg
Date: 2012 Jan 16 5:42pm Login: Beernaerts, James