


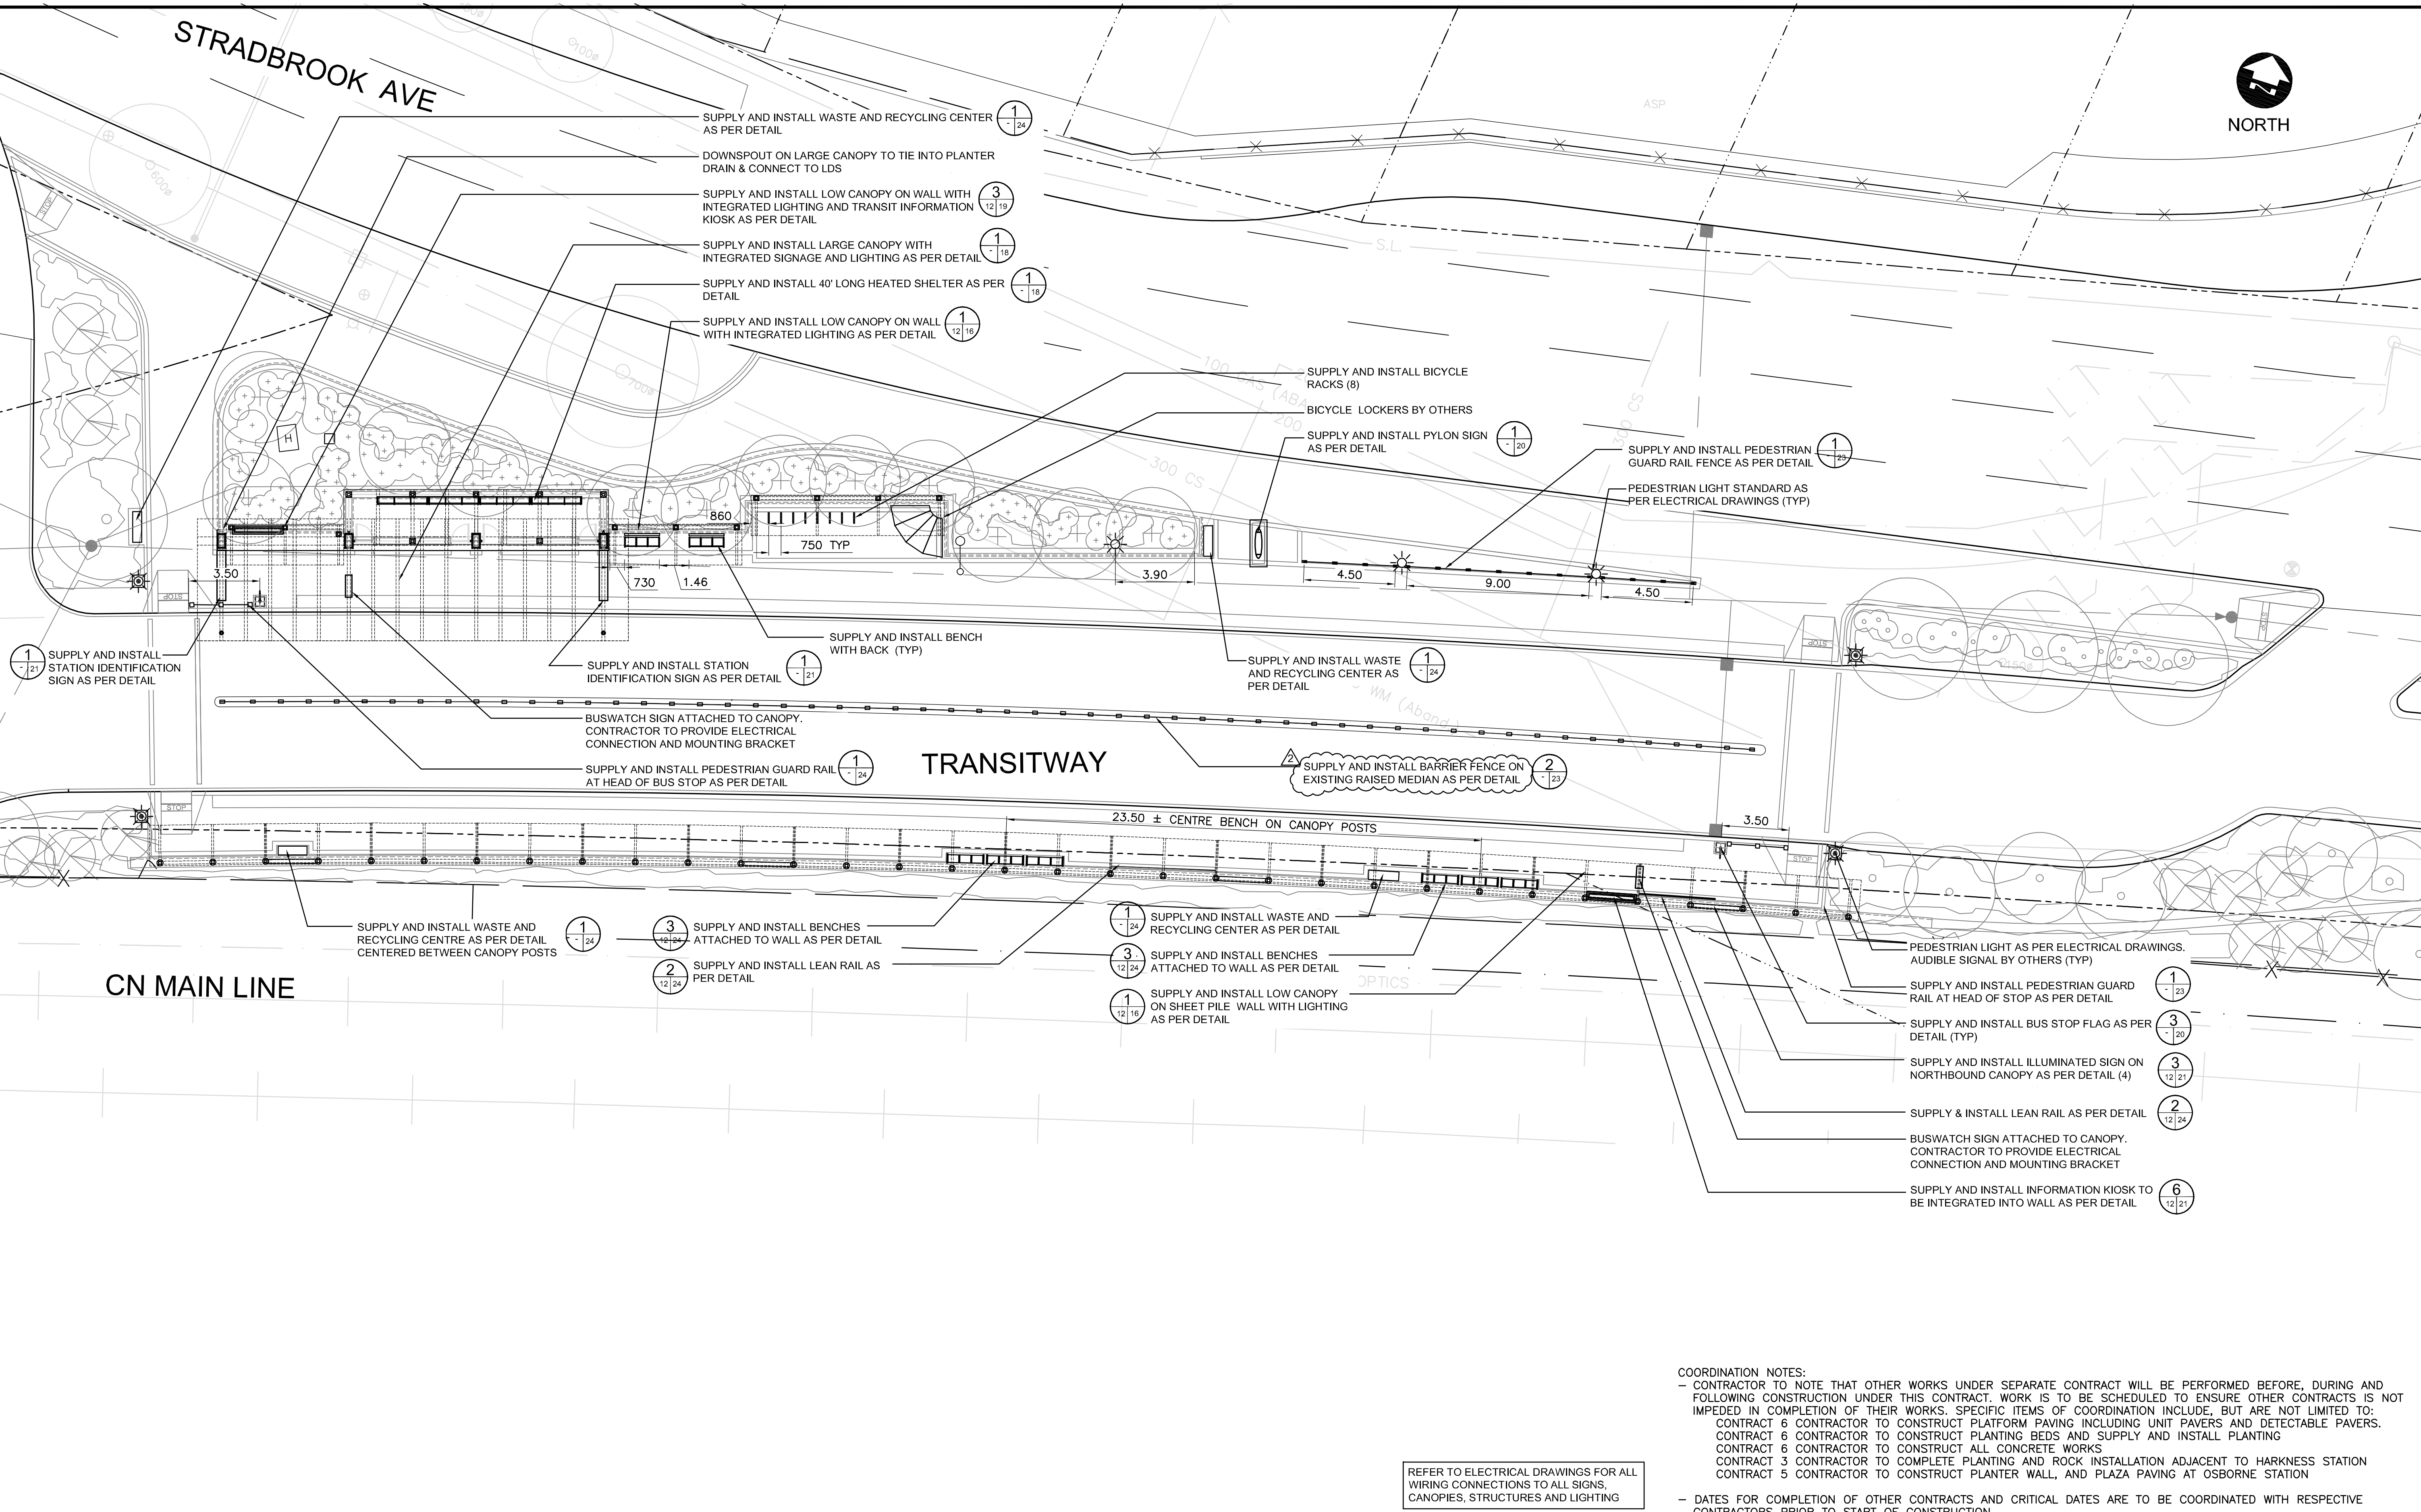

STRADBROOK AVE



COORDINATION NOTES:  
 - CONTRACTOR TO NOTE THAT OTHER WORKS UNDER SEPARATE CONTRACT WILL BE PERFORMED BEFORE, DURING AND FOLLOWING CONSTRUCTION UNDER THIS CONTRACT. WORK IS TO BE SCHEDULED TO ENSURE OTHER CONTRACTS IS NOT IMPEDED IN COMPLETION OF THEIR WORKS. SPECIFIC ITEMS OF COORDINATION INCLUDE, BUT ARE NOT LIMITED TO:  
 CONTRACT 6 CONTRACTOR TO CONSTRUCT PLATFORM PAVING INCLUDING UNIT PAVERS AND DETECTABLE PAVERS.  
 CONTRACT 6 CONTRACTOR TO CONSTRUCT PLANTING BEDS AND SUPPLY AND INSTALL PLANTING  
 CONTRACT 6 CONTRACTOR TO CONSTRUCT ALL CONCRETE WORKS  
 CONTRACT 3 CONTRACTOR TO COMPLETE PLANTING AND ROCK INSTALLATION ADJACENT TO HARKNESS STATION  
 CONTRACT 5 CONTRACTOR TO CONSTRUCT PLANTER WALL, AND PLAZA PAVING AT OSBORNE STATION  
 - DATES FOR COMPLETION OF OTHER CONTRACTS AND CRITICAL DATES ARE TO BE COORDINATED WITH RESPECTIVE CONTRACTORS PRIOR TO START OF CONSTRUCTION.

REFER TO ELECTRICAL DRAWINGS FOR ALL WIRING CONNECTIONS TO ALL SIGNS, CANOPIES, STRUCTURES AND LIGHTING

X:\08-028 Southwestern BRT Corridor\dwg\2010\Contract 7\TENDER SET\Workarea Station Furniture 2011-04-11.dwg

LOCATION UNDERGROUND APPROVED STRUCTURES SUPV. U/G STRUCTURES COMMITTEE DATE NOTE: LOCATION OF UNDERGROUND STRUCTURES AS SHOWN ARE BASED ON THE BEST INFORMATION AVAILABLE, BUT NO GUARANTEE IS GIVEN THAT ALL EXISTING UTILITIES ARE SHOWN OR THAT THE GIVEN LOCATIONS ARE EXACT. CONFIRMATION OF EXISTENCE AND EXACT LOCATION OF ALL SERVICES MUST BE OBTAINED FROM THE INDIVIDUAL UTILITIES BEFORE PROCEEDING WITH CONSTRUCTION.	B.M. ELEV. BM ELEV. DESIGNED BY SR/JW DRAWN BY MD CHECKED BY JW/SR APPROVED BY HOR. SCALE 1:150 VERTICAL RELEASED FOR CONSTRUCTION ORIGINAL SIGNED BY RANDY FINGAS DATE: APRIL 20, 2011	LANDSCAPE ARCHITECT'S SEAL  CONSULTANT PROJECT NO. 08-028	<b>THE CITY OF WINNIPEG</b> <b>TRANSIT DEPARTMENT</b> SOUTHWEST RAPID TRANSIT CORRIDOR - STAGE 1 STATION CONSTRUCTION, WARSAW RECONSTRUCTION & ASSOCIATED WORKS HARKNESS STATION SITE FURNITURE AND STRUCTURES LAYOUT	CITY DRAWING NUMBER P-3325-12 SHEET 12 OF 28 CONSULTANT DRAWING NUMBER C7-L-5001-T-R1
2 ADDENDUM 1 10/05/11 JW 1 ISSUED FOR TENDER 20/04/11 JW NO. REVISIONS DATE BY DATE 2011-04-20				