




VALVE SYMBOLS

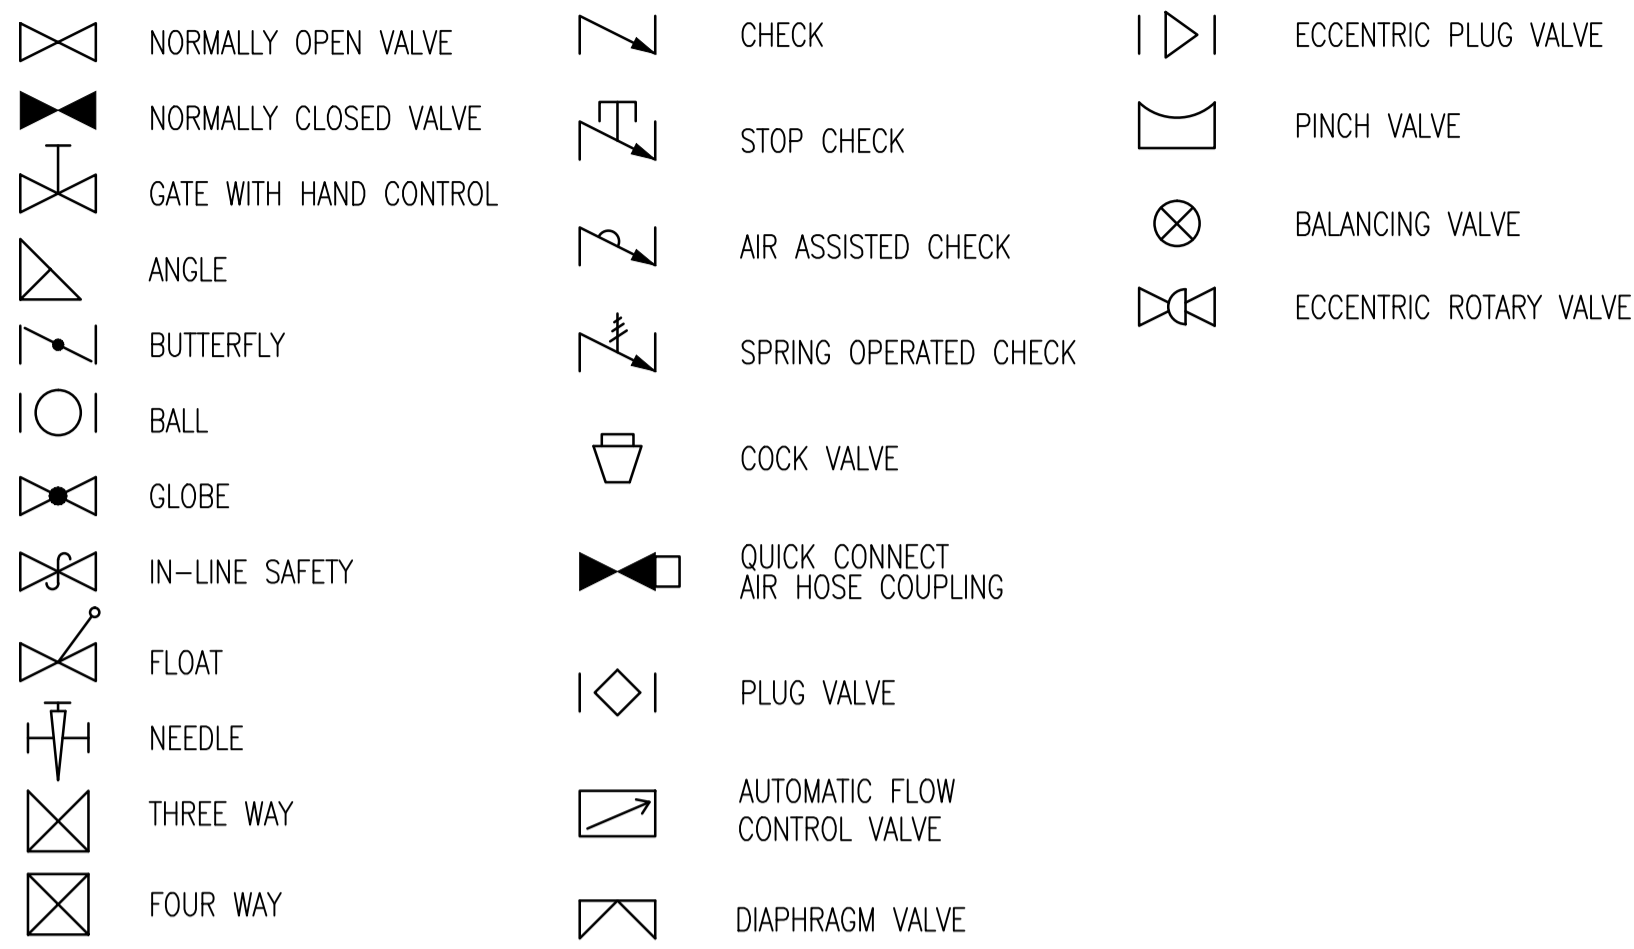


GATE SYMBOLS

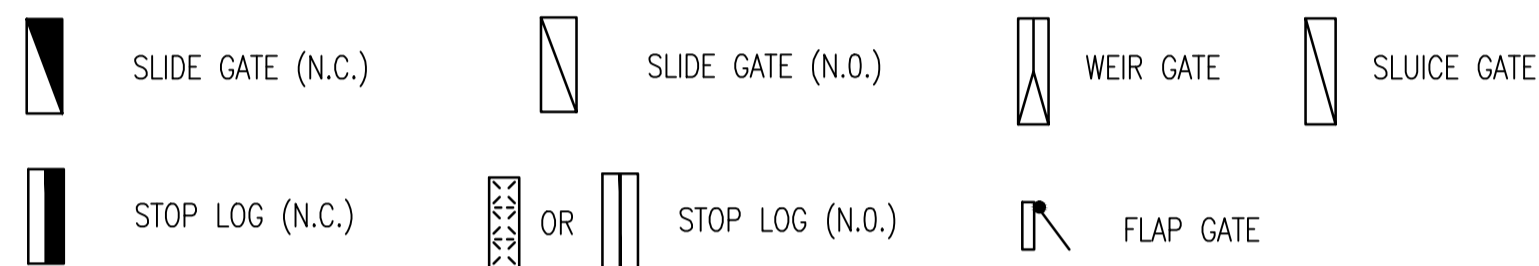


INSTRUMENT SYMBOLS

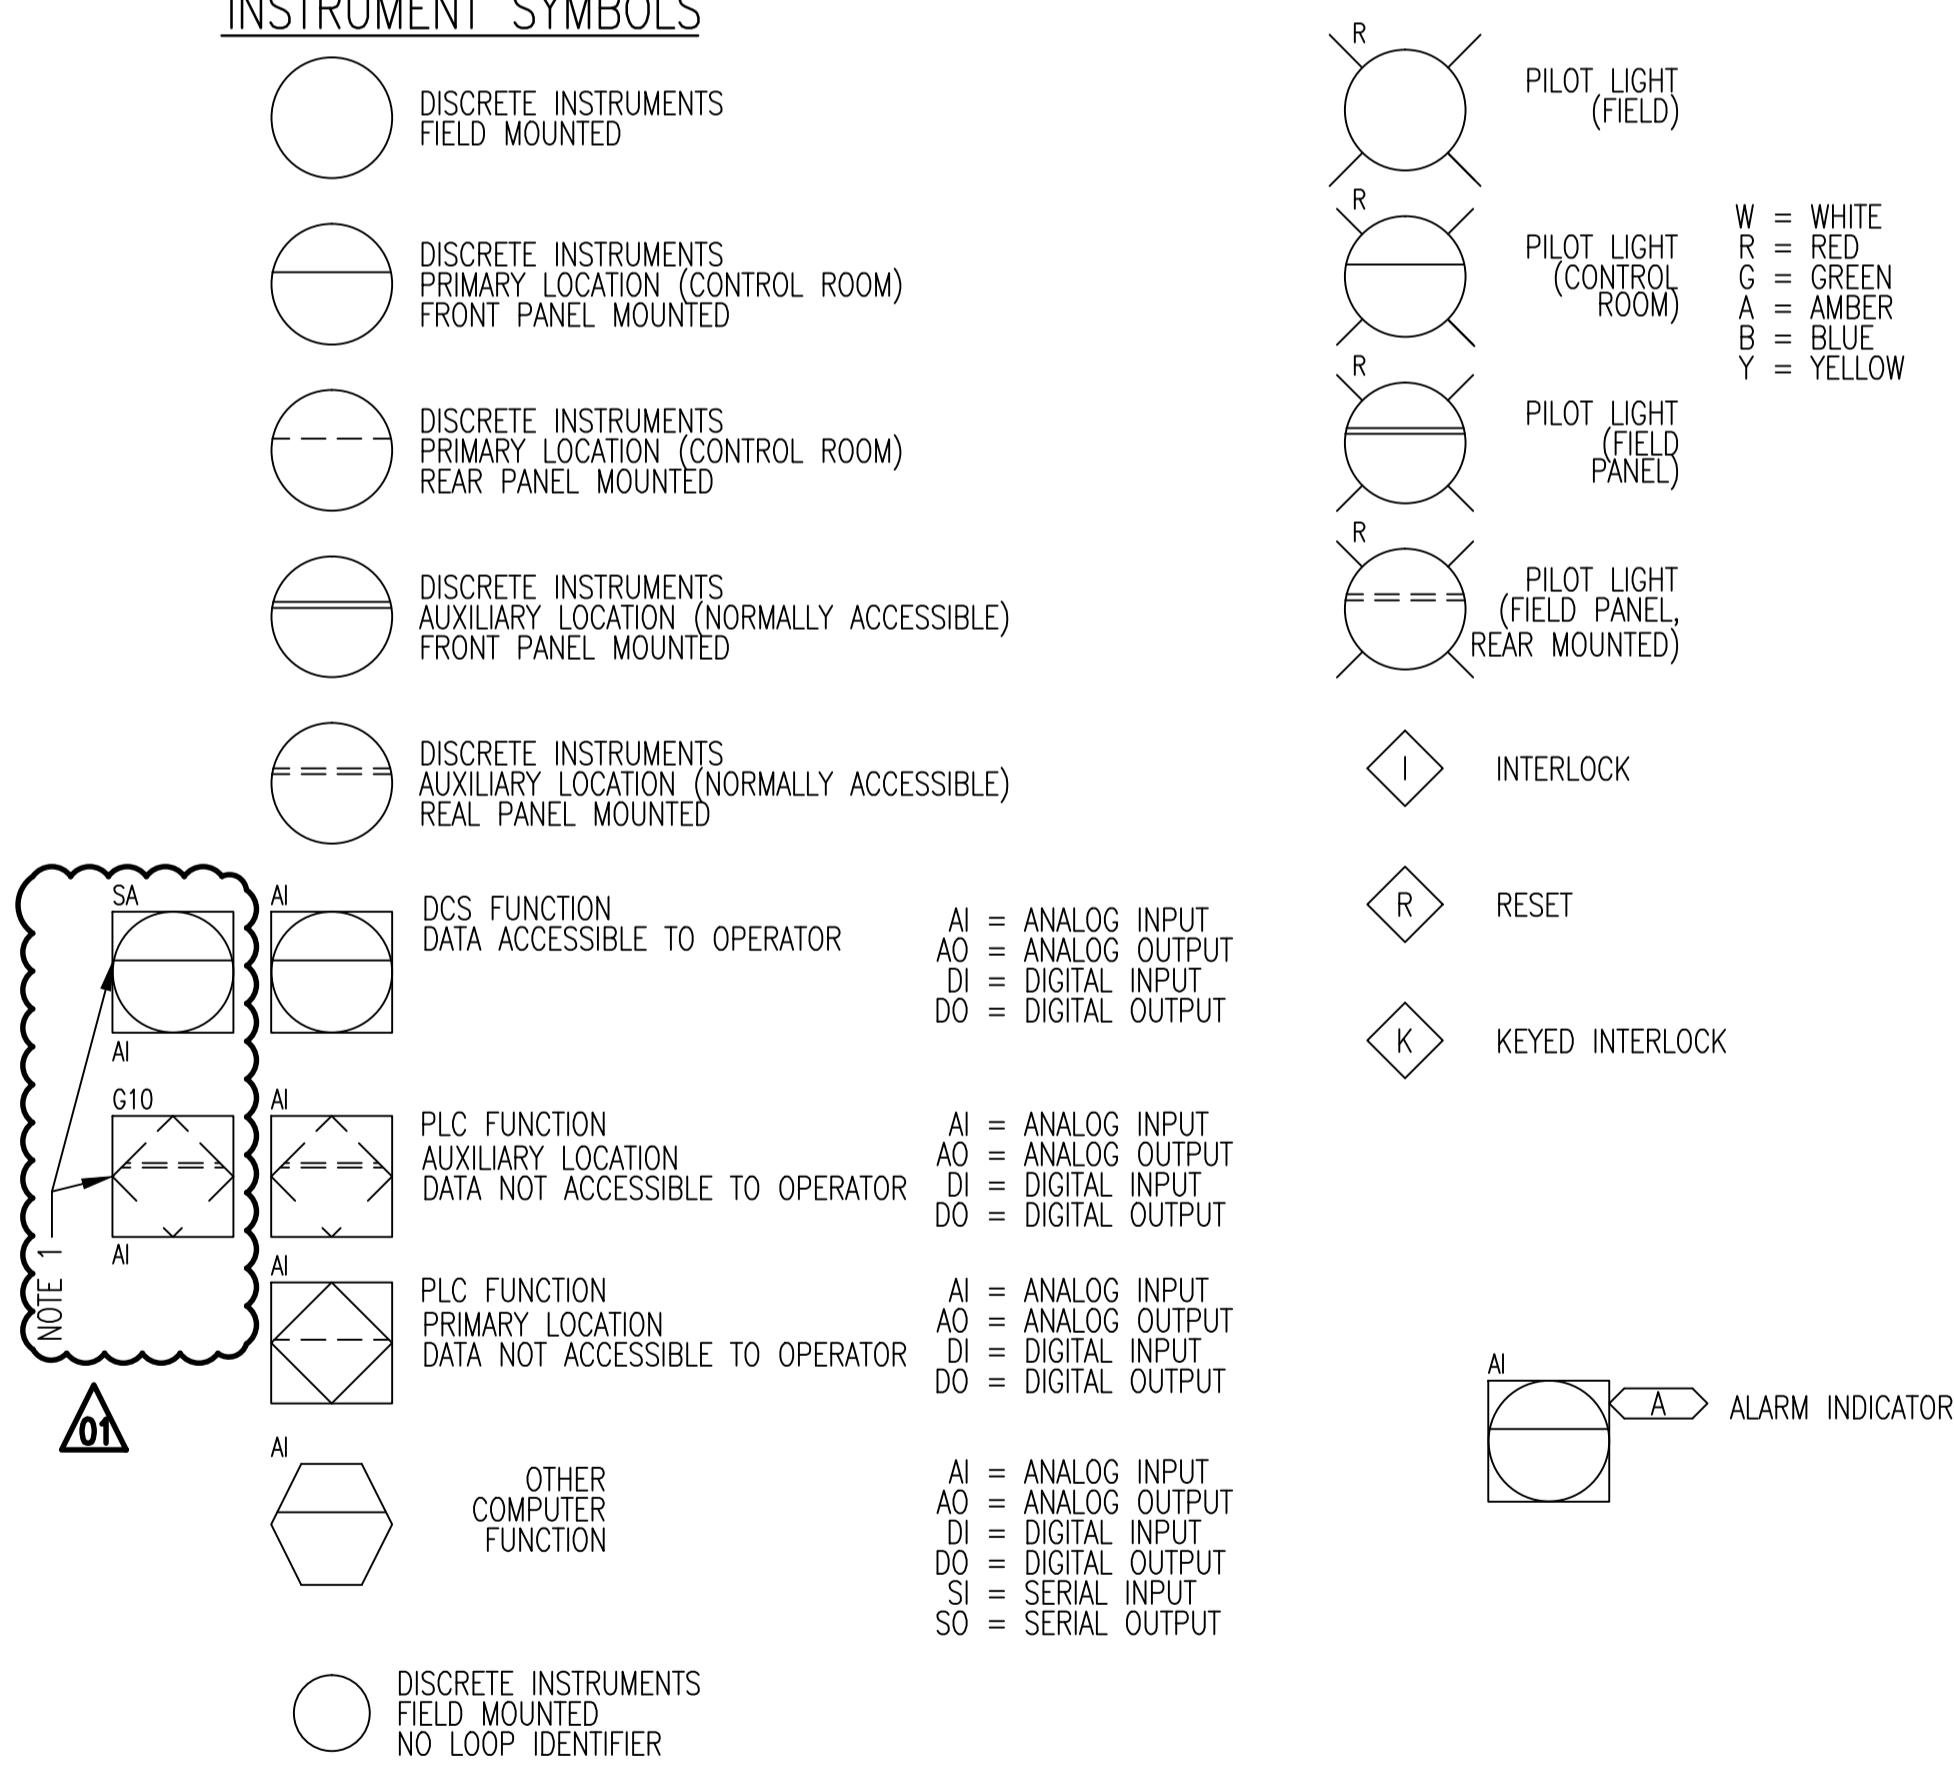


ACTUATOR SYMBOLS

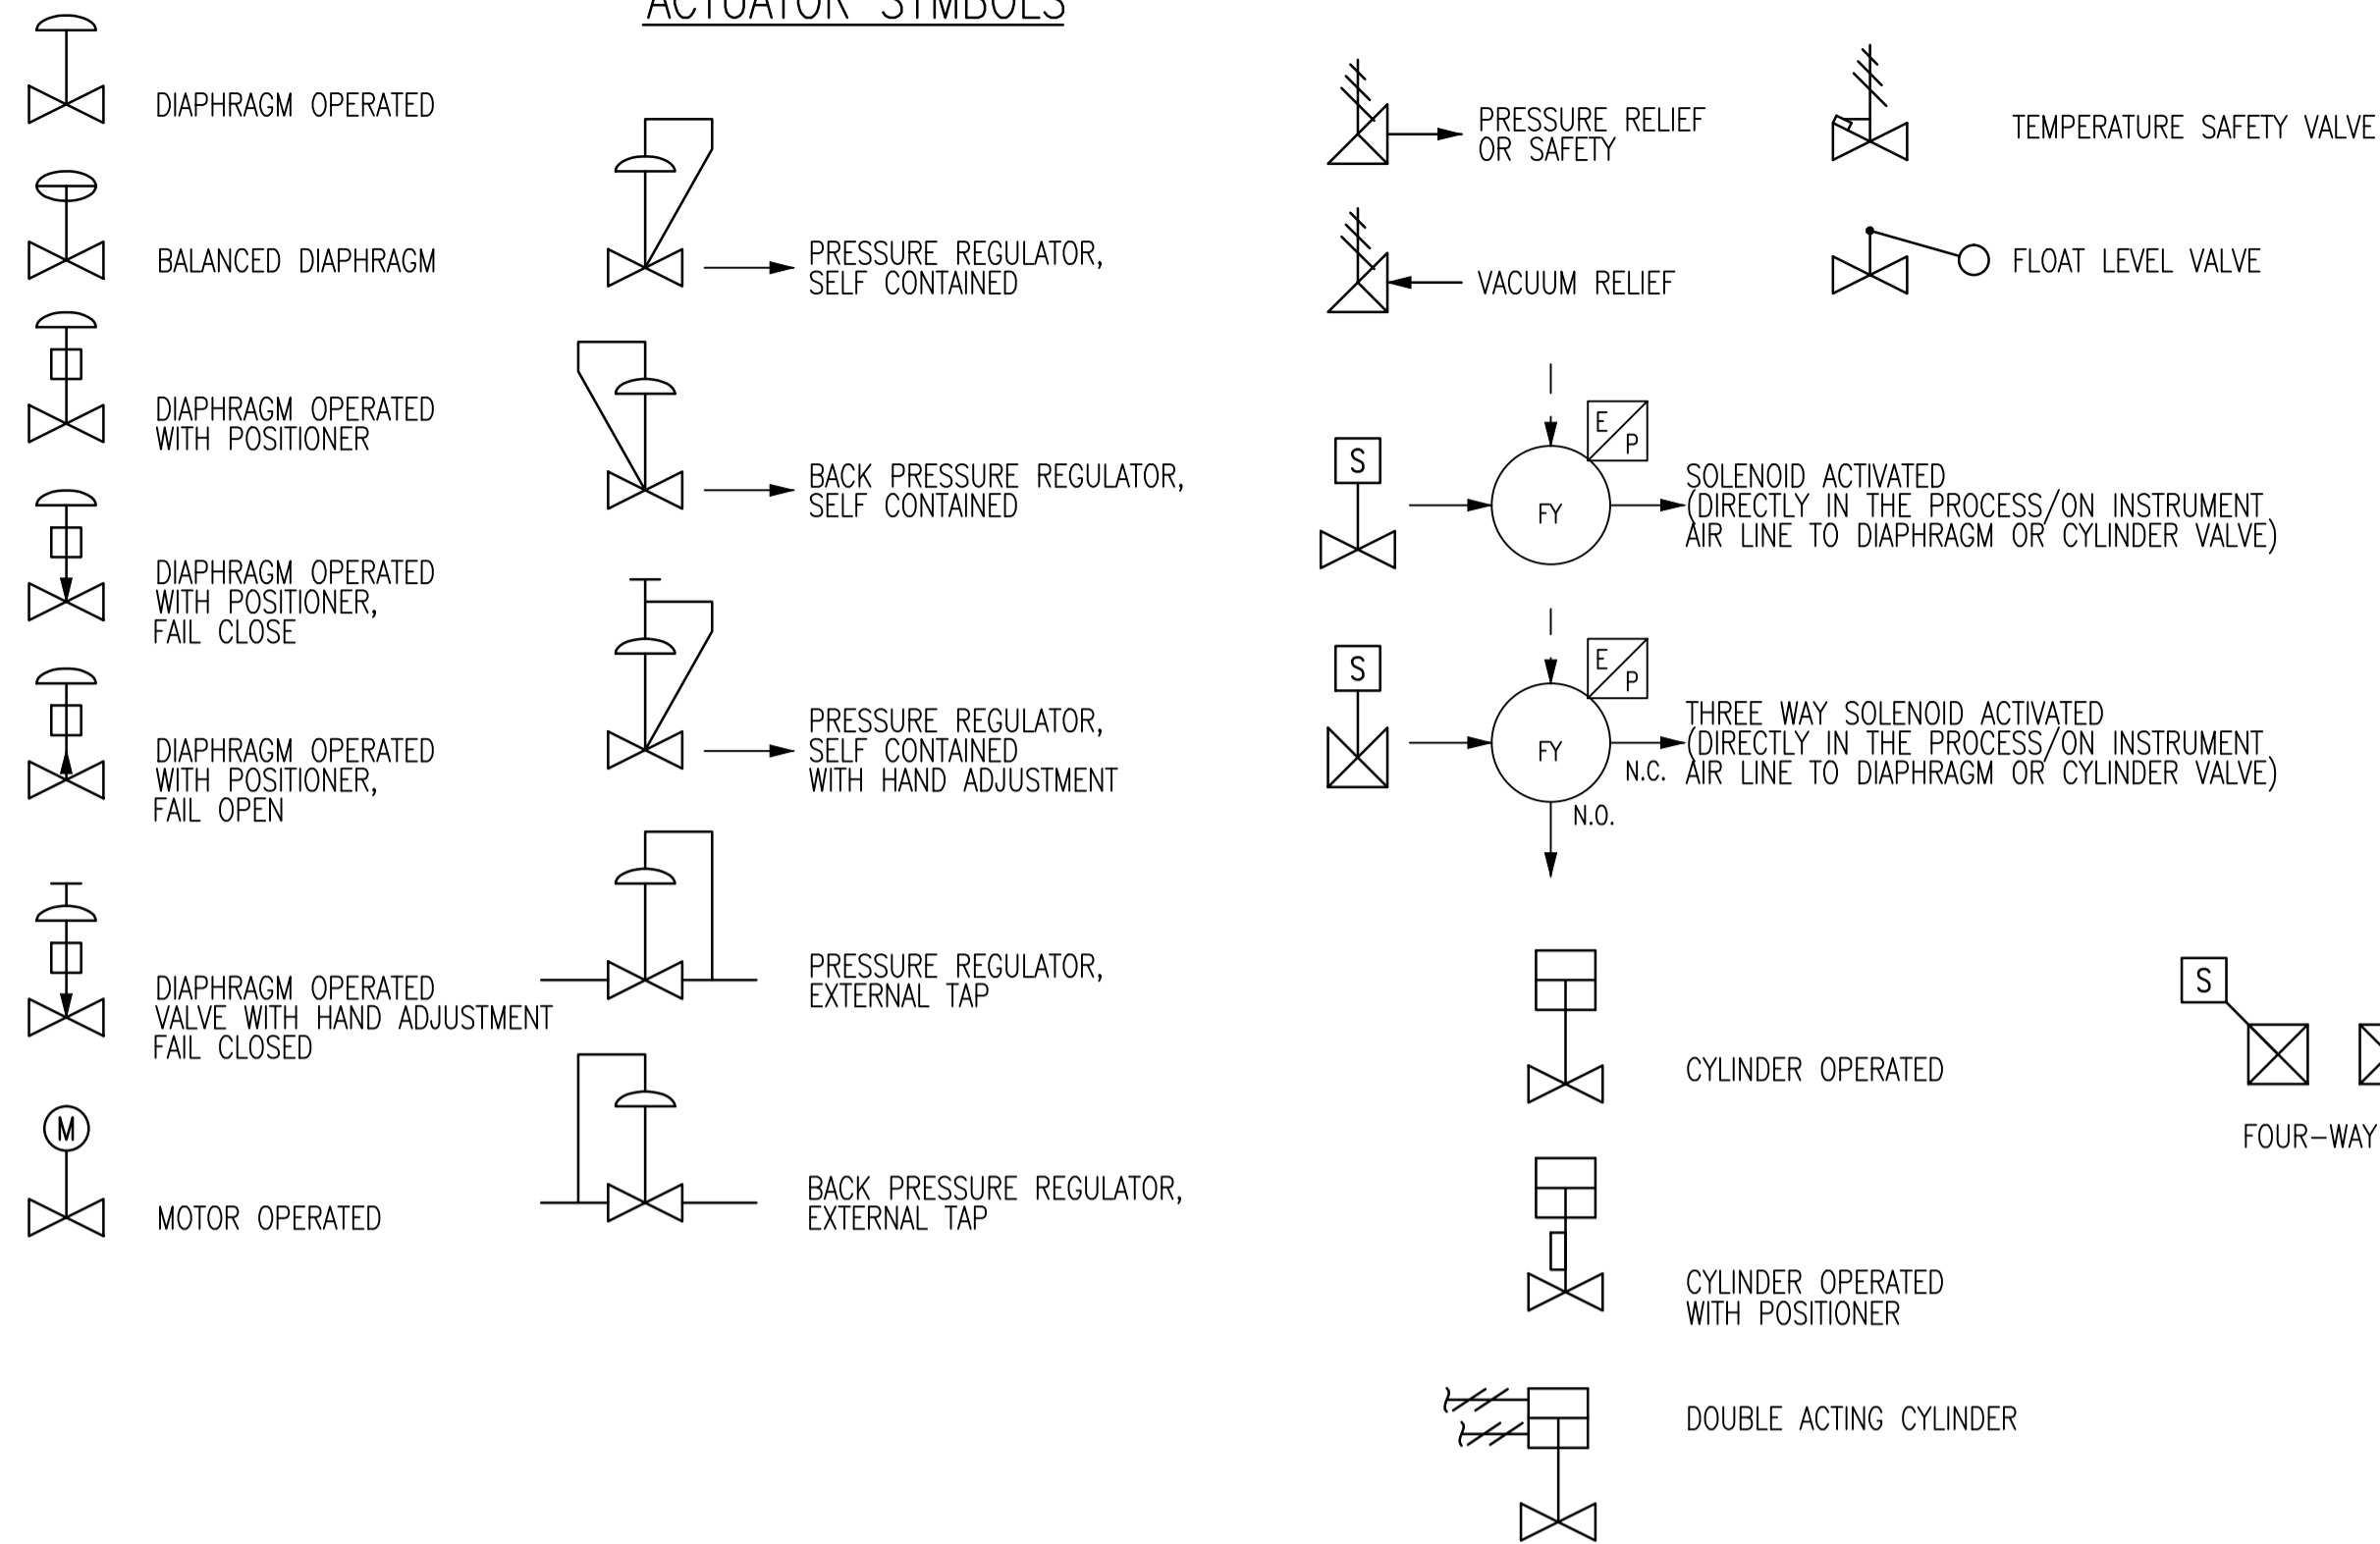

INSTRUMENT LINE SYMBOLS

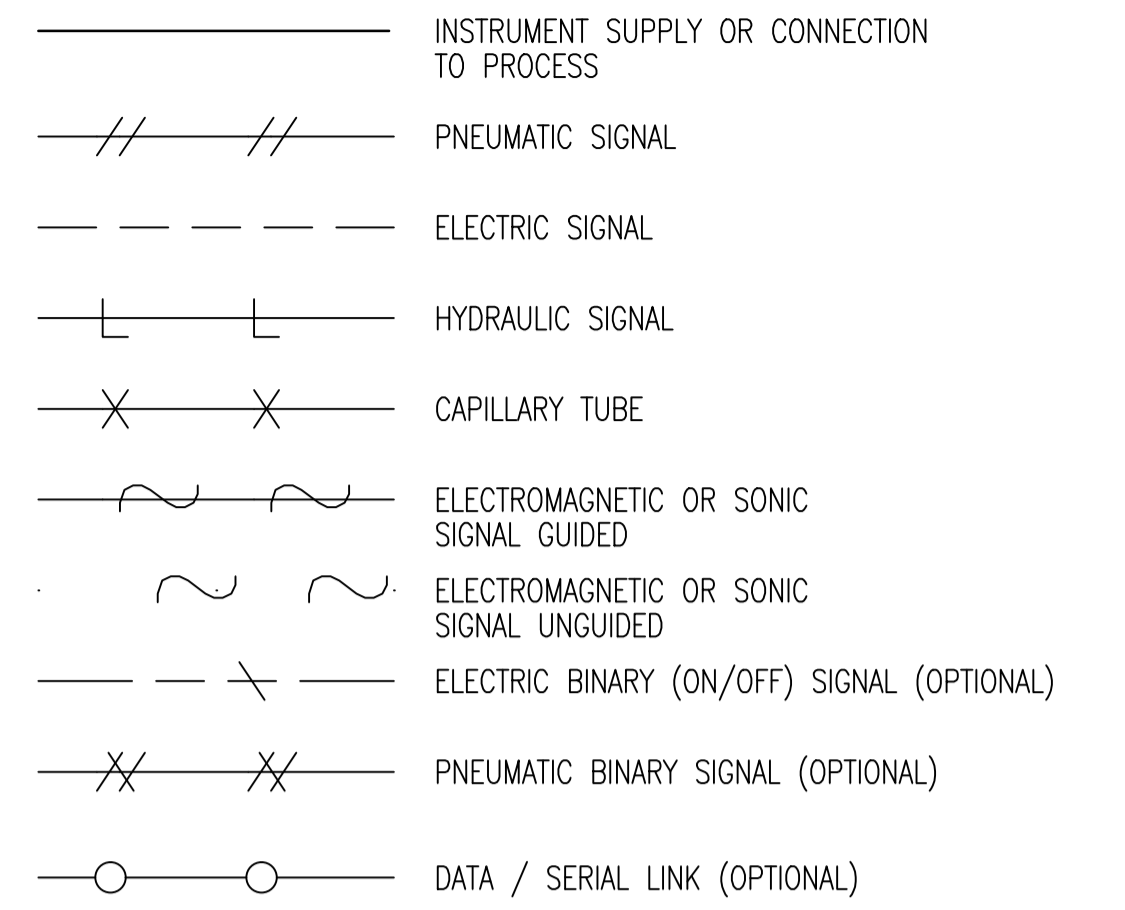

CONNECTING ARROWS

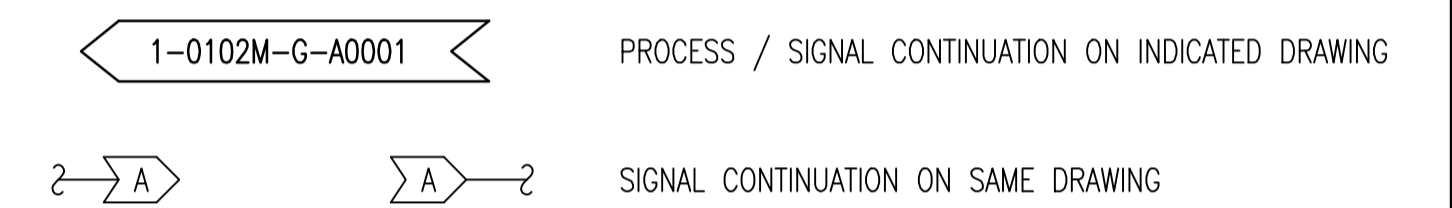

ACCESSORY DEVICE SYMBOLS

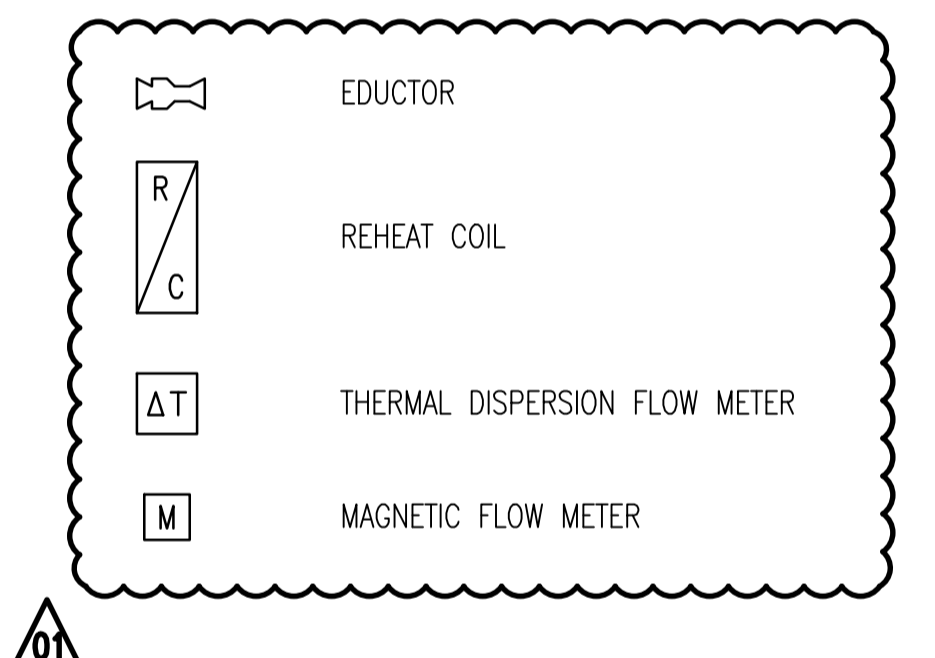
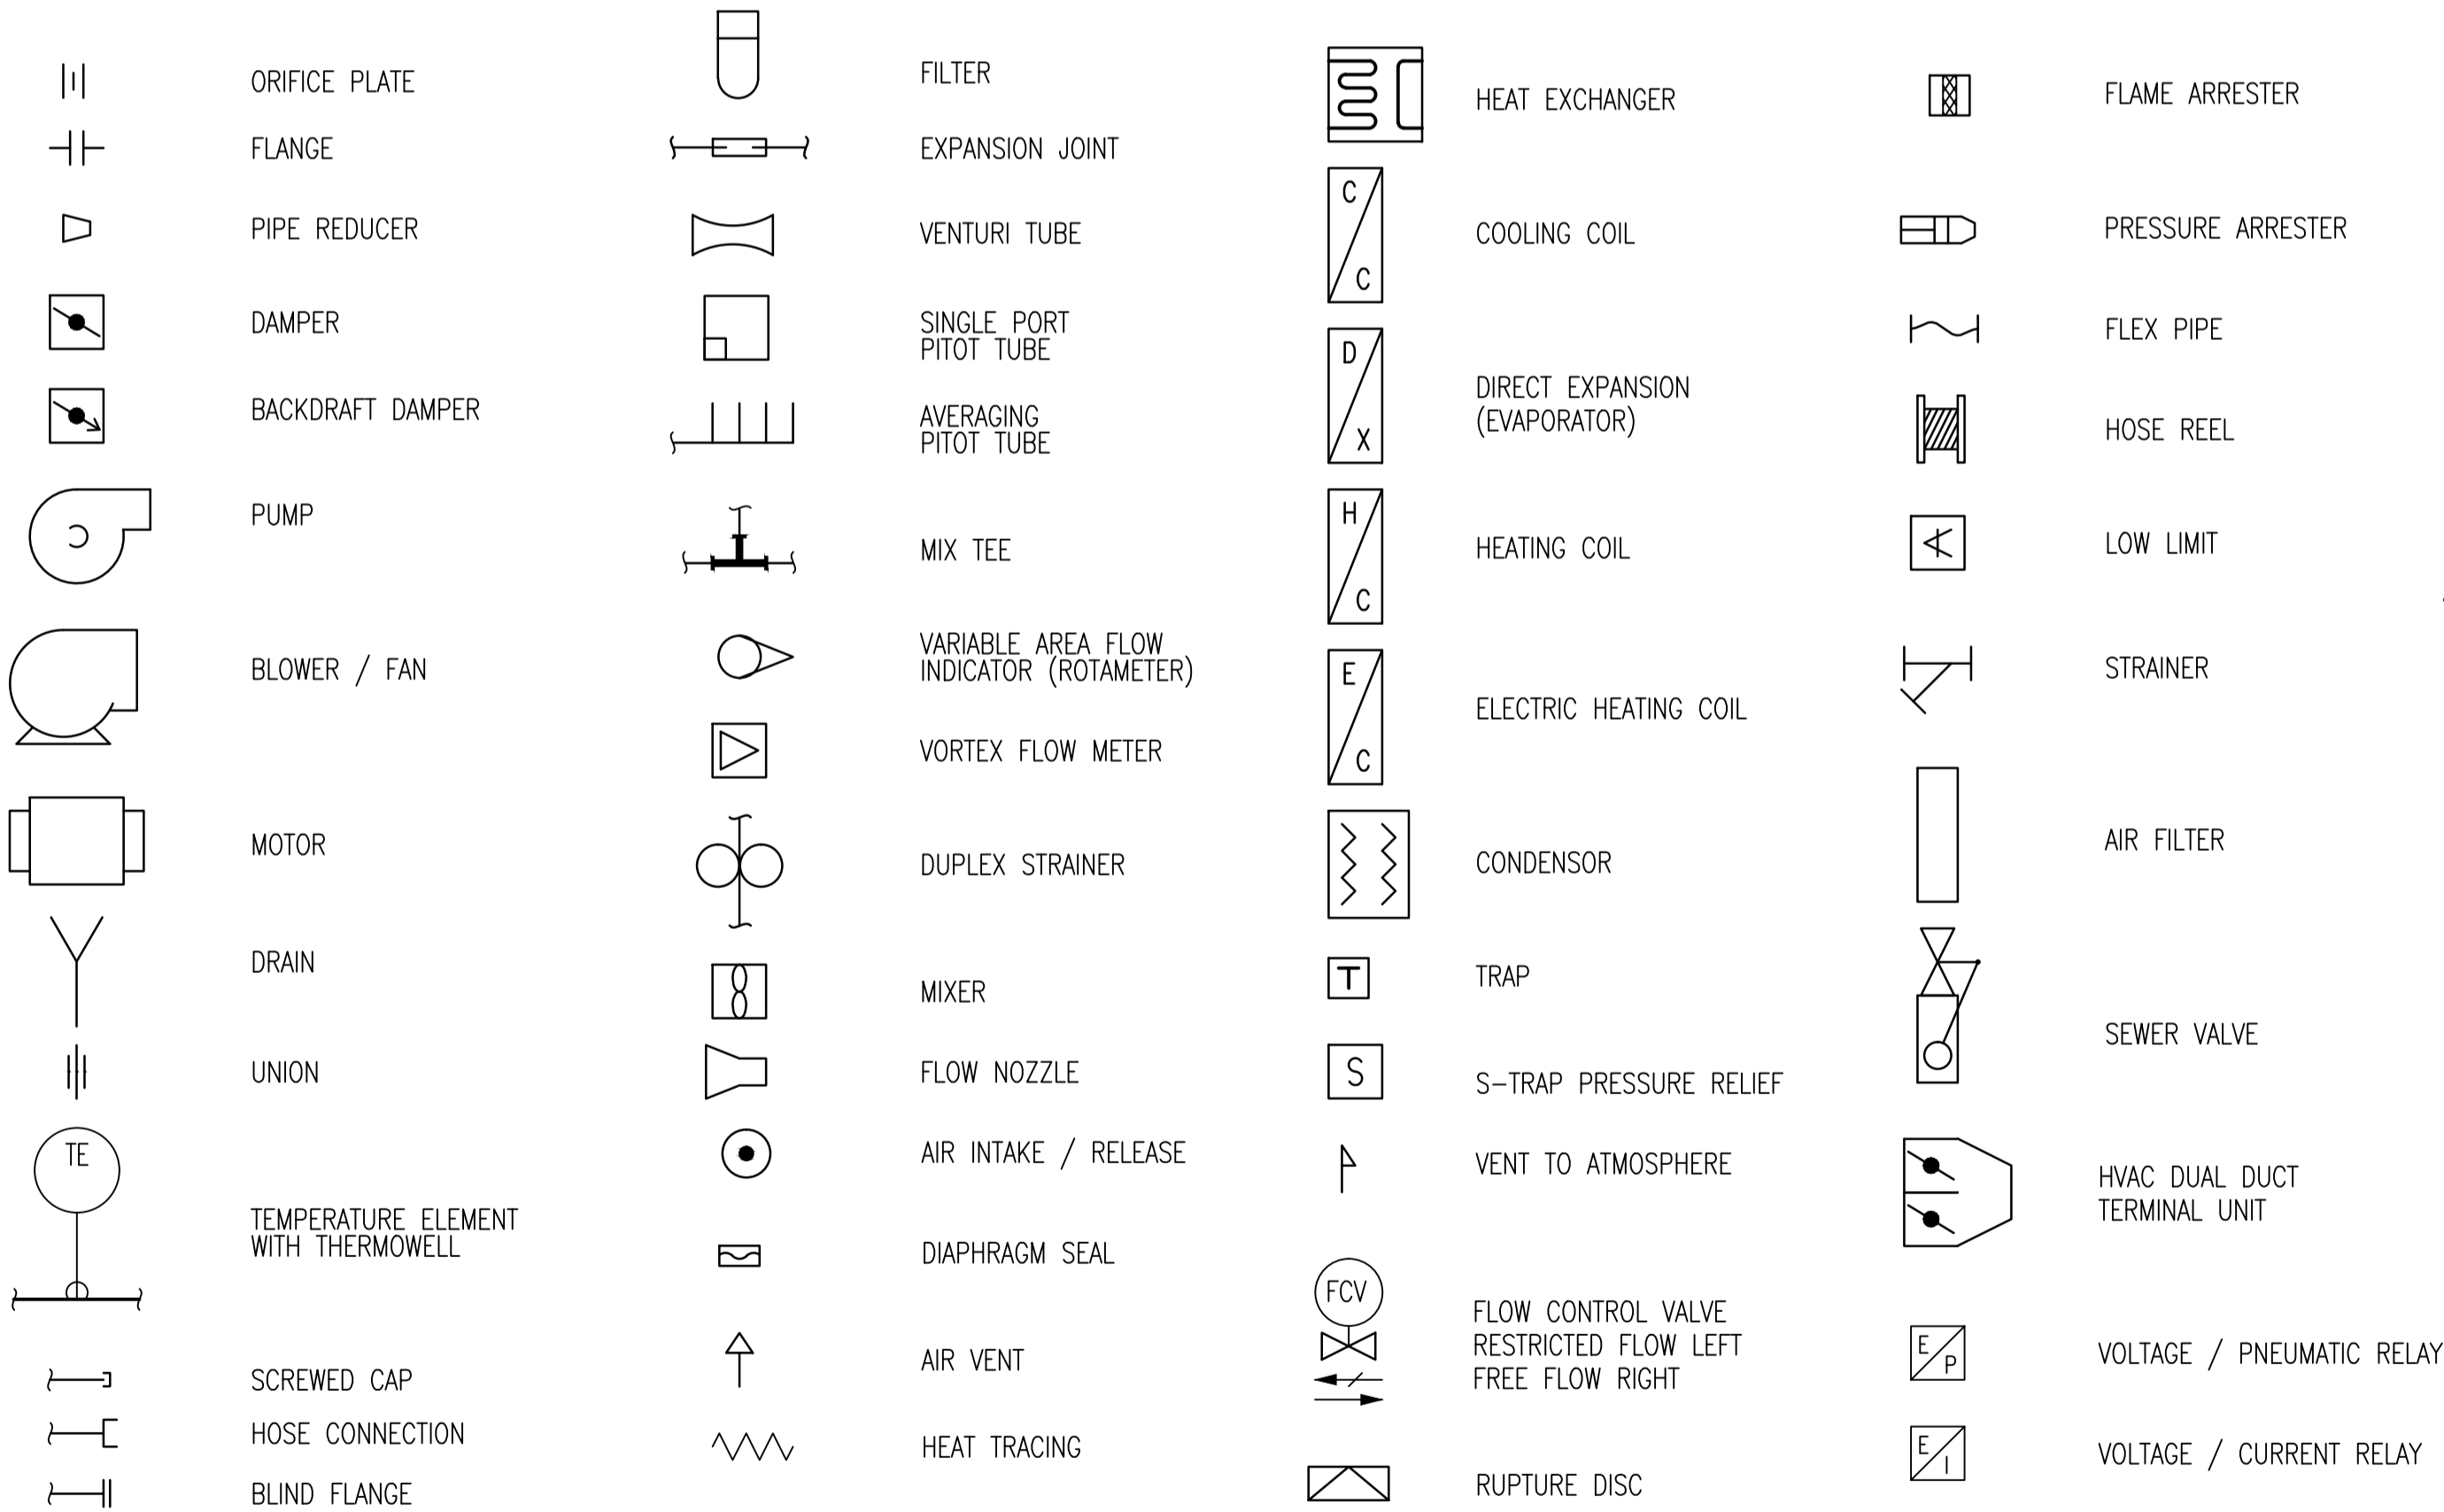


Table with 2 columns: DRAWING NUMBER, REFERENCE DRAWINGS

APECM Certificate of Authorization, SNC-Lavalin Inc. No. 4489

Table with columns: NO., REVISIONS, DATE, DESIGN, CHECK

SNC-Lavalin Inc. logo and contact information, project details

FOR REFERENCE ONLY

THE CITY OF WINNIPEG WATER AND WASTE DEPARTMENT, SOUTH END WATER POLLUTION CONTROL CENTRE, PROCESS AND INSTRUMENT DIAGRAMS LEGEND AND DETAILS