


FROM MAIN DISTRIBUTION
IN AREA 'S'
1-0102S-A0051 AC 600V

FROM MAIN DISTRIBUTION
IN AREA 'S'
1-0102S-A0051 AC 600V

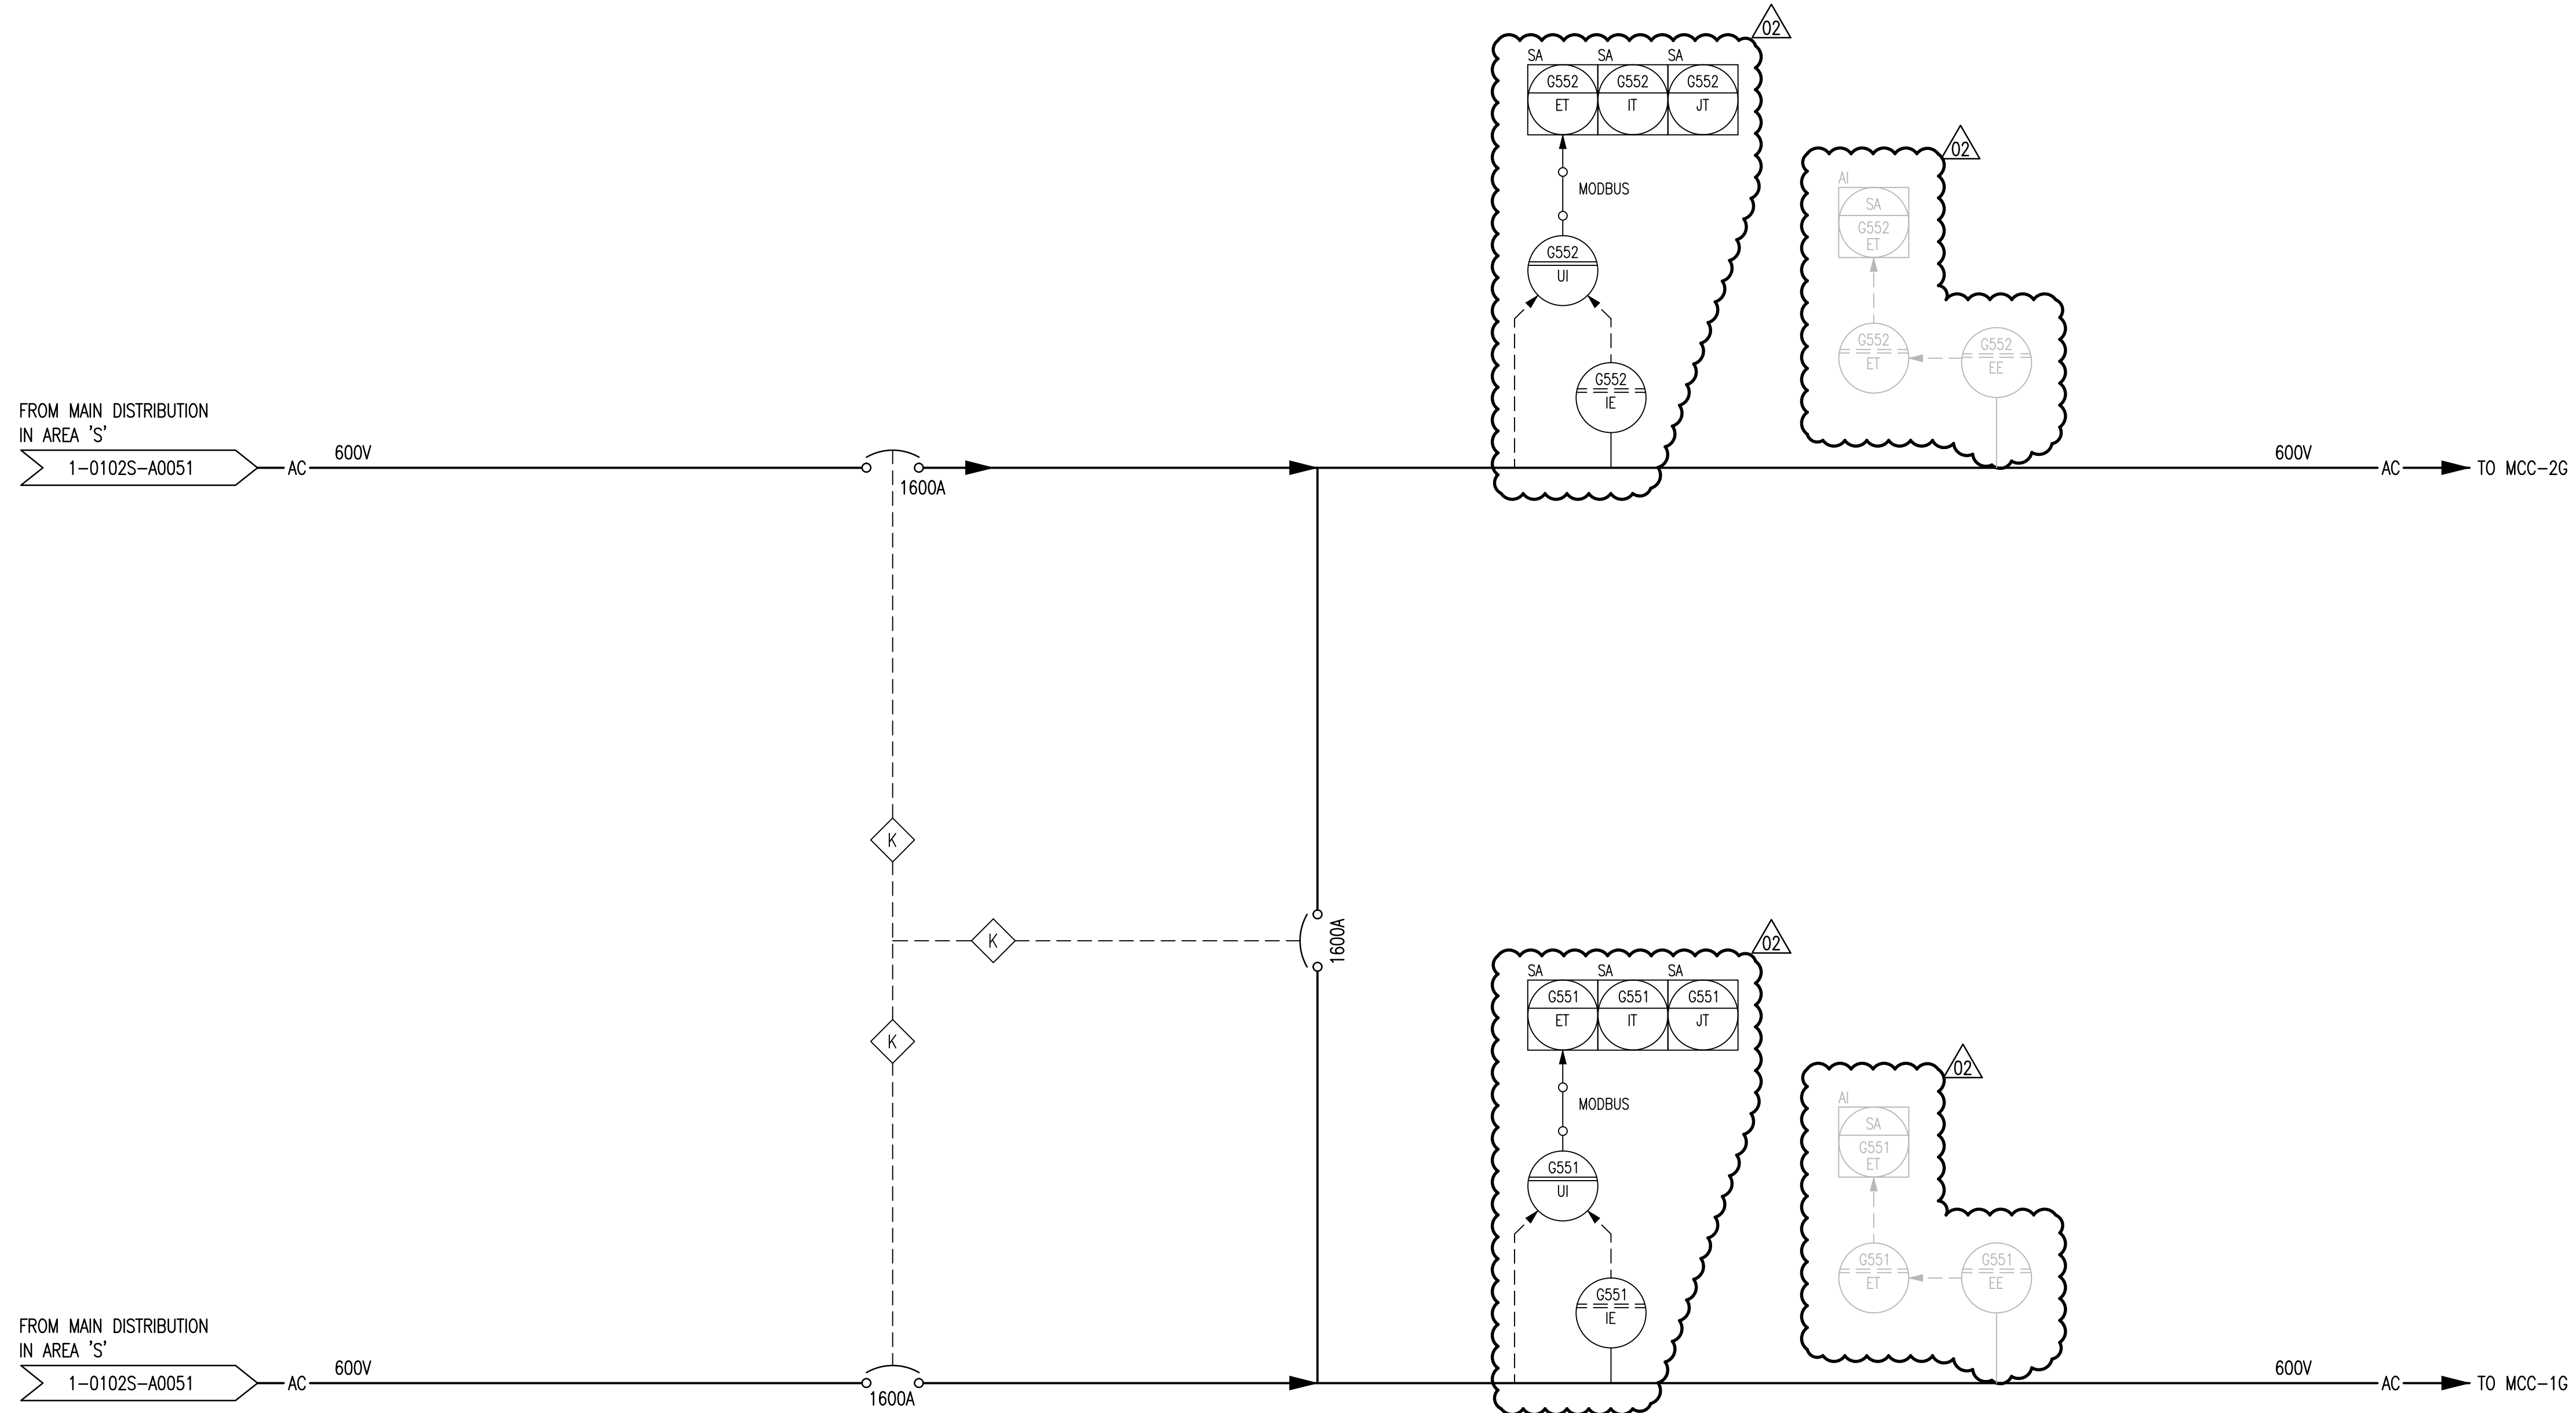

1-0102A-A0001	PROCESS & INSTRUMENT DIAGRAMS LEGEND & DETAILS
DRAWING NUMBER	REFERENCE DRAWINGS

APECM
Certificate of Authorization
SNC-Lavalin Inc.
No. 4489 Expiry: April 30, 2010

NO.	REVISIONS	DATE	DESIGN	CHECK
02	MODIFIED POWER METERING	2011/03/11	TMC	CJR
01	ADDED VOLTAGE ALARM TO DCS	2009/12/07	NB	CJR
00	ISSUED FOR CITY USE	2006/11/28	-	EFB

SNC-LAVALIN INC.
148 Nature Park Way
Winnipeg, MB, Canada R3P 0X7
204-786-8080

DESIGNED BY: EXISTING	CHECKED BY: EFB
DRAWN BY: DAH	APPROVED BY: CJR
SCALE: NTS	RELEASED FOR CONSTRUCTION BY: N. HARRINGTON
DATE: 2005/11/11	DATE: 2011/03/11
CONSULTANT NO.: 112577-0105-47DD-0125	

ENGINEER'S SEAL
ORIGINAL DRAWING
SEALED BY:
T. M. CHURCH
SNC-LAVALIN
MEMBER # 32682
2011/03/25
REV. 02
CHANGES ONLY

THE CITY OF WINNIPEG
WATER AND WASTE DEPARTMENT

SOUTH END WATER POLLUTION CONTROL CENTRE
PUMP & SCREEN BUILDING
PROCESS & INSTRUMENTATION DIAGRAM
ELECTRICAL DISTRIBUTION

CITY DRAWING NUMBER	SHEET	REV.	SIZE
1-0102G-A0037	001	02	A1