


B SIZE - 279mm x 432mm

LAST SAVE: 2011/03/29 - 12:21pm
 PATH: M:\112577\0106\4ENG\481&C\DD - General DWG\1-0102G-A0065-001-00.dwg

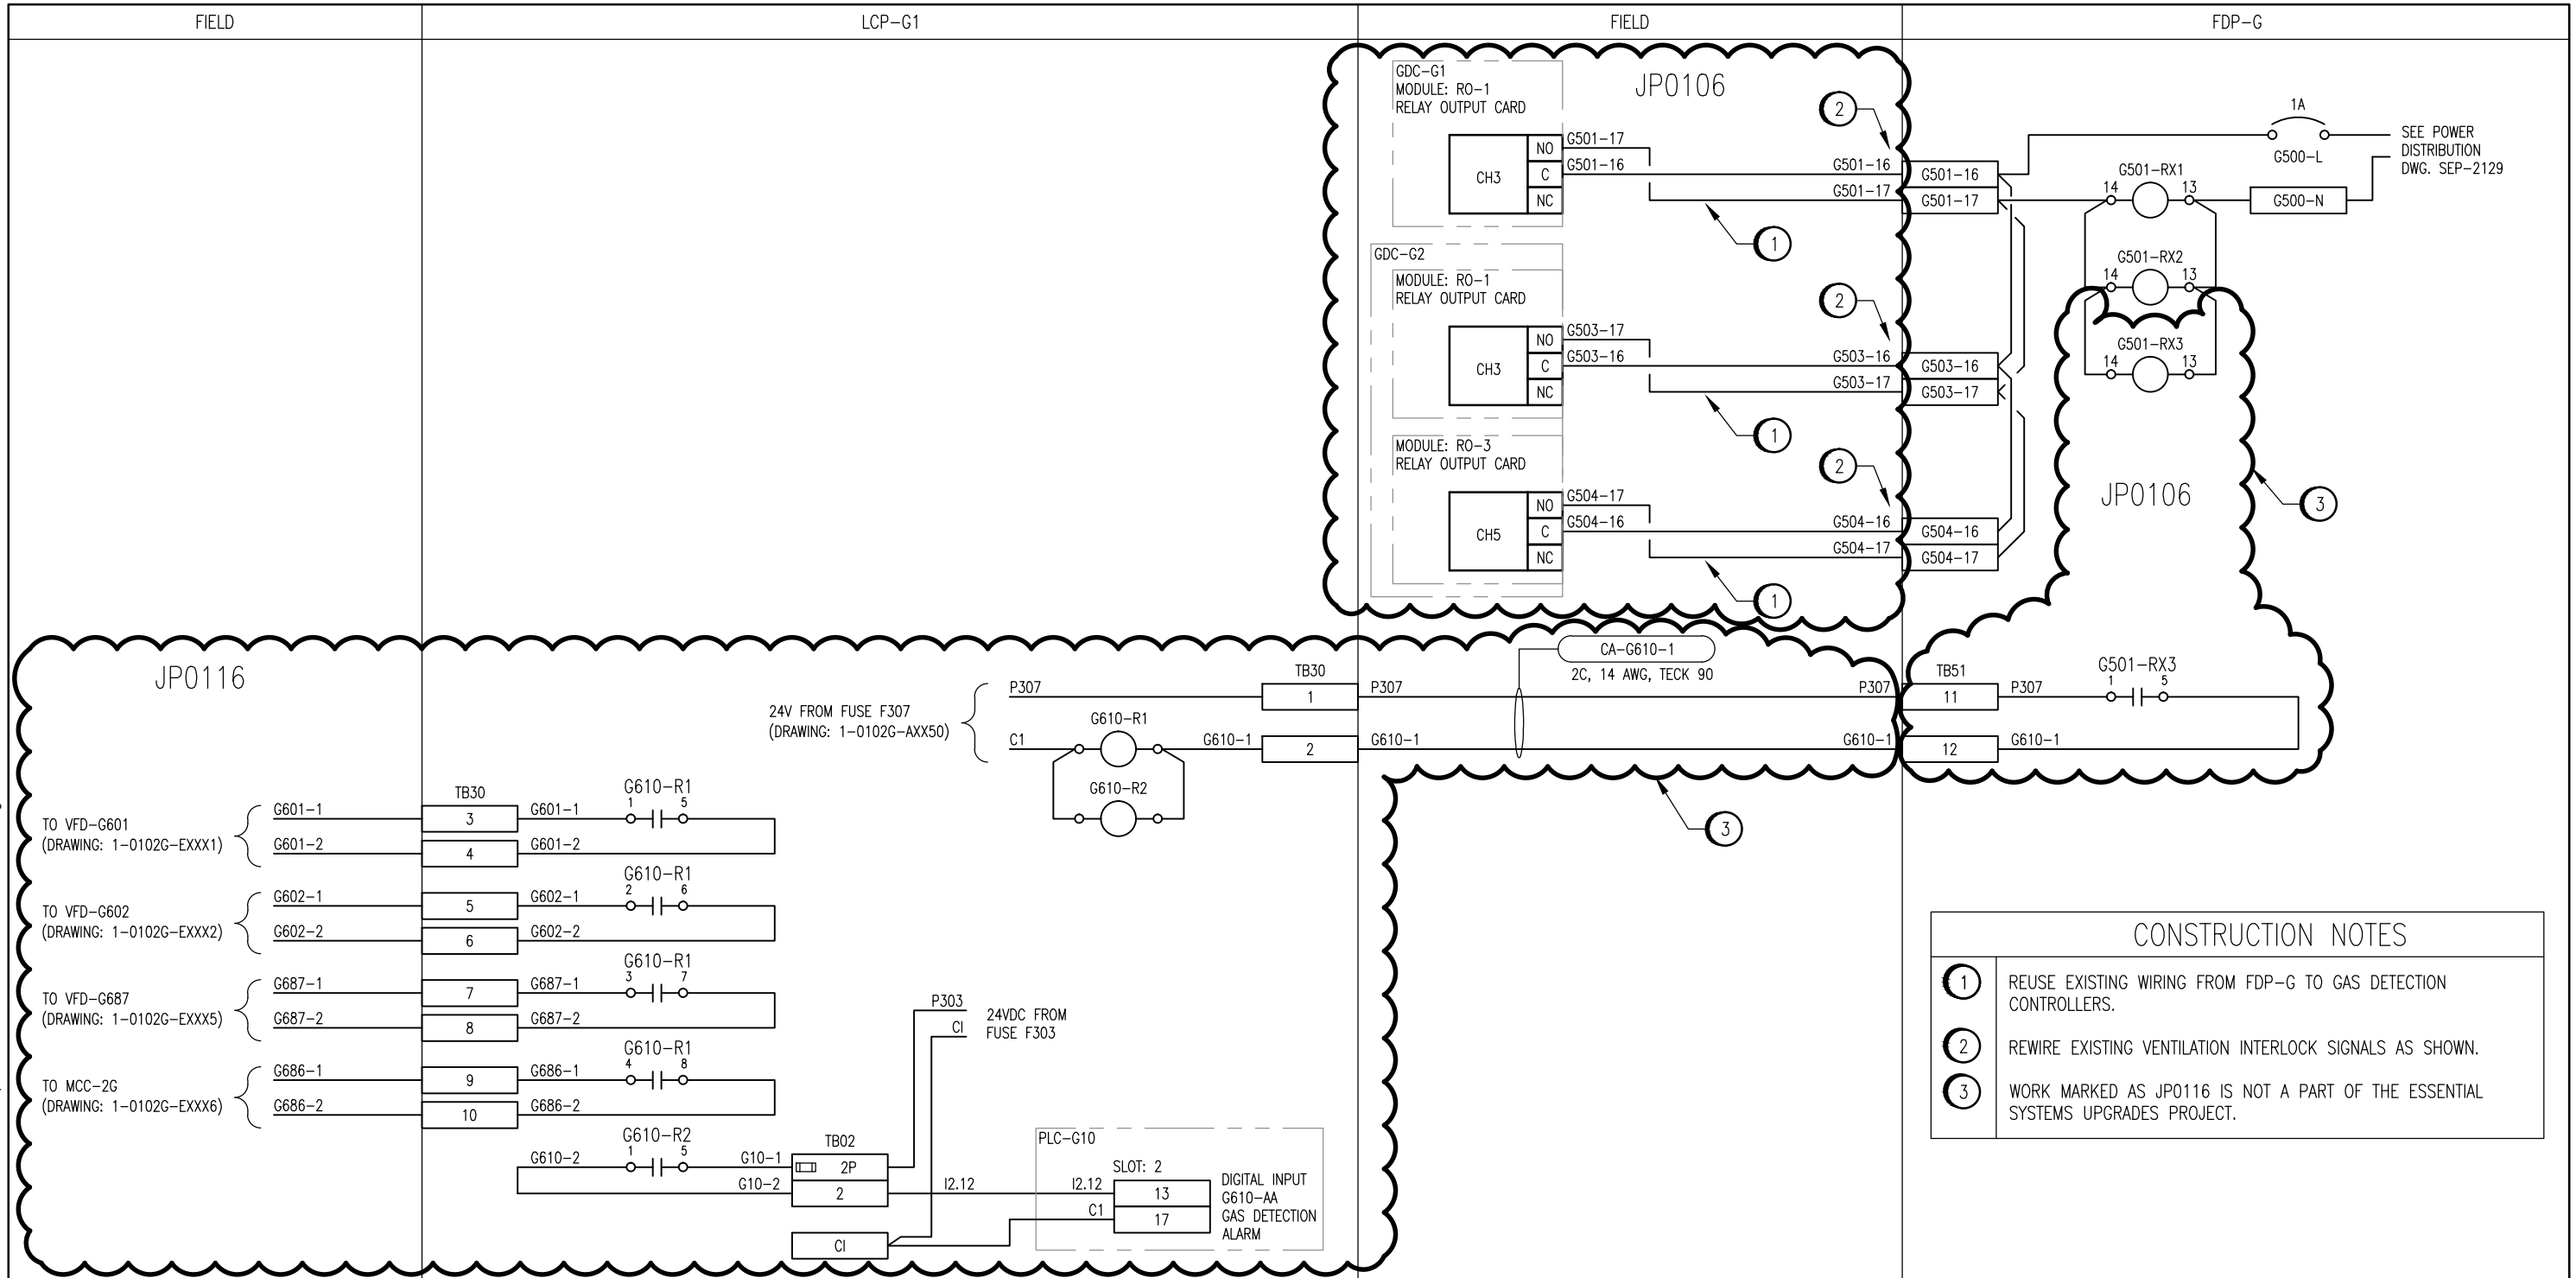

CONSTRUCTION NOTES

- REUSE EXISTING WIRING FROM FDP-G TO GAS DETECTION CONTROLLERS.
- REWIRE EXISTING VENTILATION INTERLOCK SIGNALS AS SHOWN.
- WORK MARKED AS JP0116 IS NOT A PART OF THE ESSENTIAL SYSTEMS UPGRADES PROJECT.

NOTES:

- THIS DRAWING SUPERCEDES SEP-2091.
- CONTACTS FOR "RX1" ARE LOCATED ON G684 (SEP-2121) AND G686 (SEP-2124).
- CONTACTS FOR "RX2" ARE LOCATED ON B686 (SEP-2000), B687 (SEP-2002) AND B868 (SEP-2004).



SNC-LAVALIN INC.
 148 Nature Park Way
 Winnipeg, MB, Canada R3P 0X7
 204-786-8080

NO.	REVISIONS	DATE	DESIGN	CHECK
00	ISSUED FOR TENDER, BID OPP. 209-2011	2011/03/11	TMC	CJR

DESIGNED BY: T. CHURCH	CHECKED BY: C. REIMER
DRAWN BY: S. COATES	APPROVED BY: C. REIMER
SCALE: N.T.S.	DATE: 2009/12/15
RELEASED FOR CONSTRUCTION	
BY: N. HARRINGTON	DATE: 2011/03/11
CONSULTANT NO.: 112577-0106-48DD-1223	

ENGINEER'S SEAL

ORIGINAL DRAWING SEALED BY:
 T. M. CHURCH
 SNC-LAVALIN
 2011/03/25
 REV. 00

THE CITY OF WINNIPEG
 WATER AND WASTE DEPARTMENT

Winnipeg

SOUTH END WATER POLLUTION CONTROL CENTRE
 ESSENTIAL SYSTEM UPGRADES
 INSTRUMENT LOOP DIAGRAM
 VENTILATION INTERLOCK

CITY DRAWING NUMBER	SHEET	REV.	SIZE
1-0102G-A0065	001	00	B