



LEFT SIDE
 (FUTURE TERMINALS TB11 TO TB19)

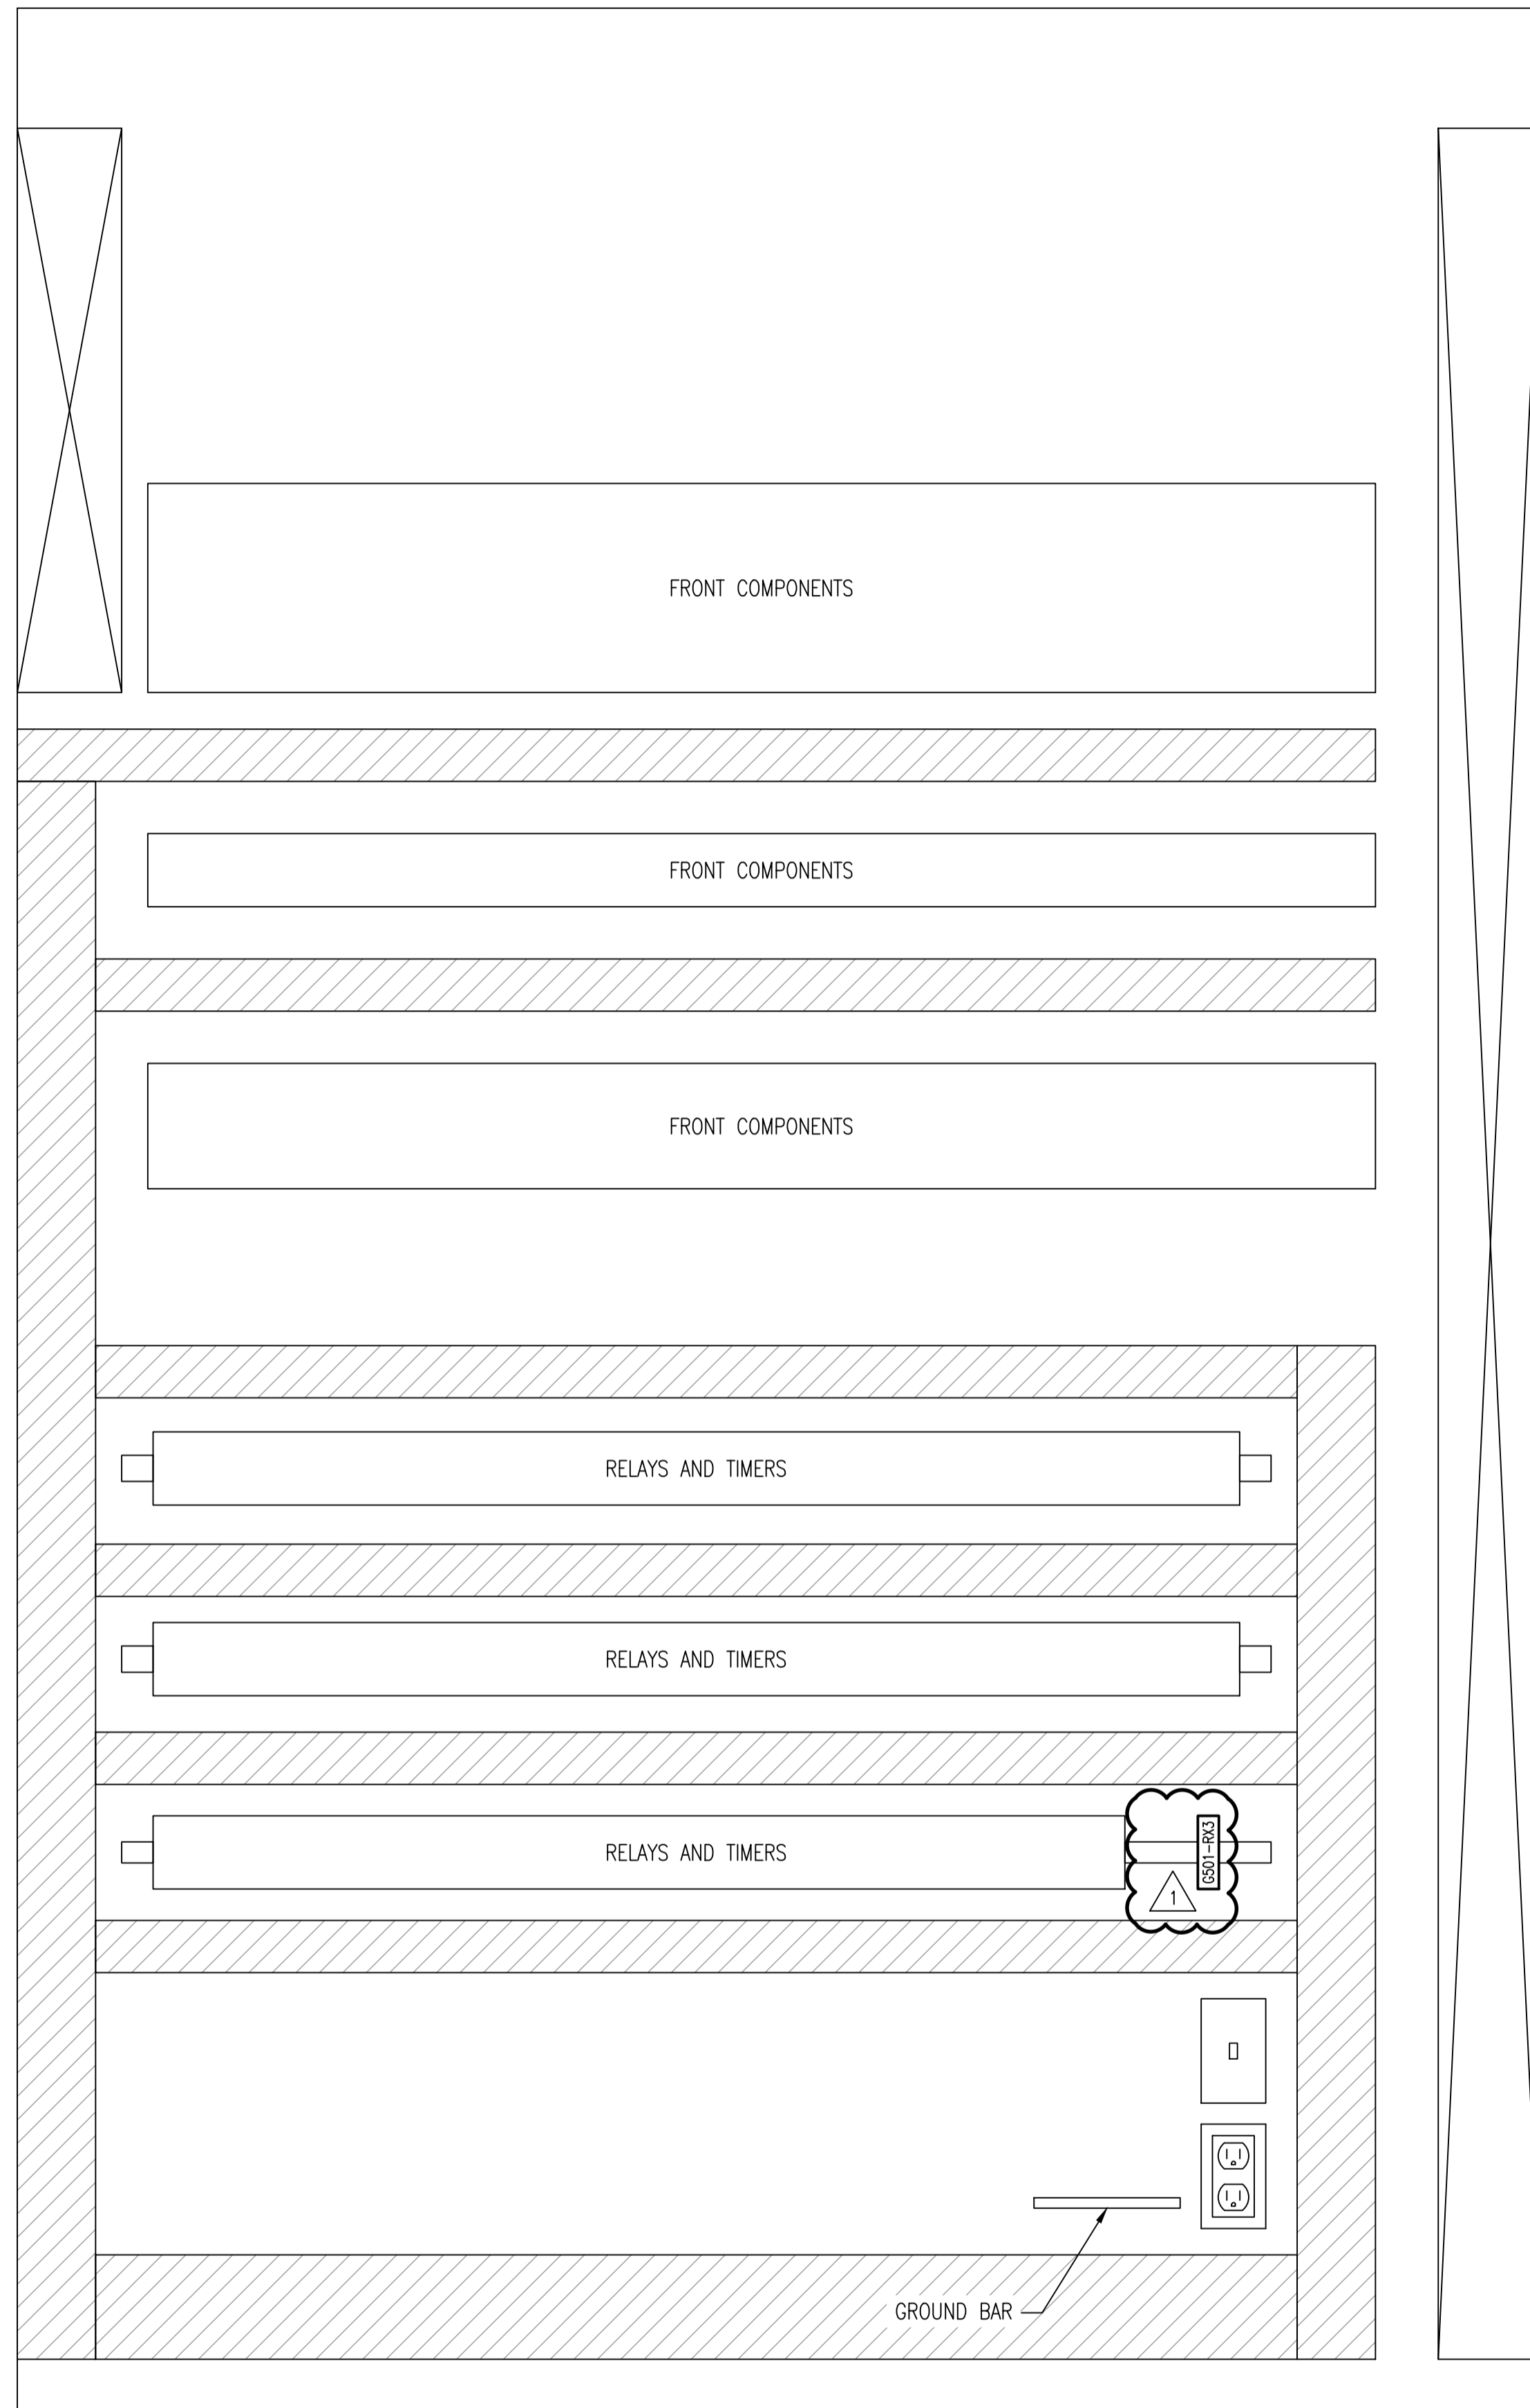

CENTRE
 (FUTURE TERMINALS TB21 TO TB29)

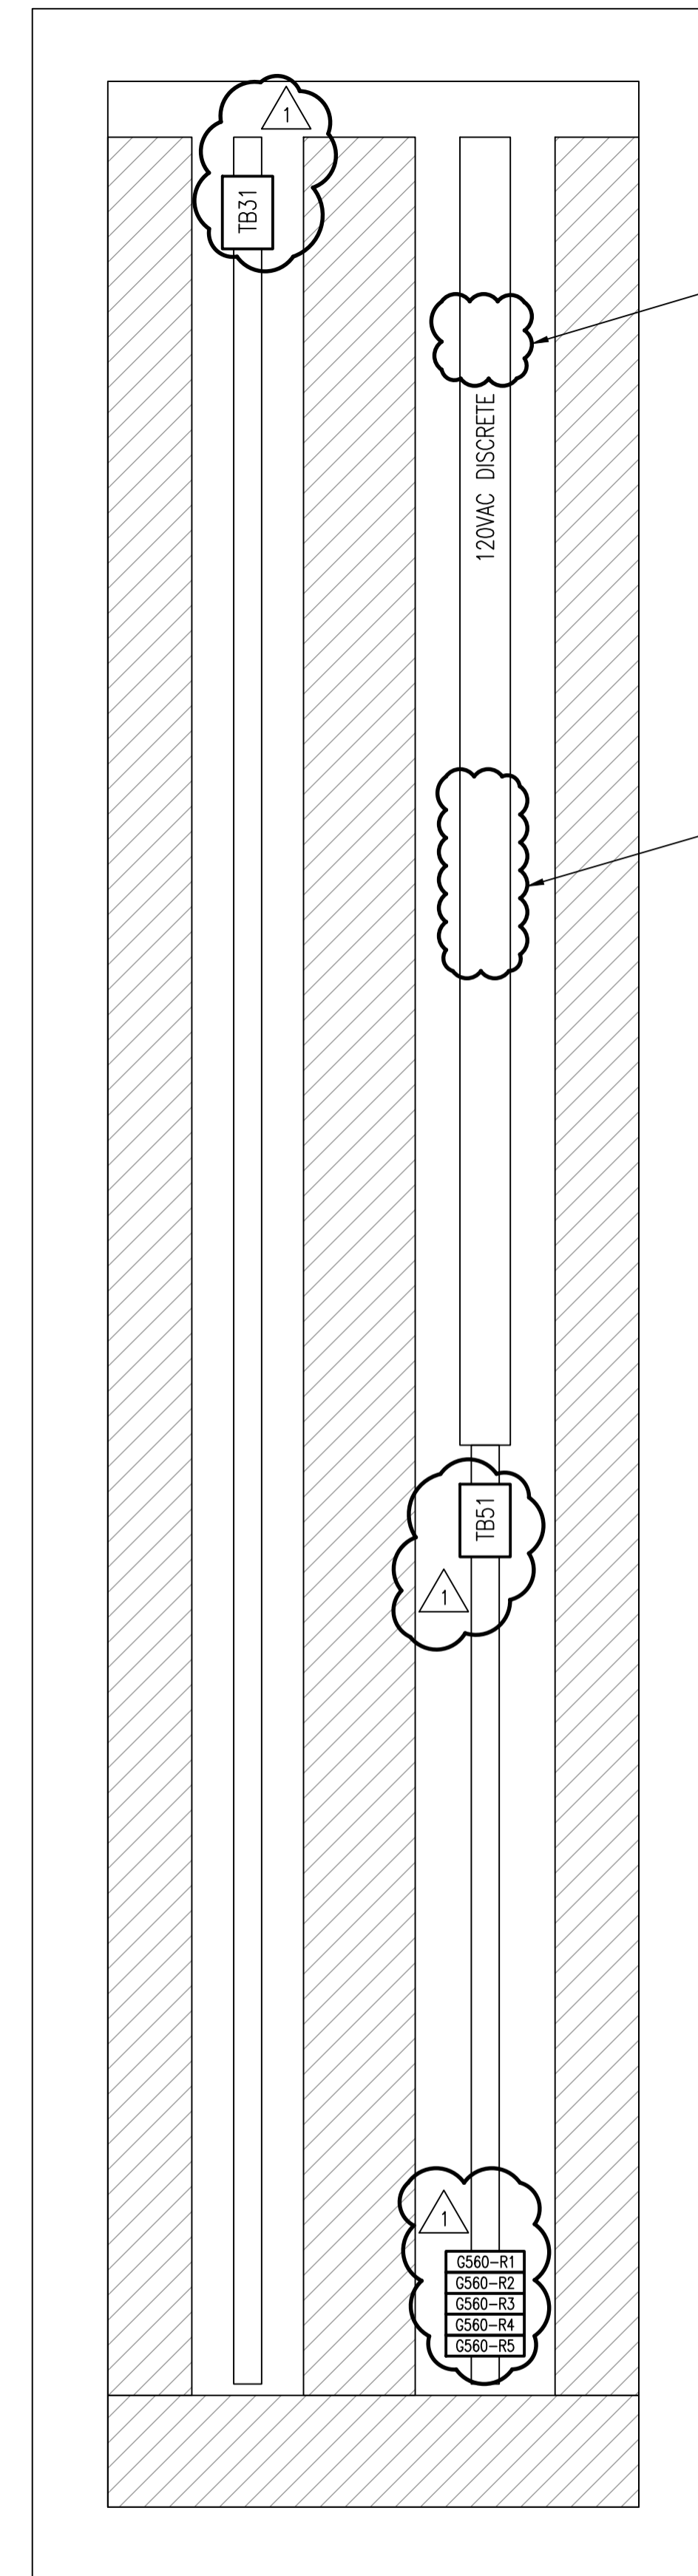

RIGHT SIDE
 (FUTURE TERMINALS TB31 TO TB59)

G501, G502, G503,
 G504 TERMINALS

G303 & G304
 TERMINALS

G319, G501, G502,
 G503, G504, G505
 TERMINALS

NOTES:

- THIS DRAWING SUPERCEDES PART OF SEP-840.

NORTH CABINET

NO.	REVISIONS	DATE	DESIGN	CHECK
01	UPS AND GAS DETECTION MODIFICATIONS	2011/03/11	TMC	CJR
00	ISSUED FOR TENDER	2010/10/01	TMC	CJR

SNC-LAVALIN INC.
 148 Nature Park Way
 Winnipeg, MB, Canada R3P 0X7
 204-786-8080

DESIGNED BY: I. CHURCH
 DRAWN BY: S. COATES
 SCALE: 1:5
 DATE: 2010/08/12
 CONSULTANT NO.: 112577-0112-480D-0304

CHECKED BY: C. REIMER
 APPROVED BY: C. REIMER
 RELEASED FOR CONSTRUCTION BY: J. VEILLEUX
 DATE: 2010/10/01

ENGINEER'S SEAL

ORIGINAL DRAWING
 SEALED BY:
 T. M. CHURCH
 SNC-LAVALIN
 MEMBER #32682
 2011/03/25
 REV. 01
 CHANGES ONLY

THE CITY OF WINNIPEG
 WATER AND WASTE DEPARTMENT

SOUTH END WATER POLLUTION CONTROL CENTRE
 HEADWORKS UPGRADES
 PANEL LAYOUT
 FDP-G REAR VIEW

CITY DRAWING NUMBER: 1-0102G-A0086
 SHEET: 002
 REV: 01
 SIZE: A1