


GRIT BUILDING CONTROL ROOM  
1:30

CONSTRUCTION NOTES

- ① REWIRE WET WELL LEVEL TRANSMITTERS AND INDICATORS FROM PNL-G10. COORDINATE WITH CITY PERSONNEL FOR REMOVAL OF EXISTING UPS IN FDP-G. ADD UPS ALARM WIRING.
- ② FEED PCU-SA FROM PNL-G10. CONNECT MAIN POWER INPUT FOR PCU-SA TO CIRCUIT FROM PNL-G10. CONNECT AUX. POWER INPUT FOR PCU-SA TO CIRCUIT FROM PNL-G9.

NOTES:

- 1. THIS DRAWING IS BASED ON THE EXISTING LAYOUT OF THE GRIT BUILDING CONTROL ROOM.

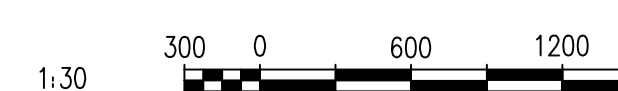

NO.	REVISIONS	DATE	DESIGN	CHECK
01	UPS MODIFICATIONS	2011/03/11	TMC	CJR
00	ISSUED FOR TENDER	2010/10/01	TMC	CJR

		SNC-LAVALIN INC. 148 Nature Park Way Winnipeg, MB, Canada R3P 0X7 204-786-8080	
DESIGNED BY:	EXISTING	CHECKED BY:	C. REIMER
DRAWN BY:	S. COATES	APPROVED BY:	C. REIMER
SCALE:	1:30	RELEASED FOR CONSTRUCTION BY:	J. VEILLEUX
DATE:	2009/11/09	DATE:	2010/10/01
CONSULTANT NO.:		112577-0106-47DD-0202	

ENGINEER'S SEAL  
ORIGINAL DRAWING  
SEALED BY:  
T. M. CHURCH  
SNC-LAVALIN  
MEMBER #32682  
2011/03/25  
REV. 01  
CHANGES ONLY

THE CITY OF WINNIPEG WATER AND WASTE DEPARTMENT	
SOUTH END WATER POLLUTION CONTROL CENTRE ESSENTIAL SYSTEM UPGRADES PLAN LAYOUT GRIT BUILDING CONTROL ROOM	
CITY DRAWING NUMBER	1-0102G-E0009
SHEET	001
REV.	01
SIZE	A1

DRAWING NUMBER	REFERENCE DRAWINGS
----------------	--------------------