


NO.	CONSTRUCTION NOTES
1	REMOVE EXISTING 10kVA REGULATING TRANSFORMER AND ASSOCIATED WIRING.
2	RE-FEED PNL-6P FROM UPS-G1.

NOTES:

- SUPERSEDES PART OF DWG. SEP-823
- ALL CONDUIT IS RIGID ALUMINUM UNLESS OTHERWISE SPECIFIED.

SEP-281	PANEL SCHEDULES
DRAWING NUMBER	REFERENCE DRAWINGS

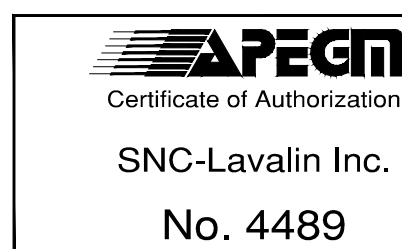

NO.	REVISIONS	DATE	DESIGN	CHECK
01	MODIFIED PNL-6P WIRING (209-2011)	2011/03/11	TMC	CJR
00	ISSUED FOR TENDER, BID OPP. 837-2009	2009/12/07	NB	CJR

SNC-LAVALIN INC.
148 Nature Park Way
Winnipeg, MB, Canada R3P 0X7
204-786-8080

DESIGNED BY: EXISTING/N. BRADDO
DRAWN BY: S. JUGANAS
SCALE: NTS
DATE: 2009/12/07
CONSULTANT NO.: 112577-0105-47DD-0302

CHECKED BY: C. REIMER
APPROVED BY: C. REIMER
RELEASED FOR CONSTRUCTION BY: J. VEILLEUX
DATE: 2009/12/02

ENGINEER'S SEAL

ORIGINAL DRAWING SEALED BY:
T. M. CHURCH
SNC-LAVALIN
MEMBER #32682
2011/03/25
REV. 01
CHANGES ONLY

THE CITY OF WINNIPEG
WATER AND WASTE DEPARTMENT

SOUTH END WATER POLLUTION CONTROL CENTRE
ESSENTIAL SYSTEM UPGRADES
SINGLE LINE DIAGRAM
PRIMARY CLARIFIERS

CITY DRAWING NUMBER: 1-0102P-E0010

SHEET: 001
REV: 01
SIZE: A1