


LEGEND:

 MODBUS NETWORK TERMINATED

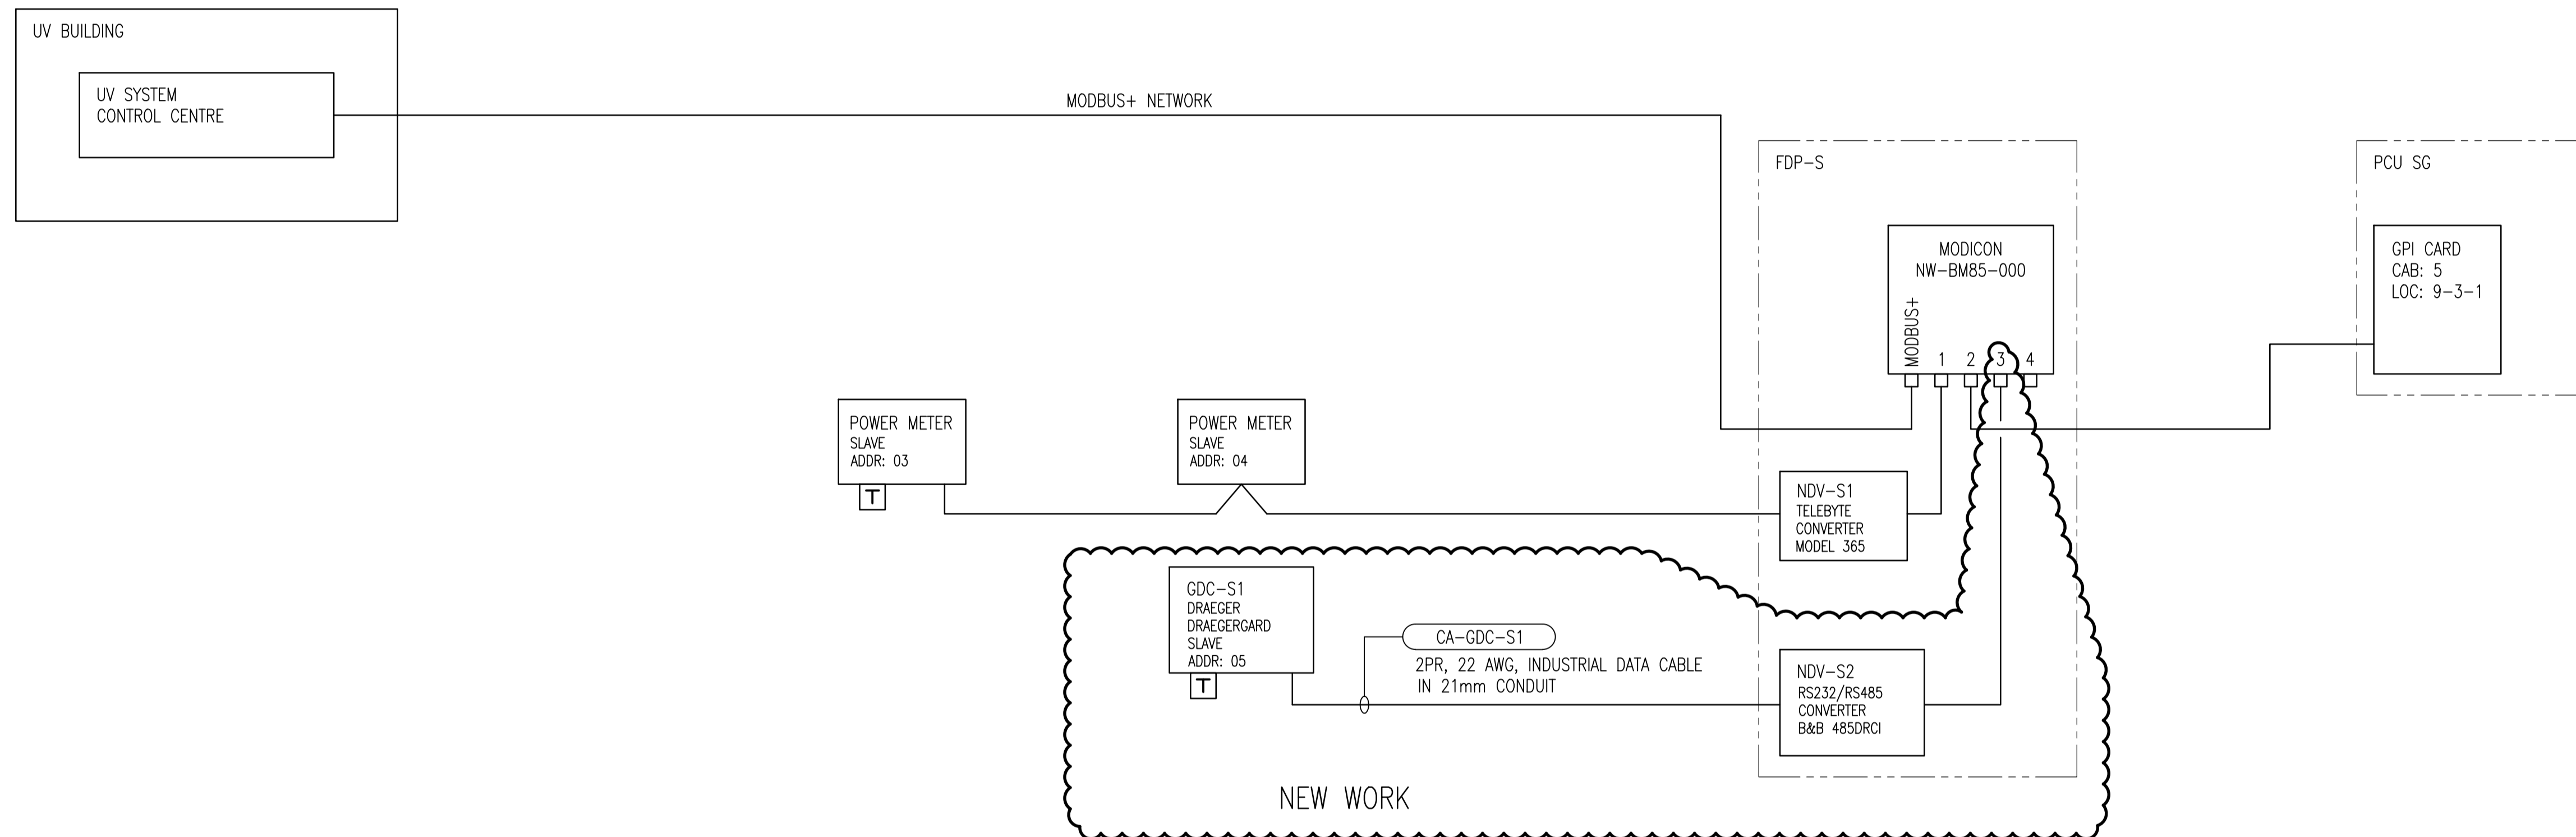

LAST SAVE: 2011/03/29 - 1:01pm
 PATH: M:\112577\0106\4ENG\488&C\DD - General DWG\1-01025-A0057-001-00.dwg



NO.	REVISIONS	DATE	DESIGN	CHECK
00	ISSUED FOR TENDER, BID OPP. 209-2011	2011/03/11	TMC	CJR

SNC-LAVALIN INC.
 148 Nature Park Way
 Winnipeg, MB, Canada R3P 0X7
 204-796-8080

DESIGNED BY: T. CHURCH
 DRAWN BY: S. COATES
 SCALE: NTS
 DATE: 2010/01/13
 CONSULTANT NO.: 112577-0106-48DD-1601

CHECKED BY: C. REIMER
 APPROVED BY: C. REIMER
 RELEASED FOR CONSTRUCTION BY: N. HARRINGTON
 DATE: 2011/03/11

ENGINEER'S SEAL
 ORIGINAL DRAWING
 SEALED BY:
 T. M. CHURCH
 SNC-LAVALIN
 MEMBER # 32682
 2011/03/25
 REV. 00

THE CITY OF WINNIPEG
 WATER AND WASTE DEPARTMENT

SOUTH END WATER POLLUTION CONTROL CENTRE
 ESSENTIAL SYSTEM UPGRADES
 NETWORK BLOCK DIAGRAM
 SECONDARY CLARIFIERS MODBUS NETWORK

CITY DRAWING NUMBER: 1-01025-A0057
 SHEET: 001
 REV.: 00
 SIZE: A1