


309

LEGEND	
	PROPERTY LINE
	EXISTING CURB
	EXISTING STREET LIGHT
	PROPOSED LIGHT
	PROPOSED MANHOLE
	EXISTING MANHOLE
	PROPOSED DRAIN
	EXISTING CURB INLET
	PROPOSED ELECTRICAL RECEPTACLE
	EXISTING WATER STOP
	PROPOSED REMOVABLE BOLLARD
	EXISTING ELECTRICAL PANEL LOCATION
	EXISTING SPOT ELEVATION
	INTERPOLATED EXISTING SPOT ELEVATION
	PROPOSED SPOT ELEVATION
	DIRECTION OF SLOPE
	TOP OF CURB
	BOTTOM OF CURB
	TOP OF WALL
	BOTTOM OF WALL
	DRAIN RIM
DETAIL KEY	
	DETAIL NUMBER
	SHEET NUMBER

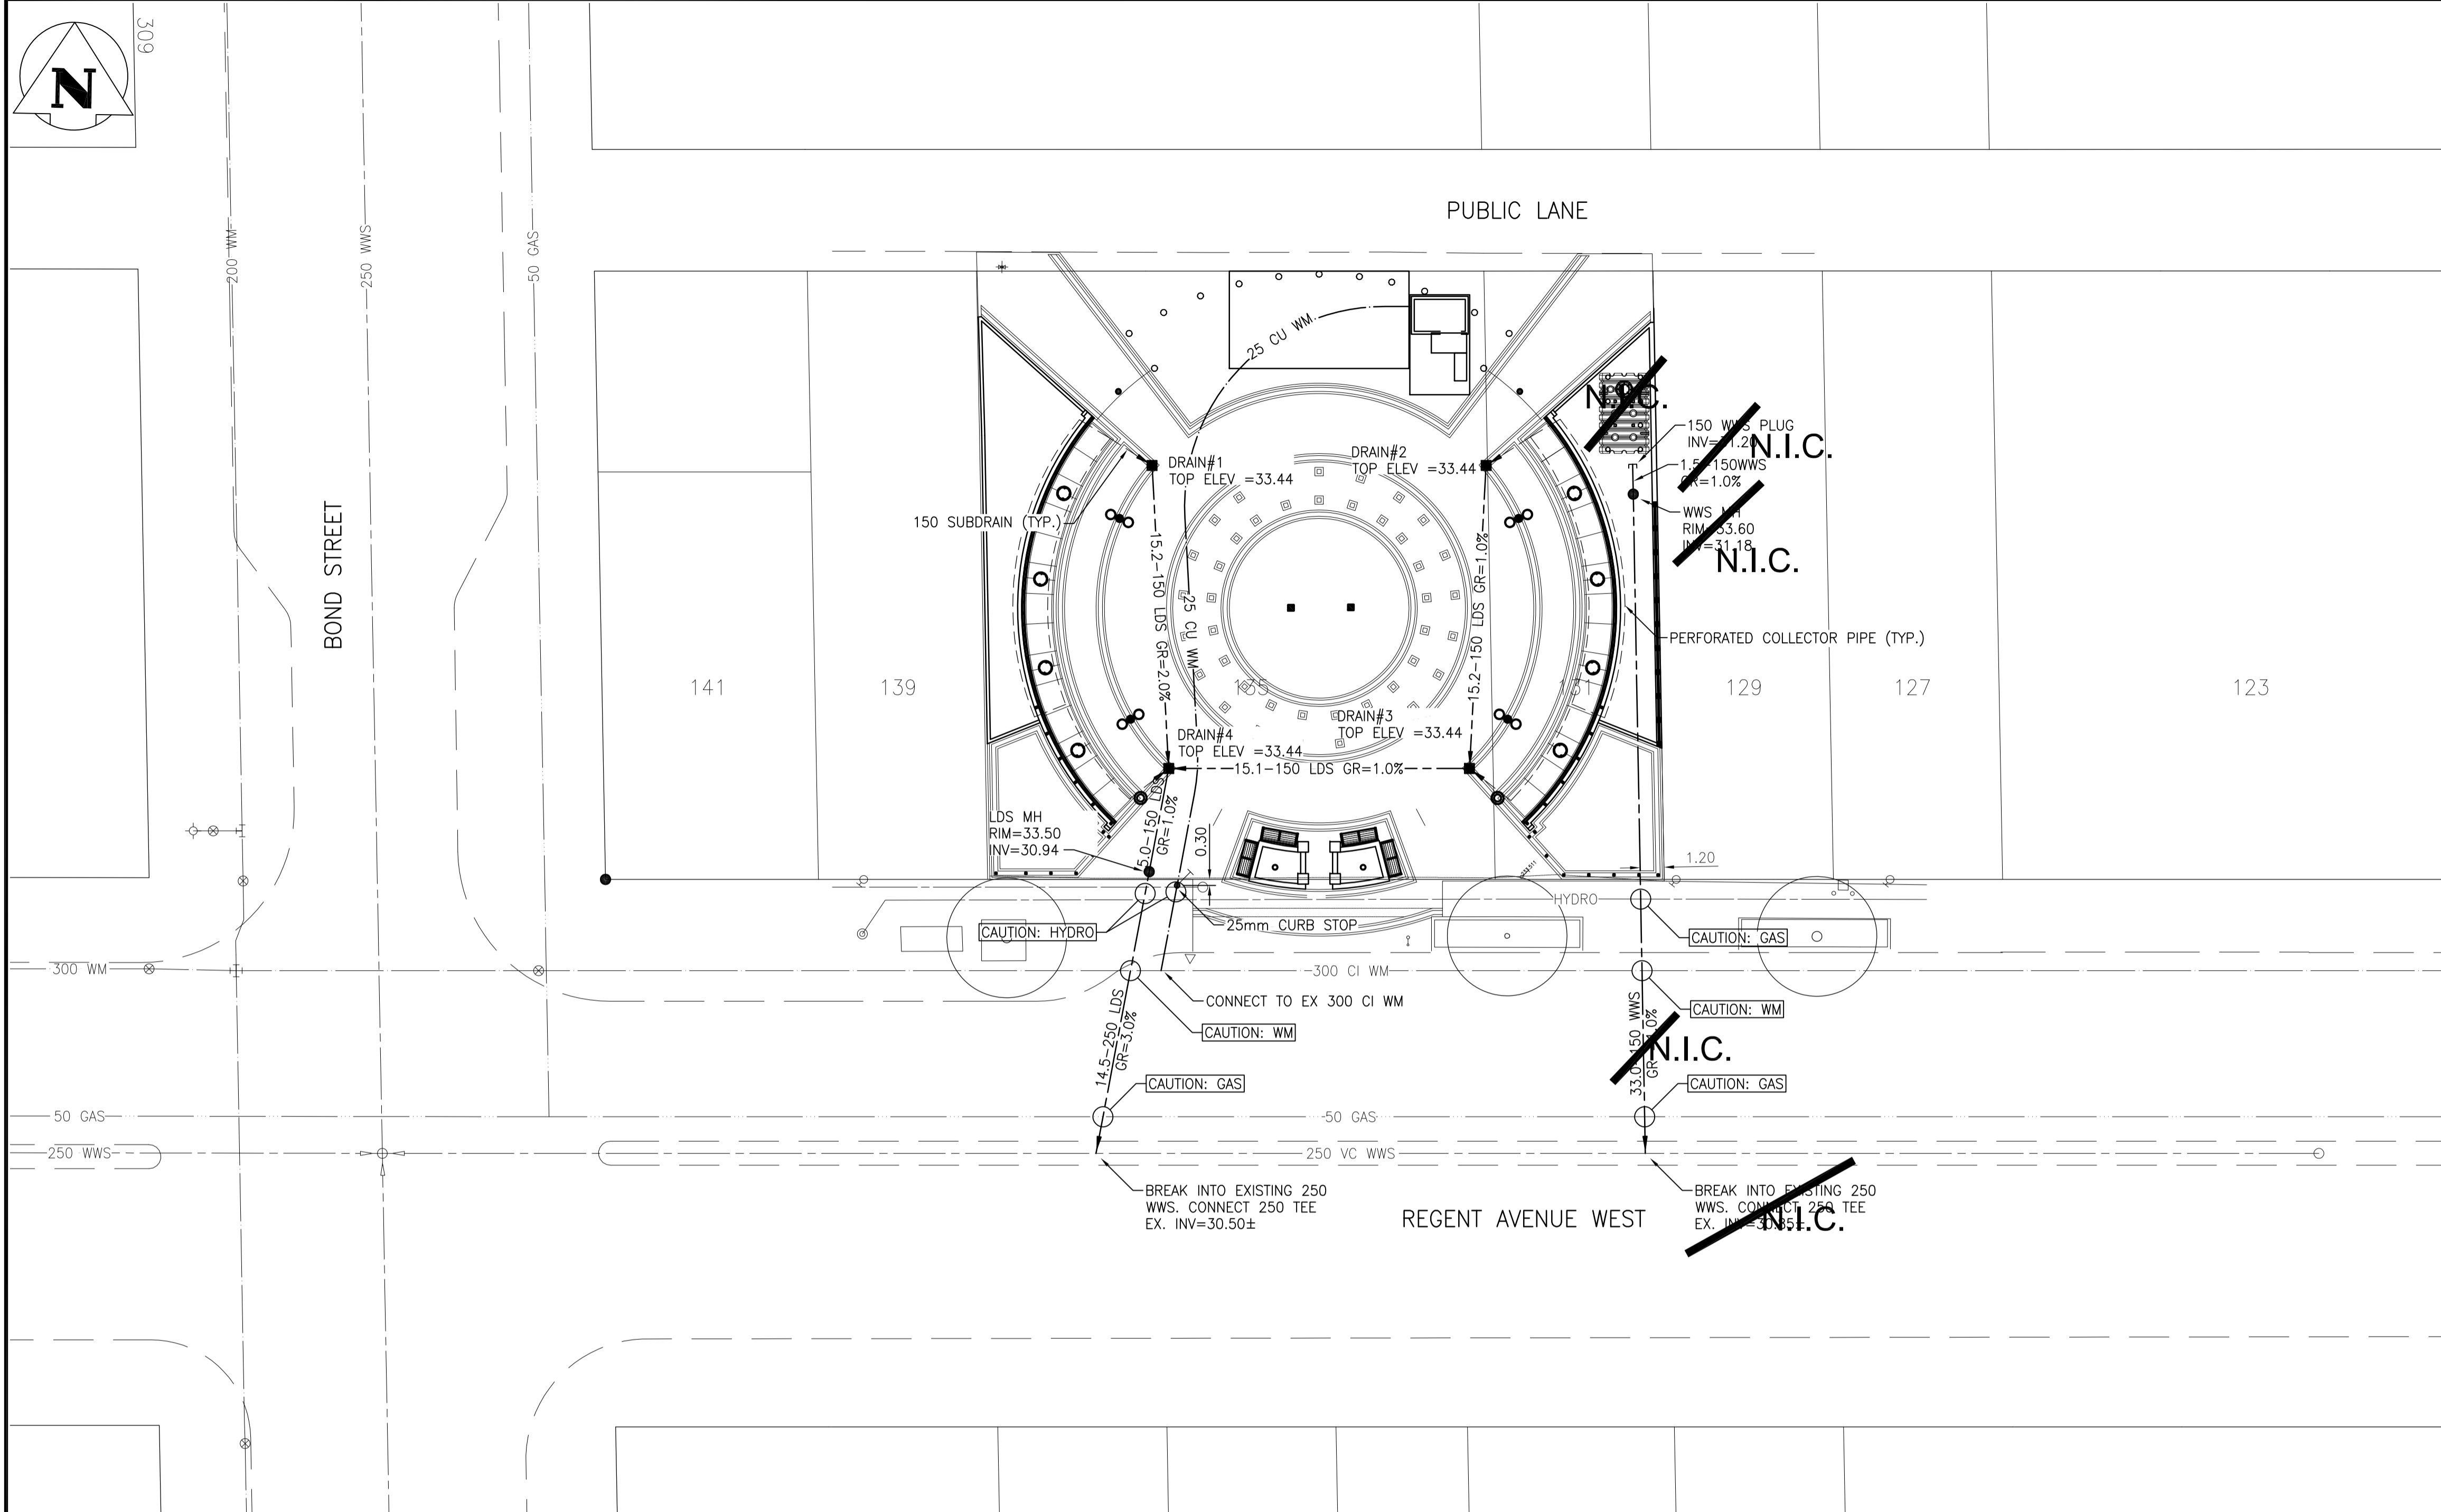

GENERAL NOTES:

- CONTRACTOR TO VERIFY LOCATION AND TYPE OF ALL EXISTING BURIED UTILITIES.
- ALL MATERIALS AND CONSTRUCTION SHALL BE IN ACCORDANCE WITH THE LATEST EDITION OF THE CITY OF WINNIPEG STANDARD CONSTRUCTION SPECIFICATION.
- WATERMAIN SERVICES TO BE PVC, CLASS 150, 38mm TO BE COPPER. ALL WATER SERVICES TO HAVE A MINIMUM 2.5m COVER. A MINIMUM CLEARANCE OF 1.0m SHALL BE PROVIDED BETWEEN THE UNDERSIDE OF ANY EXISTING WATERMAIN OR SEWERMAIN PIPE AND THE TOP OF PROPOSED WORKS. A MINIMUM CLEARANCE OF 0.5m SHALL BE PROVIDED BETWEEN THE UNDERSIDE OF PROPOSED WORKS AND THE TOP OF EXISTING WATERMAIN OR SEWERMAIN PIPE.
- LDS SEWER PIPES TO BE PVC OR CONCRETE. WWS PIPE TO BE PVC SDR 35. MANHOLES BENCHED PER CITY OF WINNIPEG SD-010. ALL LDS SEWER PIPES 600Ø AND LARGER TO BE CONCRETE C76-CLASS IV.
- CONTRACTOR TO CONFIRM THE LOCATION, DEPTH AND SIZES OF ALL SERVICE CONNECTIONS WITH BUILDING'S MECHANICAL/PLUMBING CONTRACTOR PRIOR TO SERVICE INSTALLATION.
- ALL TRENCH, MANHOLE AND CATCH BASIN BACKFILL FOR WATER, SEWER AND PVC CONDUIT INSTALLATIONS SHALL BE CLASS 2 BEDDING AND BACKFILL IN PAVED AREAS AND CLASS 4 BACKFILL IN LANDSCAPED AREAS.
- SANITARY SEWER AND WATER SERVICES SHALL TERMINATE 0.9m FROM FACE OF BUILDING.

- FOR LIGHT STANDARD BASES, ELECTRICAL CONDUITS AND WIRING, SEE ELECTRICAL DRAWINGS.
- FOR TREES, SHRUBS, GRASS AND SEEDING - SEE LANDSCAPE DRAWINGS.
- THE CONTRACTOR SHALL CLEAN AND VIDEO INSPECT ALL STORM AND SANITARY SEWERS PRIOR TO FINAL INSPECTION. THE CONTRACTOR SHALL SUBMIT (2) TWO COPIES OF THE WRITTEN REPORT AND VIDEO TO THE SITE SERVICING CONSULTANT.
- WATER VALVES AND BOXES TO BE INSTALLED PER CITY OF WINNIPEG STANDARD SD-008 AND SD-100 AND SD-101A.
- ALL CATCH BASINS AND CATCH BASIN MANHOLES TO HAVE OPEN GRATE (SD-106A). SANITARY MANHOLES TO HAVE SOLID GRATE (SD-105A).
- ALL WATERMANS SHALL BE HYDROSTATICALLY AND BACTERIOLOGICALLY TESTED IN ACCORDANCE WITH CITY OF WINNIPEG STANDARDS.
- ALL DRAINS TO BE 300mmX300mm STAINLESS STEEL ZURN GRATE COMPLETE WITH 150mm DRAIN BODY.

WARNING

IF POWER EQUIPMENT OR EXPLOSIVES ARE TO BE USED FOR EXCAVATION ON THIS PROJECT THE CONTRACTOR MUST:

- NOTIFY THE GAS COMPANY OF THE PROPOSED LOCATION OF EXCAVATION.
- TAKE PRECAUTION TO AVOID DAMAGE TO GAS COMPANY INSTALLATIONS.

SEE PROVINCIAL REGULATION 140/92 FOR DETAILS

METRIC

WHOLE NUMBERS INDICATE MILLIMETRES
DECIMALIZED NUMBERS INDICATE METRES

150 WM	WATERMAIN	150 WM	HYDRO	EXISTING	LEGEND-PLAN	PROPOSED
	WATERMAIN		HYDRO		LEGEND-PLAN	PROPOSED
	HYDRANT		M.T.S.		LEGEND-PLAN	PROPOSED
	VALVE		CONCRETE		LEGEND-PLAN	PROPOSED
	LAND DRAINAGE SEWER		ASPHALT		LEGEND-PLAN	PROPOSED
	WASTE WATER SEWER		SIDEWALK		LEGEND-PLAN	PROPOSED
	MANHOLE		PROPERTY LINE		LEGEND-PLAN	PROPOSED
	CATCH BASIN		SURVEY BAR		LEGEND-PLAN	PROPOSED
	CURB INLET		DITCH		LEGEND-PLAN	PROPOSED
	JUNCTIONS		ELEVATION		LEGEND-PLAN	PROPOSED
	CULVERT				LEGEND-PLAN	PROPOSED
	GAS				LEGEND-PLAN	PROPOSED
	EXISTING		EXISTING		LEGEND-PLAN	PROPOSED

LOCATION APPROVED UNDERGROUND STRUCTURES	
SUPV. U/G STRUCTURES COMMITTEE	DATE
NOTE:	LOCATION OF UNDERGROUND STRUCTURES AS SHOWN ARE BASED ON THE BEST INFORMATION AVAILABLE BUT NO GUARANTEE IS GIVEN THAT ALL EXISTING UTILITIES ARE SHOWN OR THAT THE GIVEN LOCATIONS ARE EXACT. CONFIRMATION OF EXISTENCE AND EXACT LOCATION OF ALL SERVICES MUST BE OBTAINED FROM THE INDIVIDUAL UTILITIES BEFORE PROCEEDING WITH CONSTRUCTION.

87R494 - S.W. Cor. Ravelston Ave. W. & Day St., Tbt, on top of 0.05 m sq. x 2.4 m iron tube, 7.0 m N. of S.L. Ravelston Ave. W. & 10.1 m E. of W.L. Day St.

B.M. 87R494	
ELEV. 233.130 m	
NO.	REVISIONS
DATE	BY

Stantec Consulting Ltd.	
DESIGNED BY: J.F.K.	CHECKED BY:
DRAWN BY: A.D.L.	APPROVED BY:
HOR. SCALE: 1:200	RELEASED FOR CONSTRUCTION:
VERTICAL: N/A	DATE



THE CITY OF WINNIPEG	
TRANSCONA CENTENNIAL SQUARE	SHEET I OF I
SITE SERVICING PLAN	CAD FILE DRAWING NUMBER 12880c-101-745.DWG
	CITY DRAWING NUMBER