



- NOTES:
- DISCONNECT AND REMOVE EXISTING CIRCUIT BREAKER OF CHILLER #1 AND CHILLER #2 FROM POWER PANEL "SD6-100" AND TURN BREAKERS OVER TO CITY.
 - DISCONNECT EXISTING FEEDERS FROM PANEL OF CHILLER #1 AND #2 AND REMOVE ALL EXISTING WIRING AND CONDUITS BETWEEN POWER PANEL "SD6-100" AND PANELS OF CHILLERS.
 - DISCONNECT AND REMOVE EXISTING MOTOR STARTER OF PUMP P-19, P-20, P-21 AND P-22 FROM MCC "MCC-1A" AND TURN MOTOR STARTERS OVER TO CITY.
 - DISCONNECT EXISTING FEEDERS FROM PUMP P-19, P-20, P-21 AND P-22 AND REMOVE ALL EXISTING WIRING AND CONDUITS BETWEEN "MCC-1A" AND PUMP P-19, P-20, P-21 AND P-22.
 - REMOVE EXISTING 30HP MOTORS AND HAND OVER TO CITY.
 - EXISTING CHILLER #1 AND #2 TO BE REMOVED BY DIVISION 23.

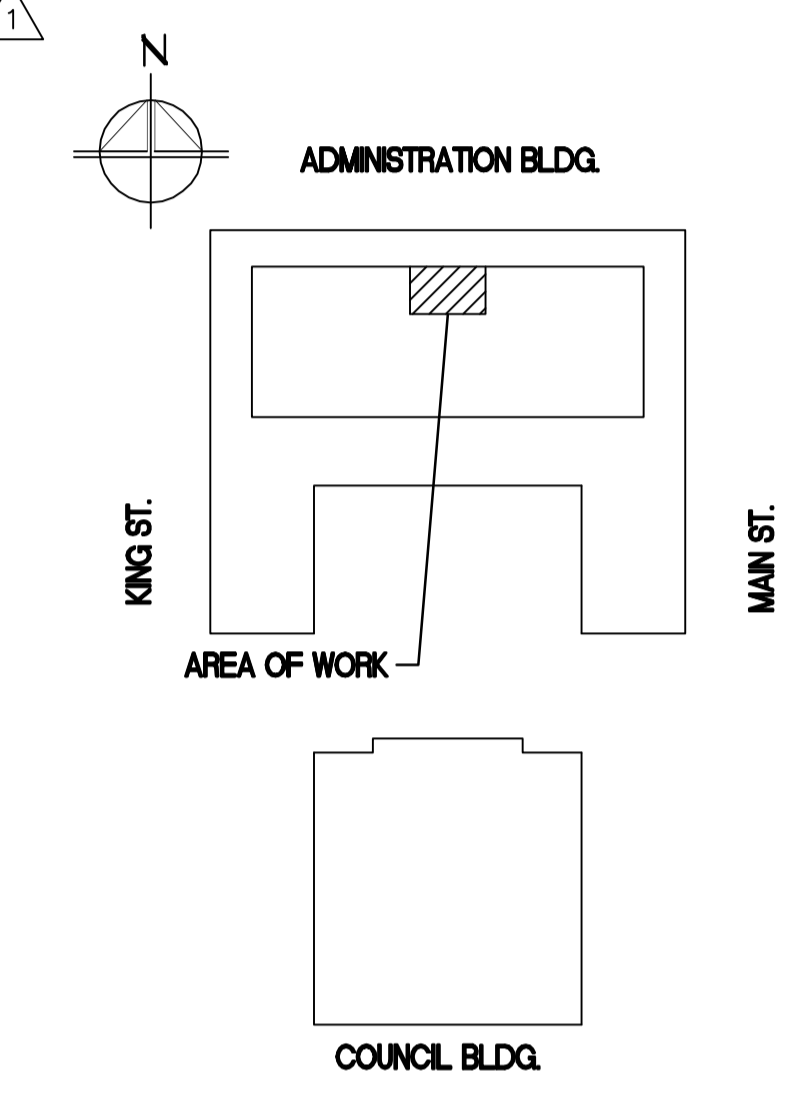

AECOM

This drawing has been prepared for the use of AECOM's client and may not be used, reproduced or relied upon by third parties, except as agreed by AECOM and its client, as required by law or for use by governmental reviewing agencies. AECOM accepts no responsibility, and denies any liability whatsoever, to any party that modifies this drawing without AECOM's express written consent. Do not scale this document. All measurements must be obtained from stated dimensions.

| No. | REVISION/DESCRIPTION | BY | DATE |
|-----|-----------------------|----|------------|
| 1 | ISSUED FOR ADDENDUM 1 | SS | 2011.11.19 |
| 0 | ISSUED FOR TENDER | SS | 2011.11.09 |

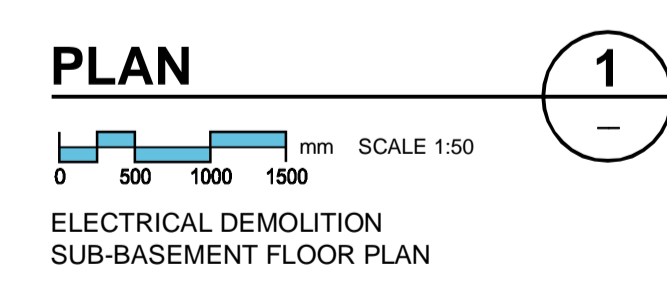

| DRAWN | QC | CHECKED | AL | DESIGNED | QL | APPROVED | SS |
|-------|------------|---------|----------|----------|----|----------|----|
| DATE | 2011.09.02 | USER | APPROVAL | | | | |

Winnipeg THE CITY OF WINNIPEG PLANNING, PROPERTY AND DEVELOPMENT DEPARTMENT MUNICIPAL ACCOMMODATIONS DIVISION 3-65 GARRY STREET, R3C 4K4

PROJECT ADMINISTRATION & COUNCIL BUILDING REPLACEMENT OF COOLING PLANT - 510 MAIN STREET BID OPPORTUNITY NO. 673-2011 510 MAIN STREET, WINNIPEG, MANITOBA

APEGN
Certificate of Authorization
AECOM Canada Ltd.
No. 4671 Date: _____

| | | | | |
|-----|-----|-----|-----|-----|
| DRN | CHK | DES | ENG | IDR |
| | | | | |

AECOM REVIEW

SHEET TITLE

ELECTRICAL DEMOLITION SUB-BASEMENT FLOOR PLAN

| | | |
|-------|-------------|-----------|
| SCALE | PROJECT No: | SHEET No: |
| 1:50 | 60220937 | E-002 |

DRAWING SHEET SIZE: A1 (841mm x 594mm) PLOT 1:1