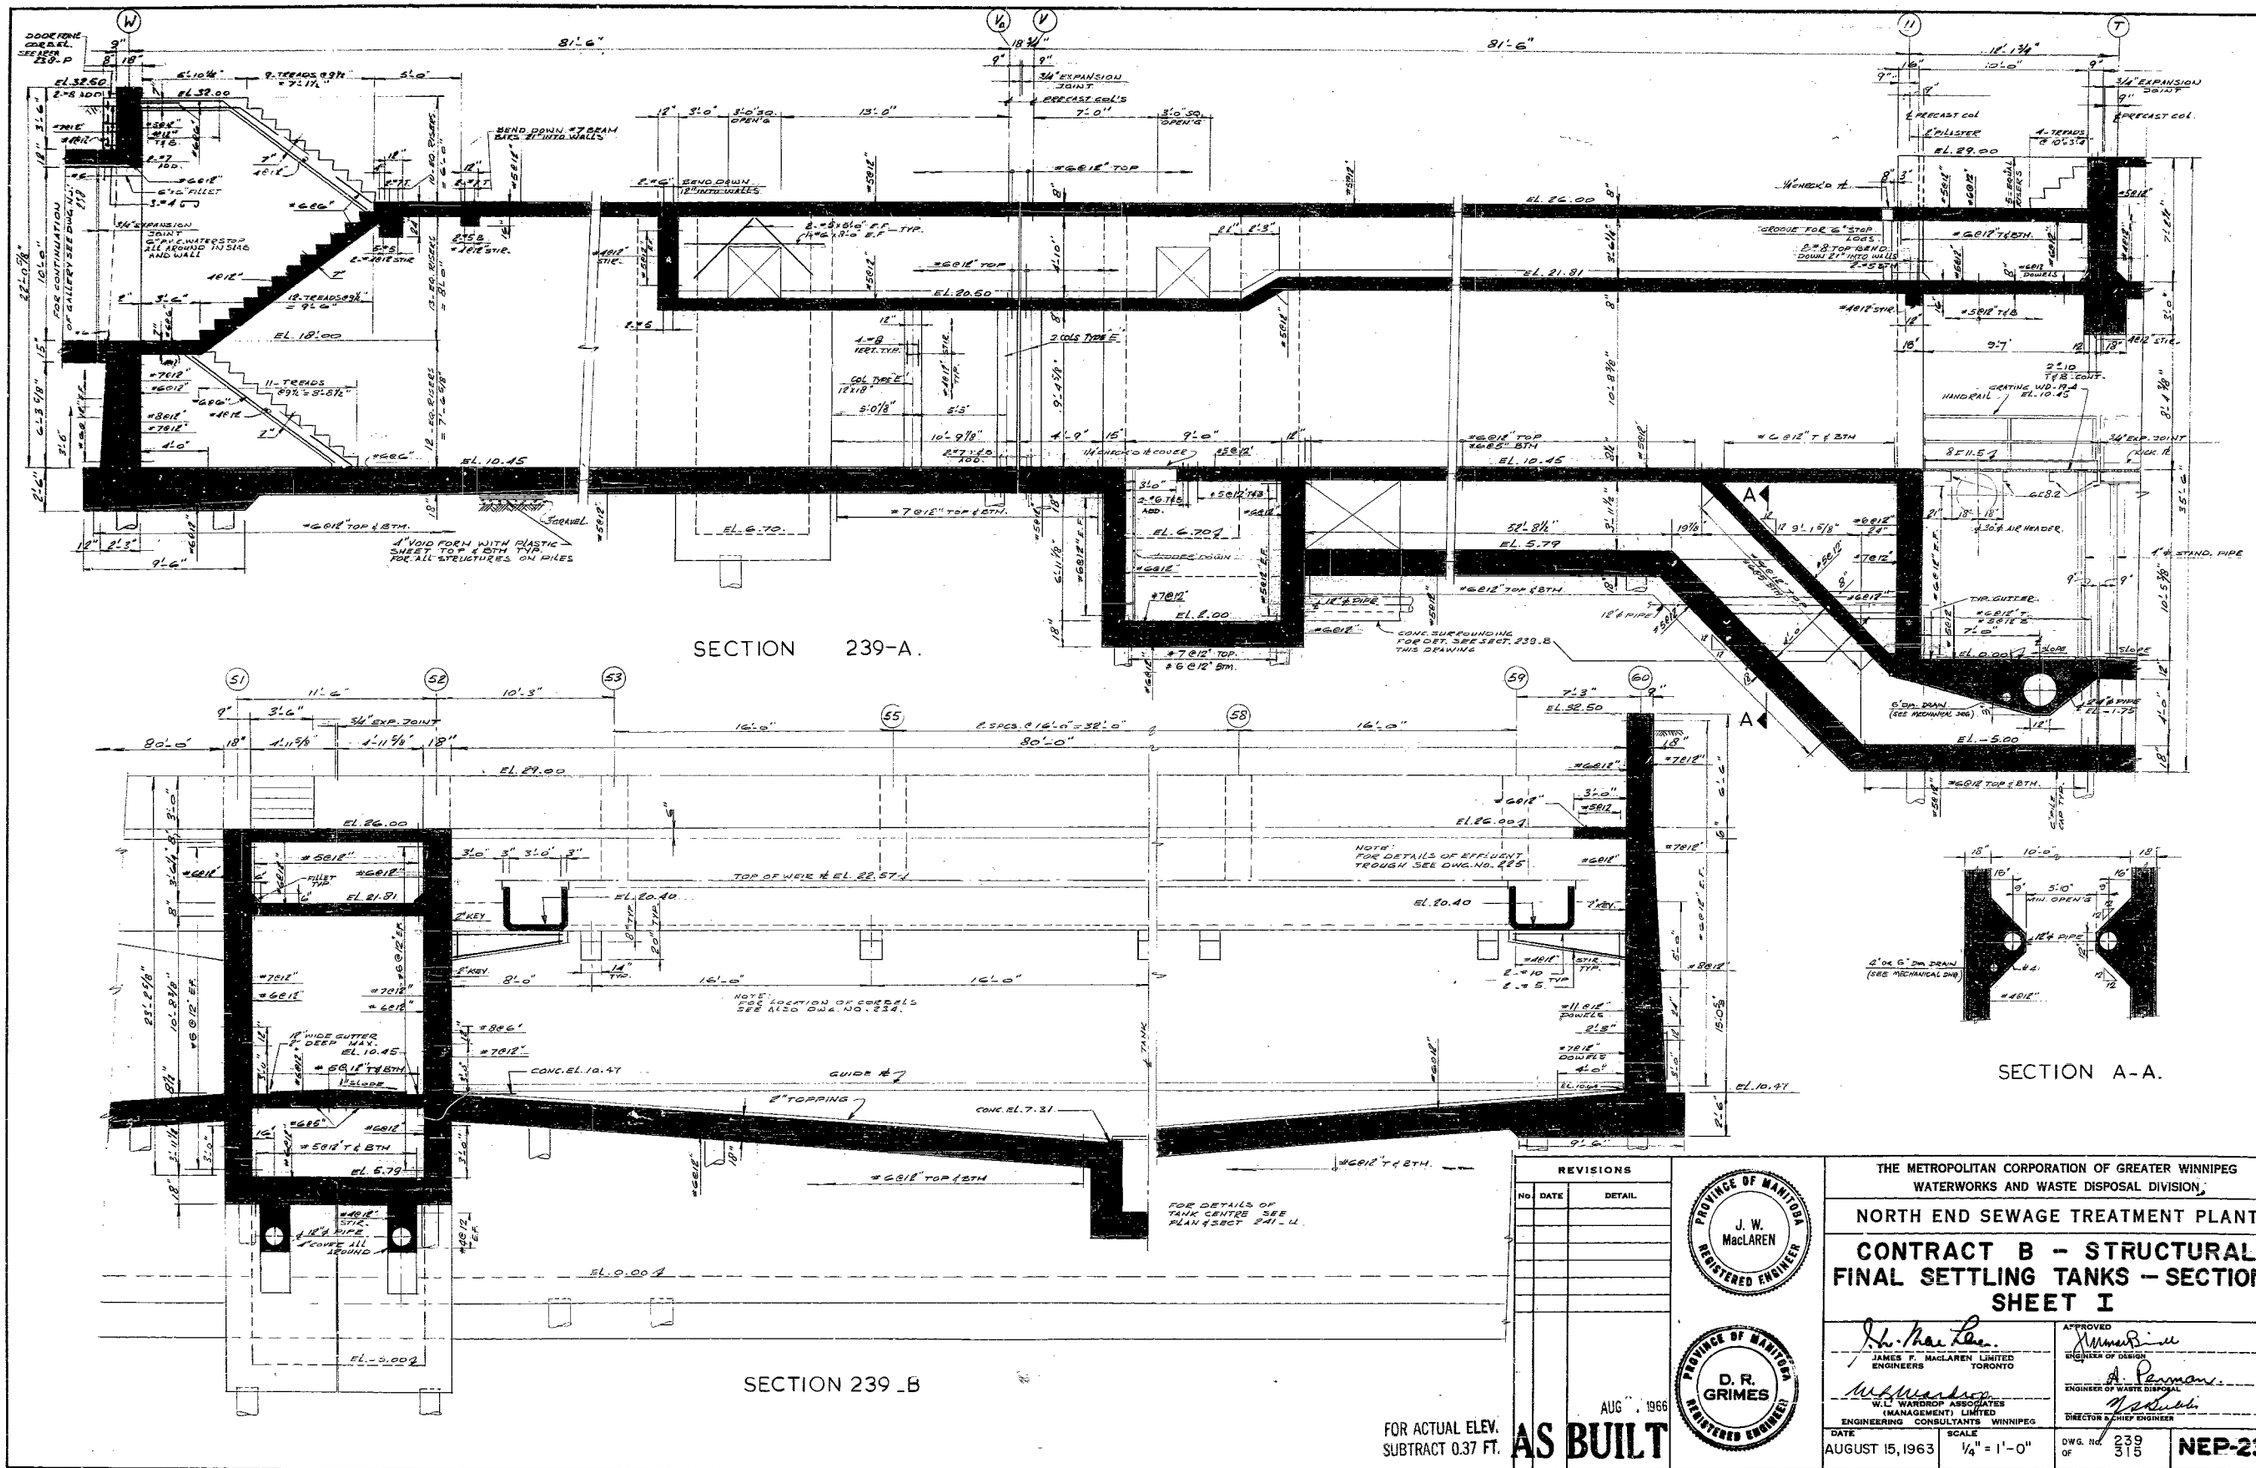

REVISIONS

No.	DATE	DETAIL

J. W. MacLAREN — REGISTERED ENGINEER — PROVINCE OF MANITOBA

D. R. GRIMES — REGISTERED ENGINEER — PROVINCE OF MANITOBA

THE METROPOLITAN CORPORATION OF GREATER WINNIPEG
WATERWORKS AND WASTE DISPOSAL DIVISION

NORTH END SEWAGE TREATMENT PLANT

CONTRACT B - STRUCTURAL
FINAL SETTLING TANKS — SECTIONS
SHEET I

JAMES F. MacLAREN LIMITED, ENGINEERS, TORONTO
W.L. WARDROP ASSOCIATES (MANAGEMENT) LIMITED, ENGINEERING CONSULTANTS, WINNIPEG

APPROVED
ENGINEER OF DESIGN
ENGINEER OF WASTE DISPOSAL
DIRECTOR & CHIEF ENGINEER

DATE: AUGUST 15, 1963 | SCALE: 1/4" = 1'-0" | DWG. No. 239 OF 315 | NEP-239

REF. # DRAWING NO. NEP-239

DETAILS

FILE 530-D-4823