


NO. OF DRAWING AND SHEET NO. DETAILS

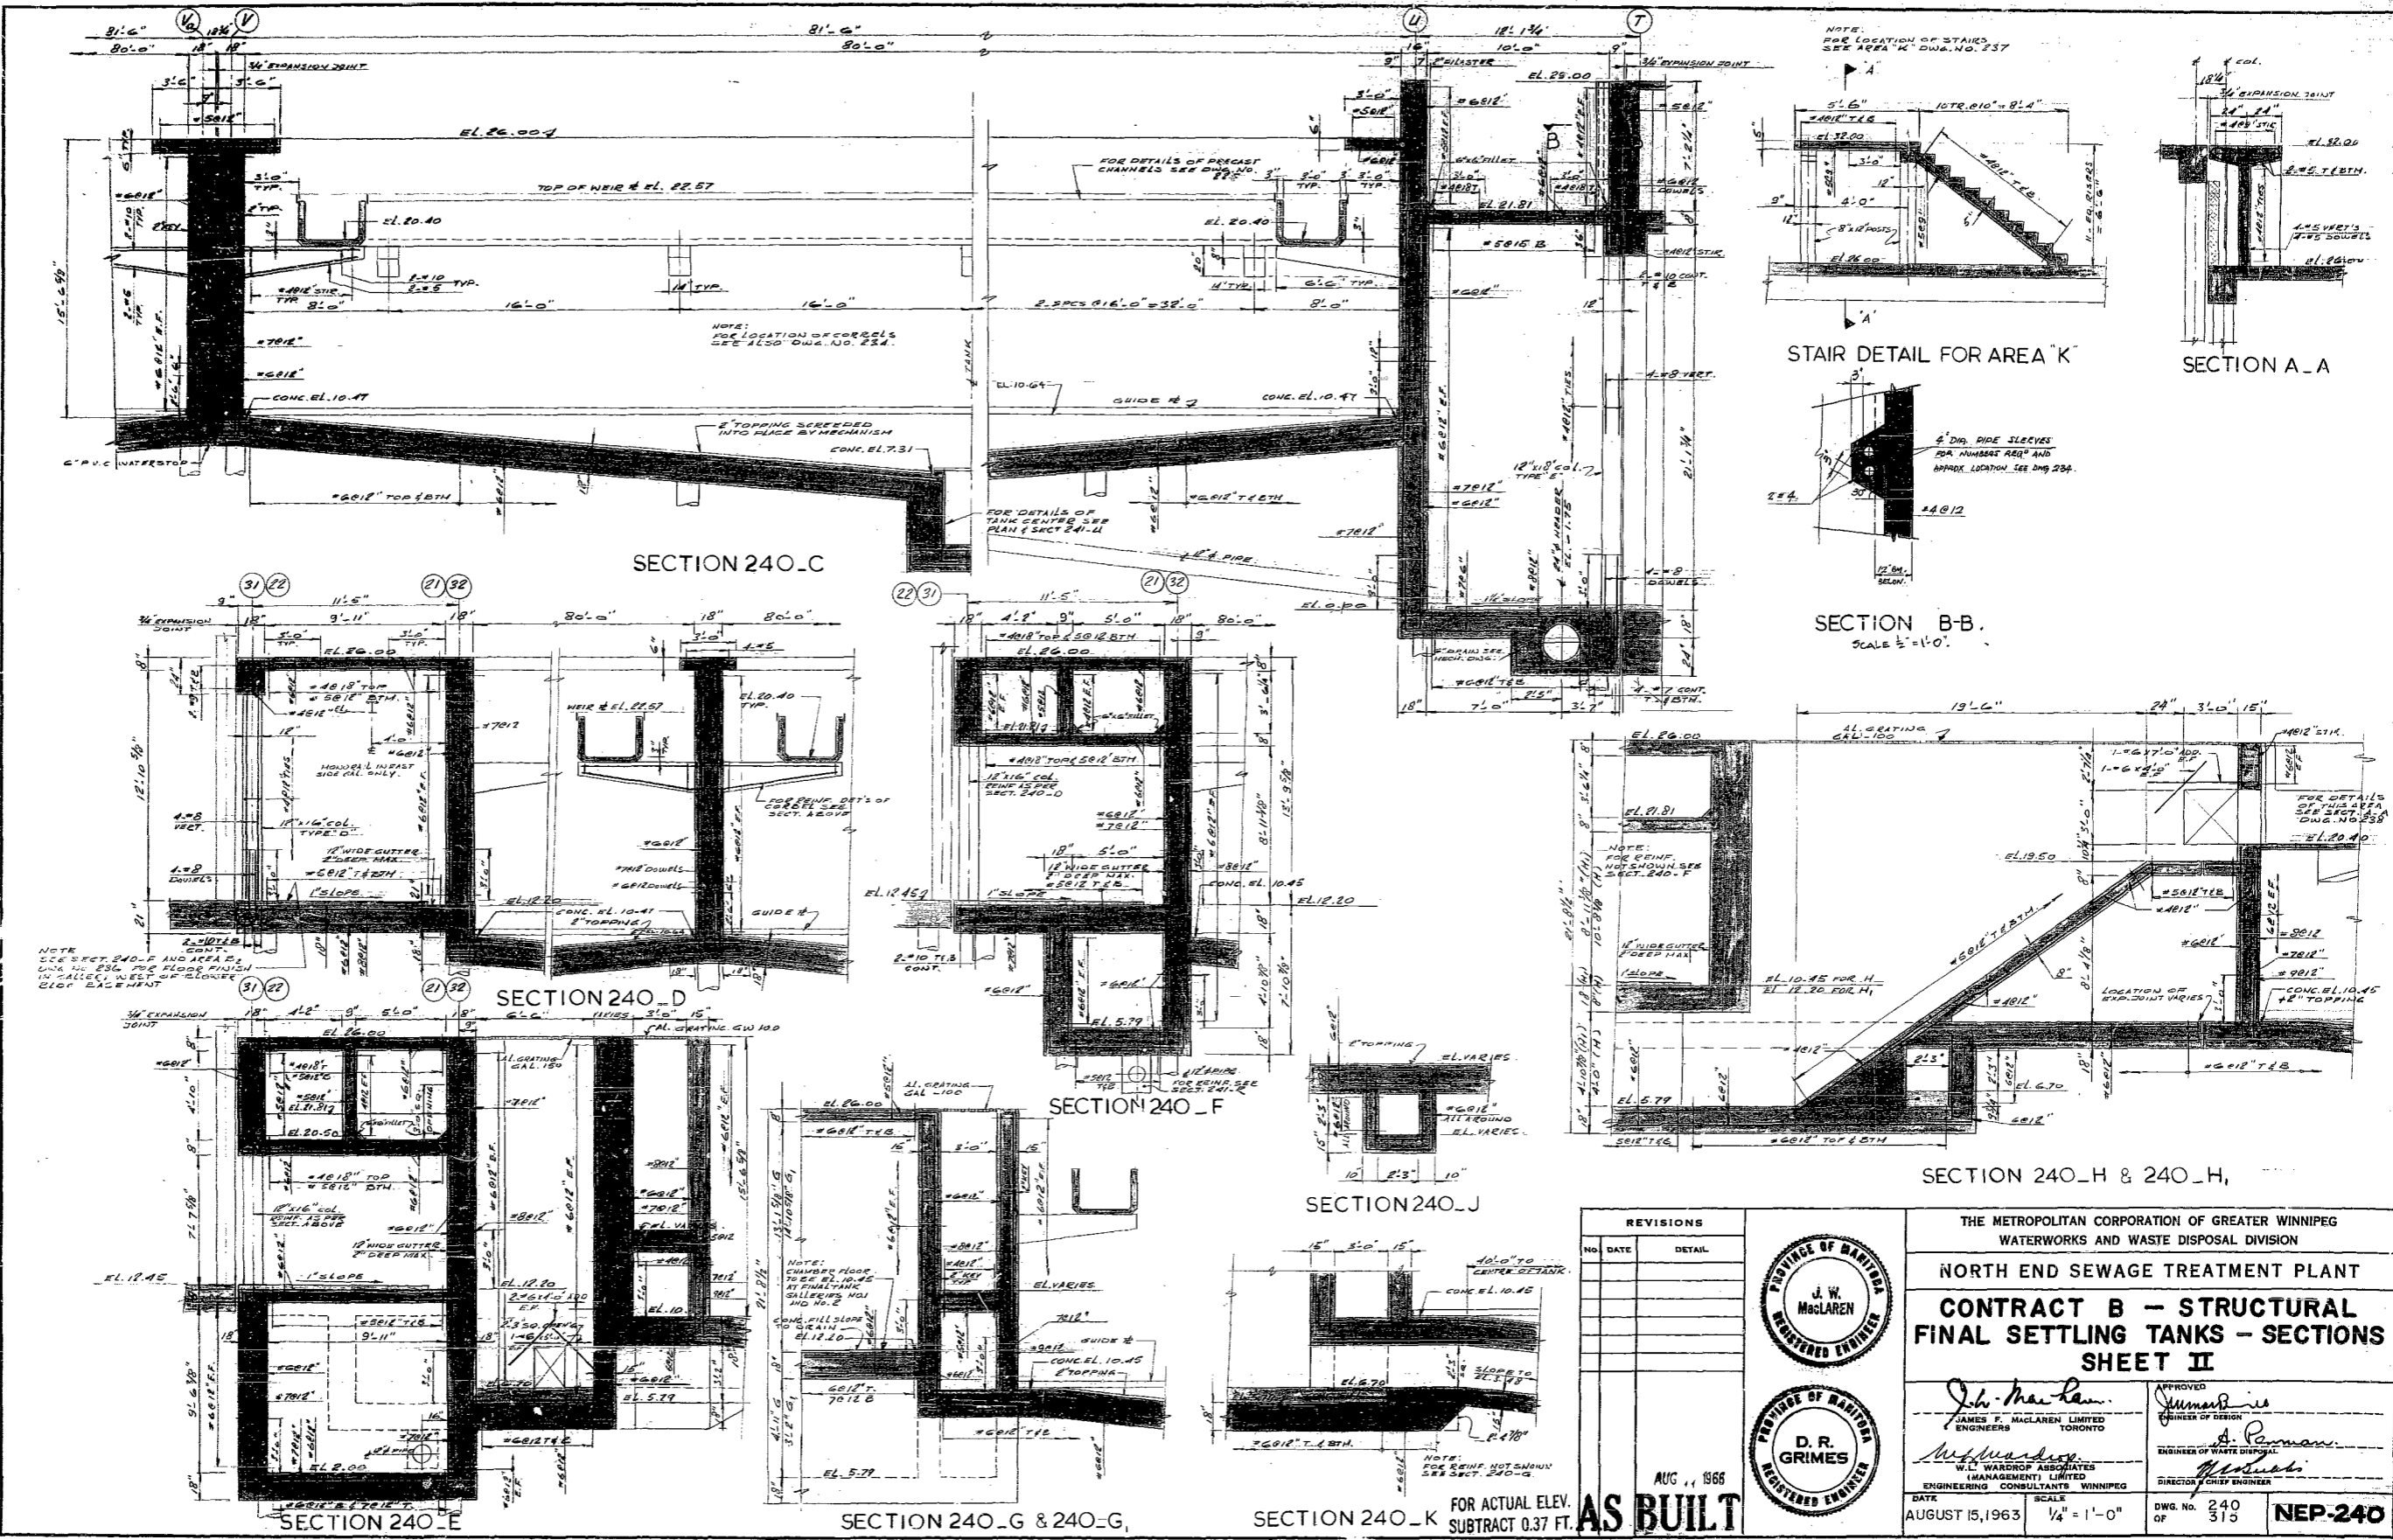

THE METROPOLITAN CORPORATION OF GREATER WINNIPEG
 WATERWORKS AND WASTE DISPOSAL DIVISION
 NORTH END SEWAGE TREATMENT PLANT
CONTRACT B - STRUCTURAL
FINAL SETTLING TANKS - SECTIONS
SHEET II

APPROVED
 J. W. MacLaren
 JAMES F. MACLAREN LIMITED
 ENGINEERS
 TORONTO

APPROVED
 A. Pannan
 W.L. WARDROP ASSOCIATES
 (MANAGEMENT) LIMITED
 ENGINEERING CONSULTANTS WINNIPEG
 DIRECTOR CHIEF ENGINEER

DATE AUGUST 15, 1963
 SCALE 1/4" = 1'-0"
 DWG. No. 240 OF 315
NEP-240