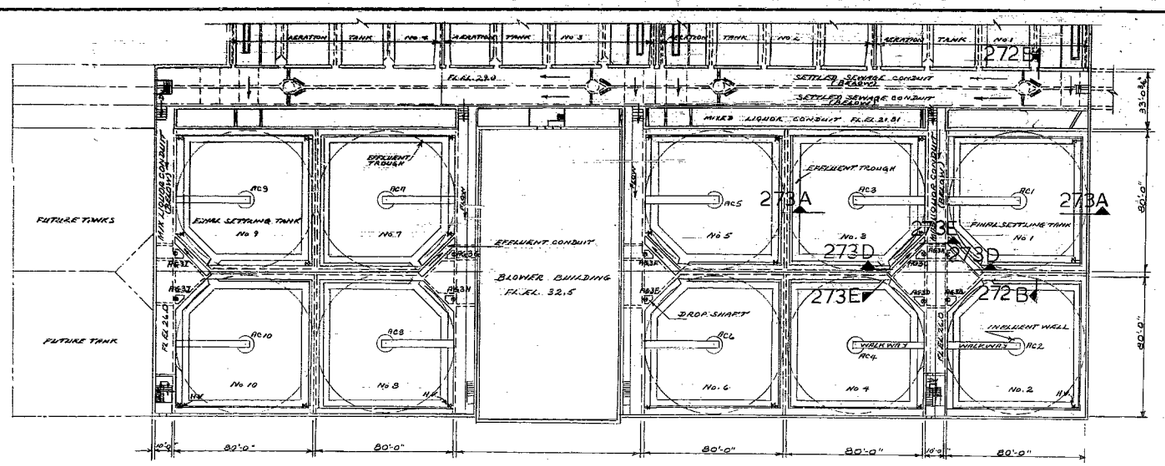

PLAN OF FINAL SETTLING TANK
BELOW ELEV. 330
SCALE 1"=40'-0"

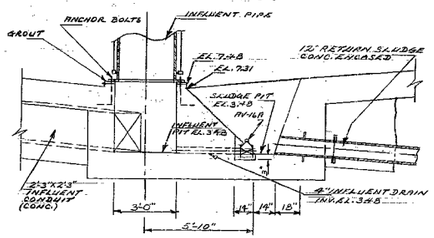

SECTION 272C
SCALE 1/2"=1'-0"

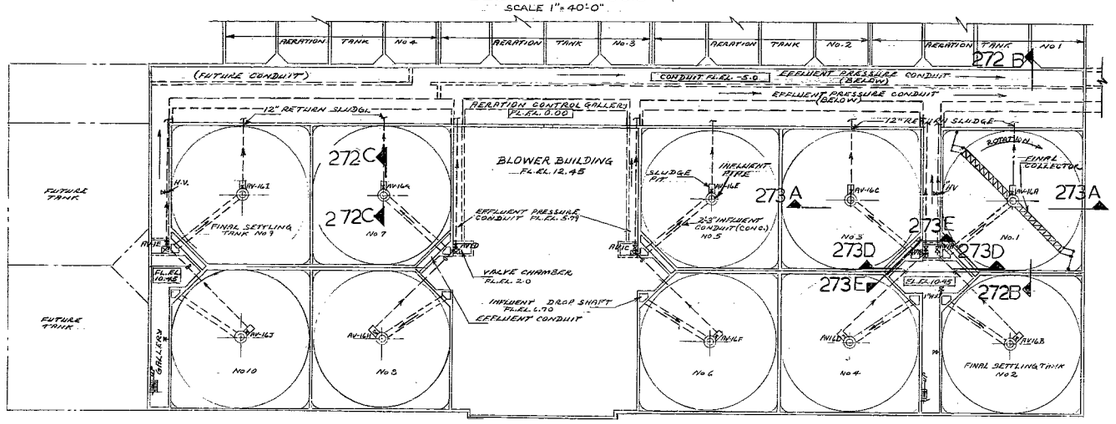

PLAN OF FINAL SETTLING TANKS
BELOW ELEV. 14.0
SCALE 1"=40'-0"

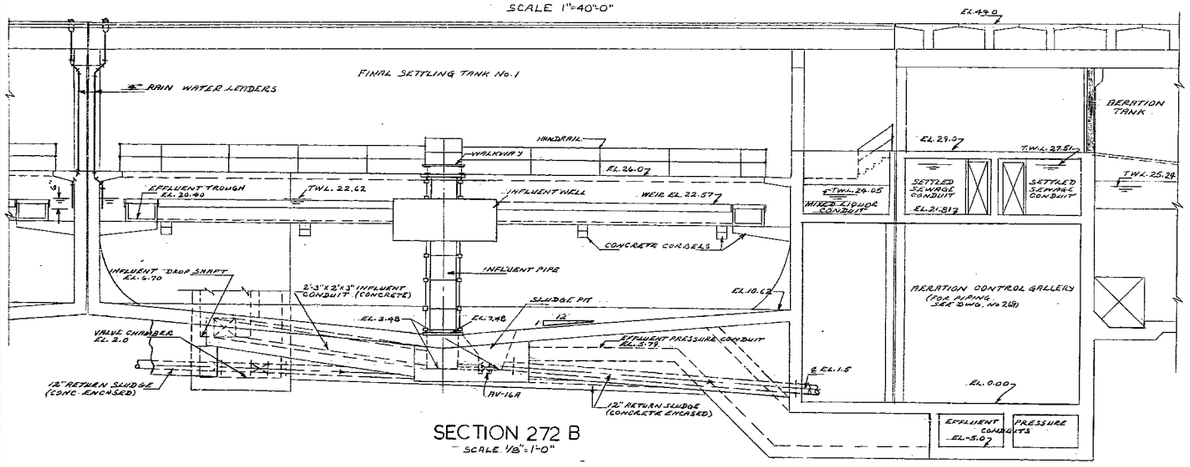

SECTION 272 B
SCALE 1/8"=1'-0"

NOTE: REFER TO REILCHAIN BELT SHOP DWGS. F-123, F-130-5 FOR DETAILS OF SLUDGE COLLECTOR MECHANISM.

FOR ACTUAL ELEV. SUBTRACT 0.37 FT.

AS BUILT

AUG ,, 1966

REVISIONS		
No.	DATE	DETAIL

PROVINCE OF MANITOBA — J. W. MacLAREN — REGISTERED ENGINEER

PROVINCE OF MANITOBA — J. L. GREER — REGISTERED ENGINEER

THE METROPOLITAN CORPOPATION OF GREATER WINNIPEG
WATERWORKS AND WASTE DISPOSAL DIVISION

NORTH END SEWAGE TREATMENT PLANT

CONTRACT B — MECHANICAL
FINAL SETTLING TANKS
PLANS AND SECTIONS

JAMES F. MACLAREN LIMITED, ENGINEERS, TORONTO
W.L. WARDROP ASSOCIATES (MANAGEMENT) LIMITED, ENGINEERING CONSULTANTS, WINNIPEG

APPROVED
ENGINEER OF DESIGN
ENGINEER OF WASTE DISPOSAL
DIRECTOR & CHIEF ENGINEER

DATE	SCALE	DWG. No.	
AUGUST 15, 1963	AS SHOWN	272 OF 315	NEP-272

REF. or DRAWING No. NEP-272

DETAILS

FILE 530 - D - 4856