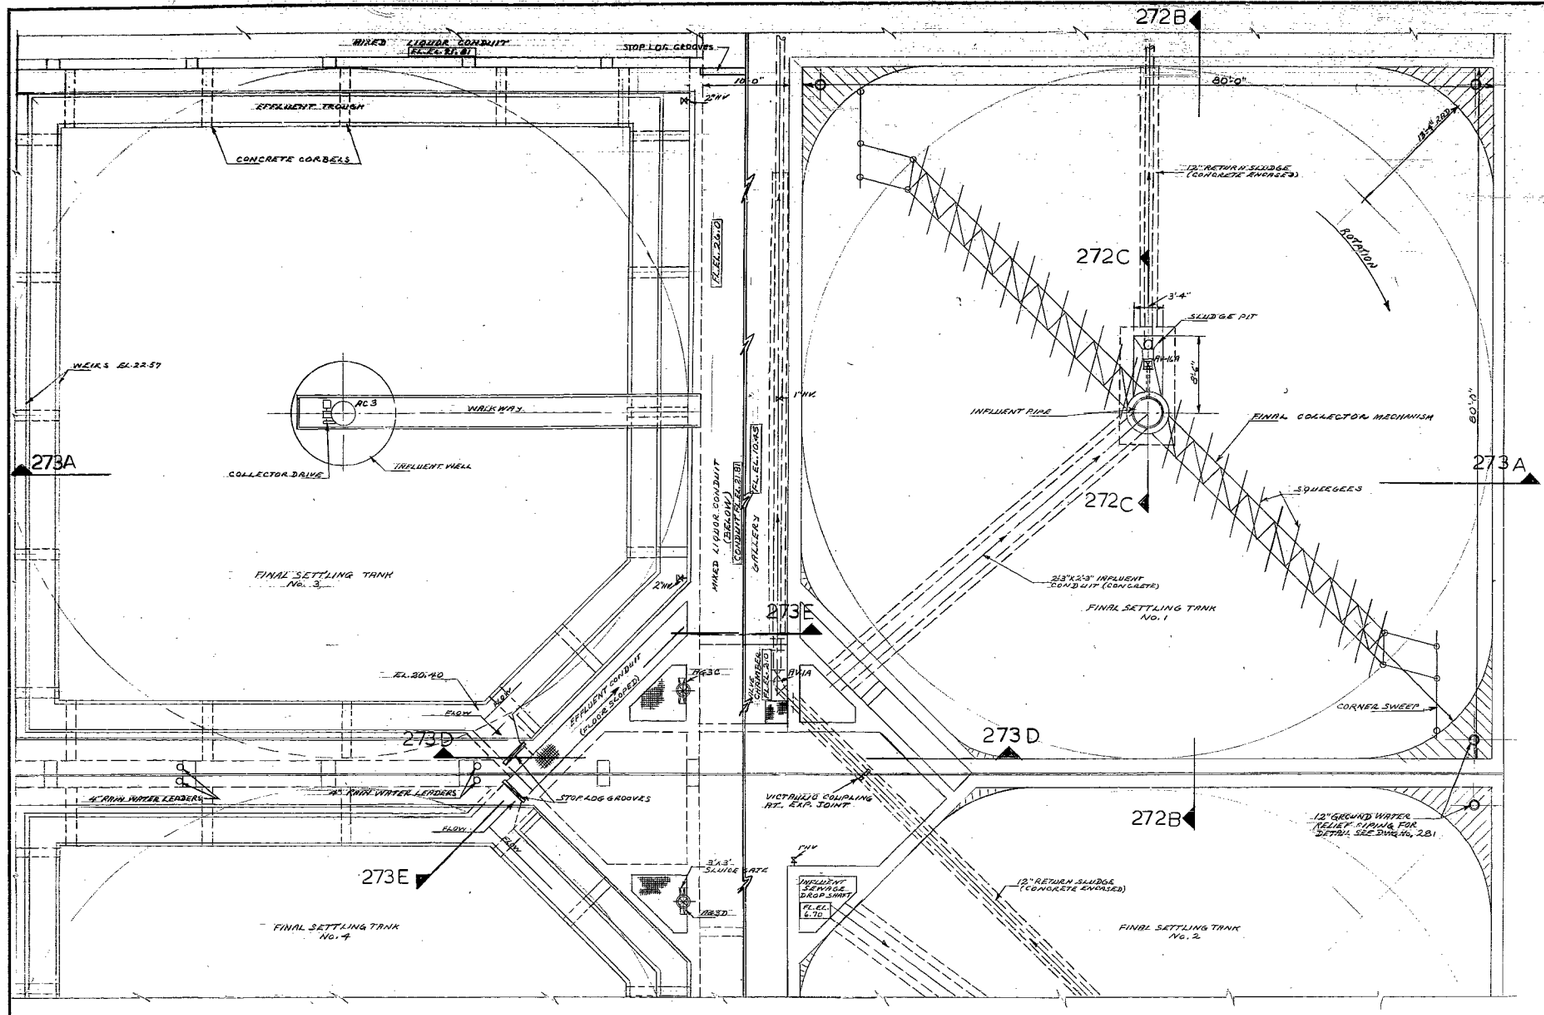

PLAN BELOW ELEV. 30.0

PLAN BELOW ELEV. 12.0

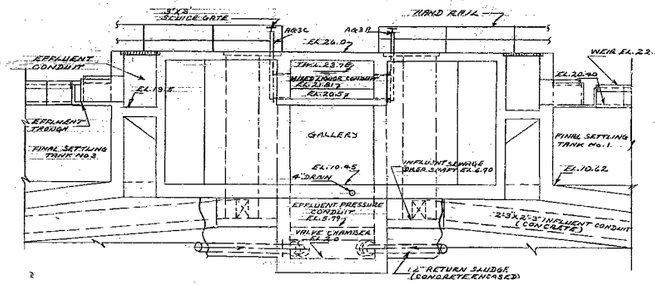

SECTION 273D

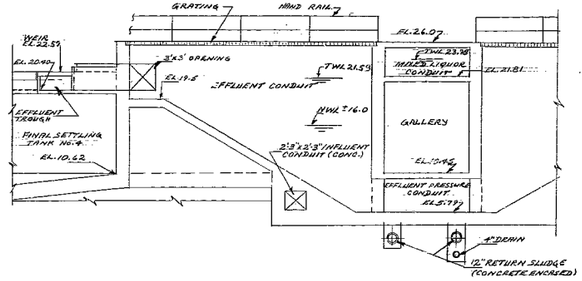

SECTION 273E

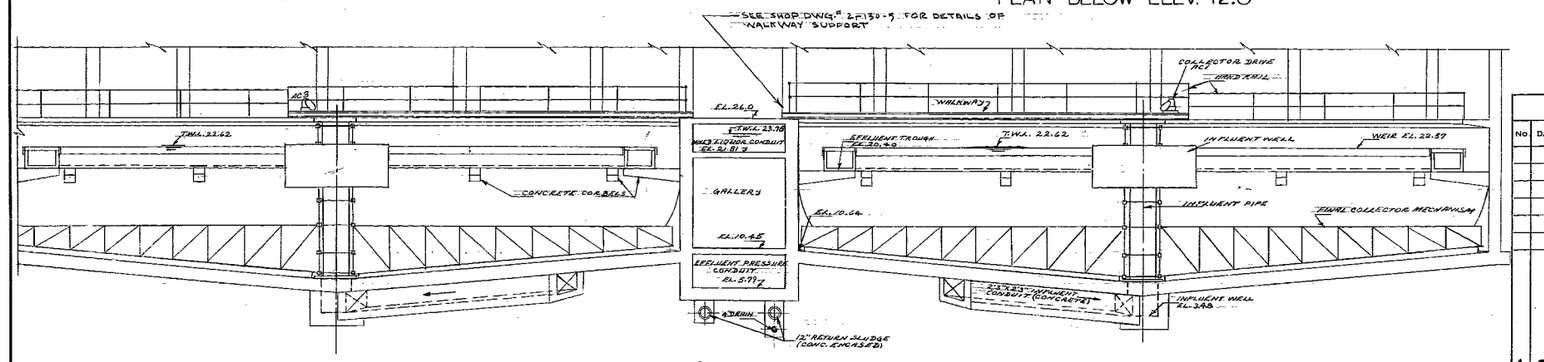

SECTION 273A

NOTE: REFER TO REX CHAIN BELT SHOP DWGS. #1 1, 2, 3 & 19-130-3 FOR DETAILS OF SLUDGE COLLECTOR MECHANISM.

FOR ACTUAL ELEV. SUBTRACT 0.37 FT.

AS BUILT

AUG. 1966

REVISIONS		
No.	DATE	DETAIL

PROVINCE OF MANITOBA — J. W. MacLAREN — REGISTERED ENGINEER

PROVINCE OF MANITOBA — J. L. GREER — REGISTERED ENGINEER

THE METROPOLITAN CORPORATION OF GREATER WINNIPEG
WATERWORKS AND WASTE DISPOSAL DIVISION

NORTH END SEWAGE TREATMENT PLANT

CONTRACT B - MECHANICAL
FINAL SETTLING TANKS
PLAN AND SECTIONS

JAMES F. MacLAREN LIMITED ENGINEERS TORONTO

W.L. WARDROP ASSOCIATES (MANAGEMENT) LIMITED ENGINEERING CONSULTANTS WINNIPEG

APPROVED

ENGINEER OF DESIGN

ENGINEER OF WASTE DISPOSAL

DIRECTOR & CHIEF ENGINEER

DATE: AUGUST 15, 1963 | SCALE: 1/8" = 1'-0" | DWG. No. 273 OF 315 | NEP-273

FILE 530-D-4857

DETAILS — Rec. — Drawing No. NEP-273