


1 EXIST BRIDGE CROSS SECTION
 1 : 50
 - LOOKING NORTH, AT PIER LOCATIONS



2 FINAL PROPOSED BRIDGE CROSS SECTION
 1 : 50
 - LOOKING NORTH, AT PIER LOCATIONS
 - NEW INTERMEDIATE DIAPHRAGMS NOT SHOWN FOR CLARITY

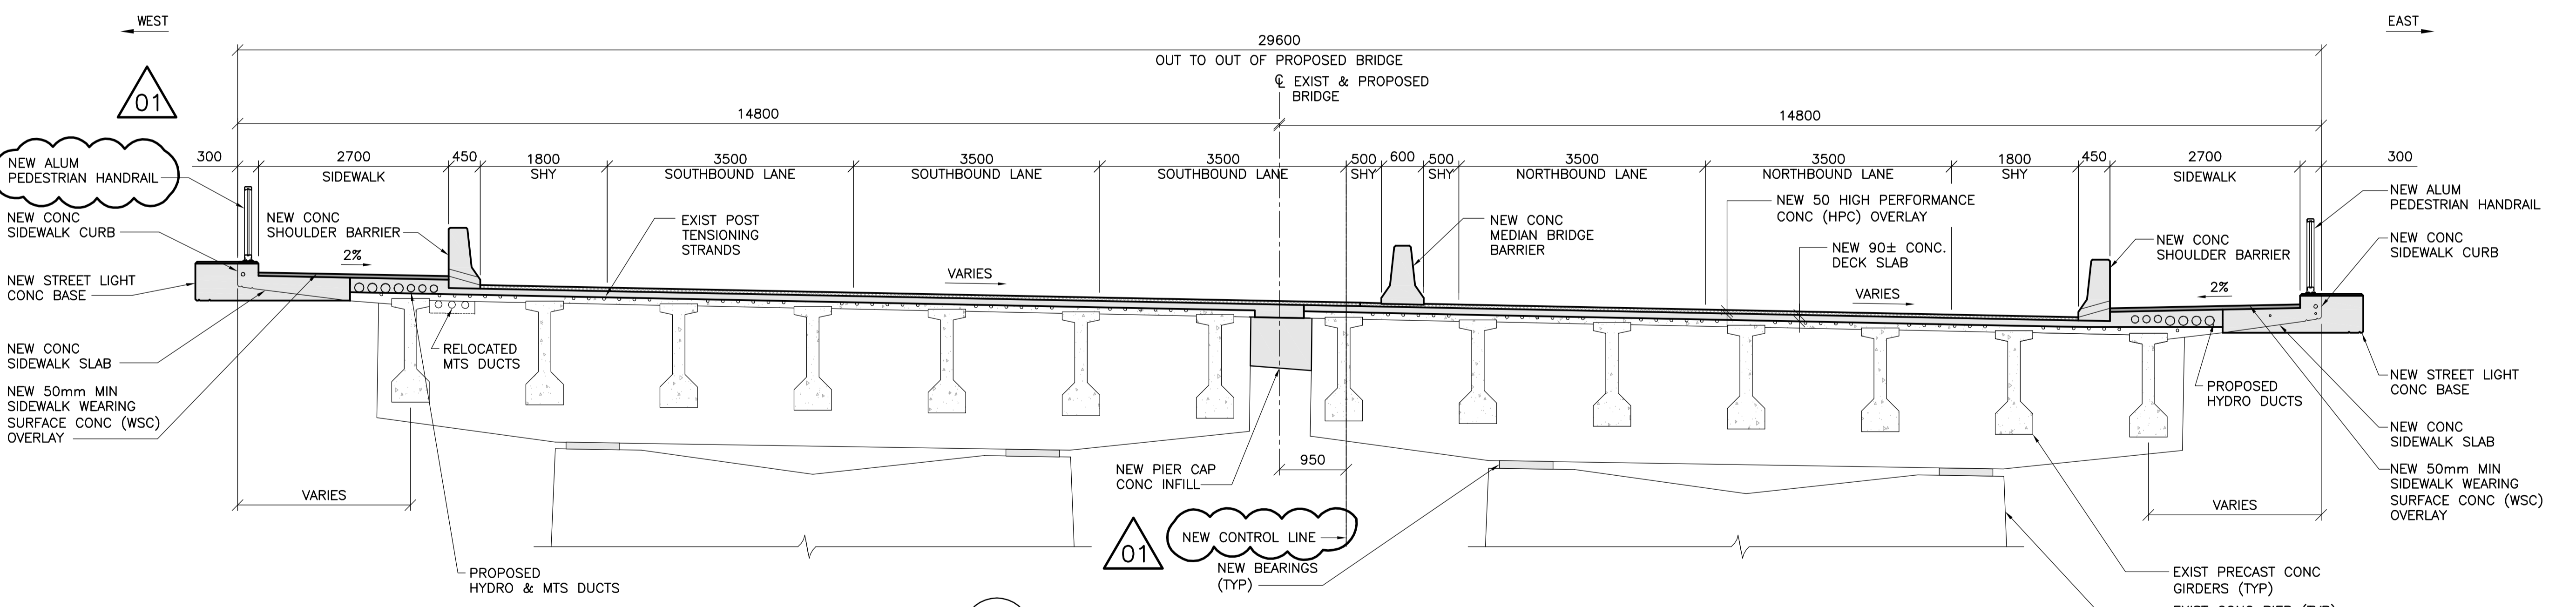

B.M. ELEV.	F.B.	DATE	BY
01	ISSUED FOR ADDENDUM 1	11.03.07	VB
00	ISSUED FOR TENDER	11.02.18	VB
NO.	REVISIONS	DATE	BY

WARDROP
 A TETRA TECH COMPANY

DESIGNED BY S.Y.	CHECKED BY V.B.
DRAWN BY B.M.	APPROVED BY R.H.W.
HOR. SCALE: AS NOTED	RELEASED FOR CONSTRUCTION DATE 11.02.16
VERTICAL: AS NOTED	ORIGINAL SIGNED
DATE 10.10.20	MATT CHESLETT, P.ENG. BRIDGE PROJECTS ENGINEER



THE CITY OF WINNIPEG
 PUBLIC WORKS DEPARTMENT
 ENGINEERING DIVISION

OSBORNE STREET BRIDGE
 REHABILITATION & RELATED WORKS

CITY DRAWING NUMBER B109-11-13
 SHEET 8 OF 131

GENERAL ARRANGEMENT
 CROSS SECTIONS

8