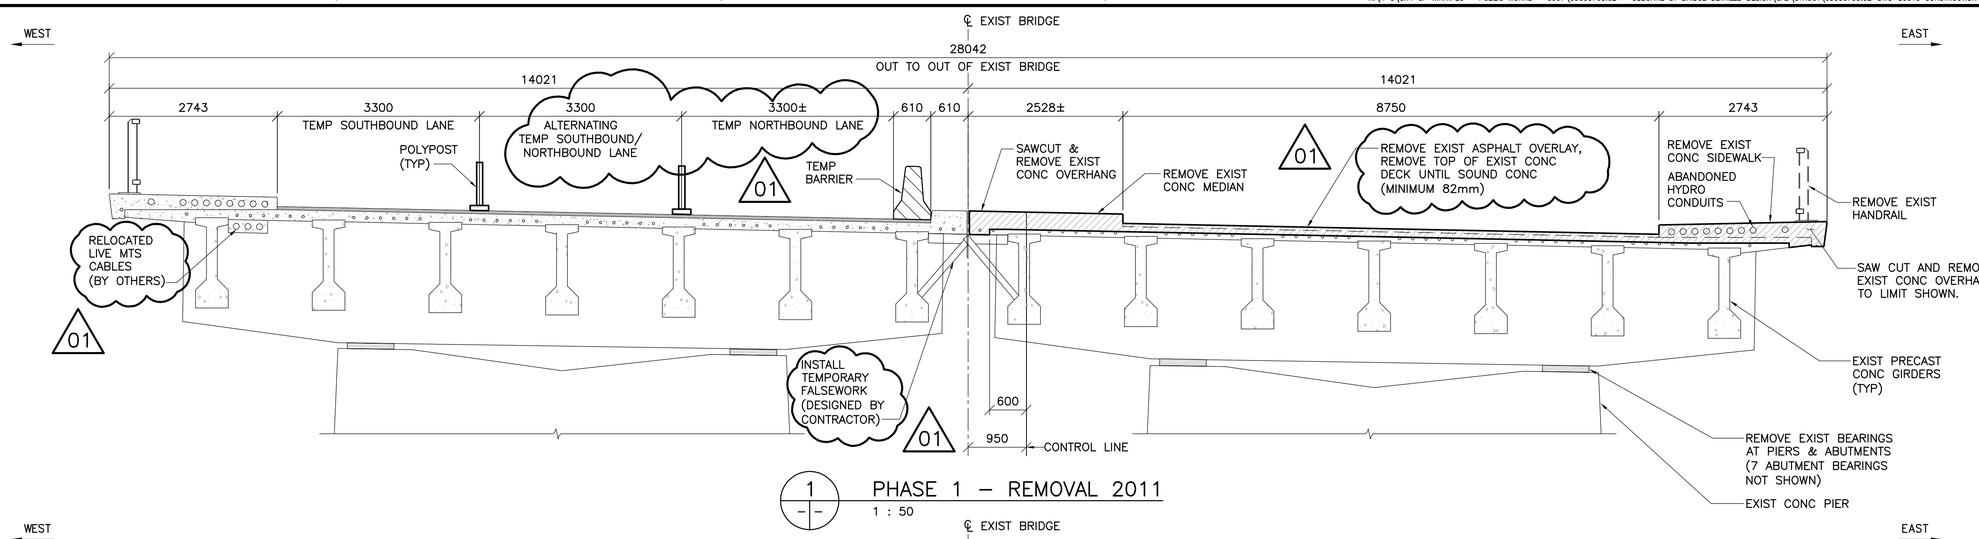

1 / – – PHASE 1 – REMOVAL 2011
1 : 50

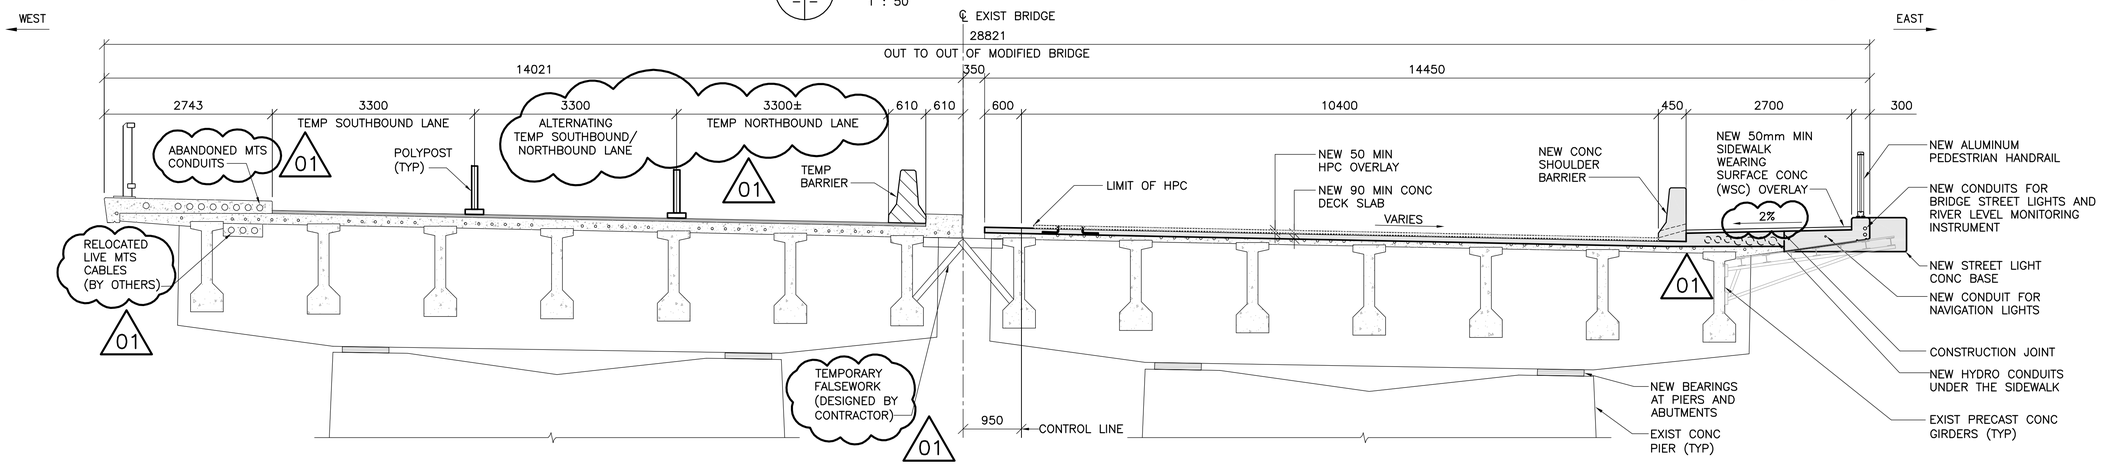

2 / – – PHASE 1 – CONSTRUCTION 2011
1 : 50

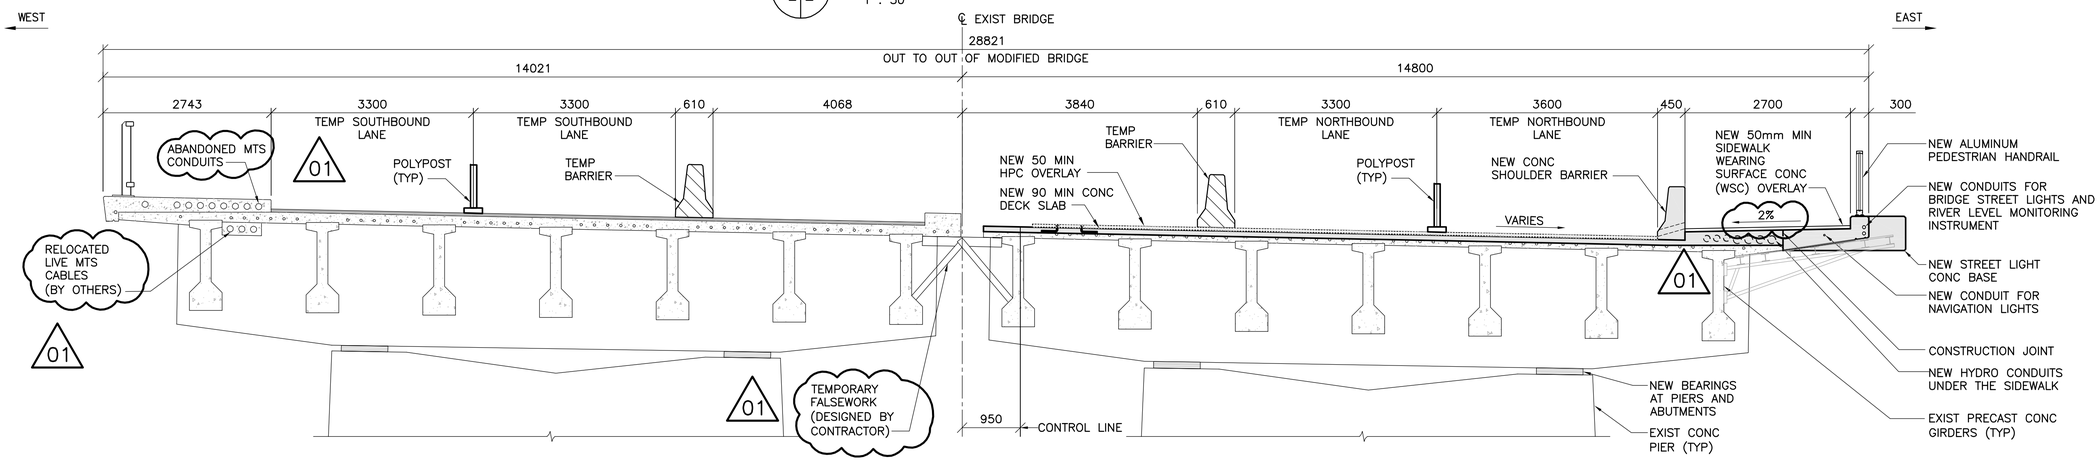

3 / – – PHASE 1A – CONSTRUCTION 2011
1 : 50

NOTES

01

1. TEMPORARY FALSEWORK TO BE DESIGNED AND INSTALLED BY THE CONTRACTOR TO WITHSTAND A LOAD OF 15kN/m
2. THE CONTRACTOR SHALL EXERCISE EXTREME CARE WHEN WORKING NEAR THE HYDRO AND MTS DUCTS.

APEGM
Certificate of Authorization
Wardrop Engineering Inc.
No. 195 Date: April 30, 2011

B.M. ELEV.		F.B.		
01	ISSUED FOR ADDENDUM 1	11.03.07	VB	
00	ISSUED FOR TENDER	11.02.18	VB	
NO.	REVISIONS	DATE	BY	

WARDROP
A TETRA TECH COMPANY

DESIGNED BY	S.Y.	CHECKED BY	V.B.
DRAWN BY	B.M.	APPROVED BY	R.H.W.
HOR. SCALE: / VERTICAL:	AS NOTED	RELEASED FOR CONSTRUCTION	DATE ORIGINAL SIGNED 11.02.16
DATE	10.10.13	MATT CHISLETT, P.ENG BRIDGE PROJECTS ENGINEER	

PROVINCE OF MANITOBA
ORIGINAL SIGNED 11.02.16
V. BANTHIA
Member
23477
REGISTERED PROFESSIONAL ENGINEER

CONSULTANT DRAWING NO.
0900070502-DWG-S0010

Winnipeg

THE CITY OF WINNIPEG
PUBLIC WORKS DEPARTMENT
ENGINEERING DIVISION

OSBORNE STREET BRIDGE
REHABILITATION & RELATED WORKS

CITY DRAWING NUMBER
B109-11-015

SHEET 10 OF 131

CONSTRUCTION STAGING – PHASE 1 REMOVAL AND PHASE 1 & 1A CONSTRUCTION 2011

10