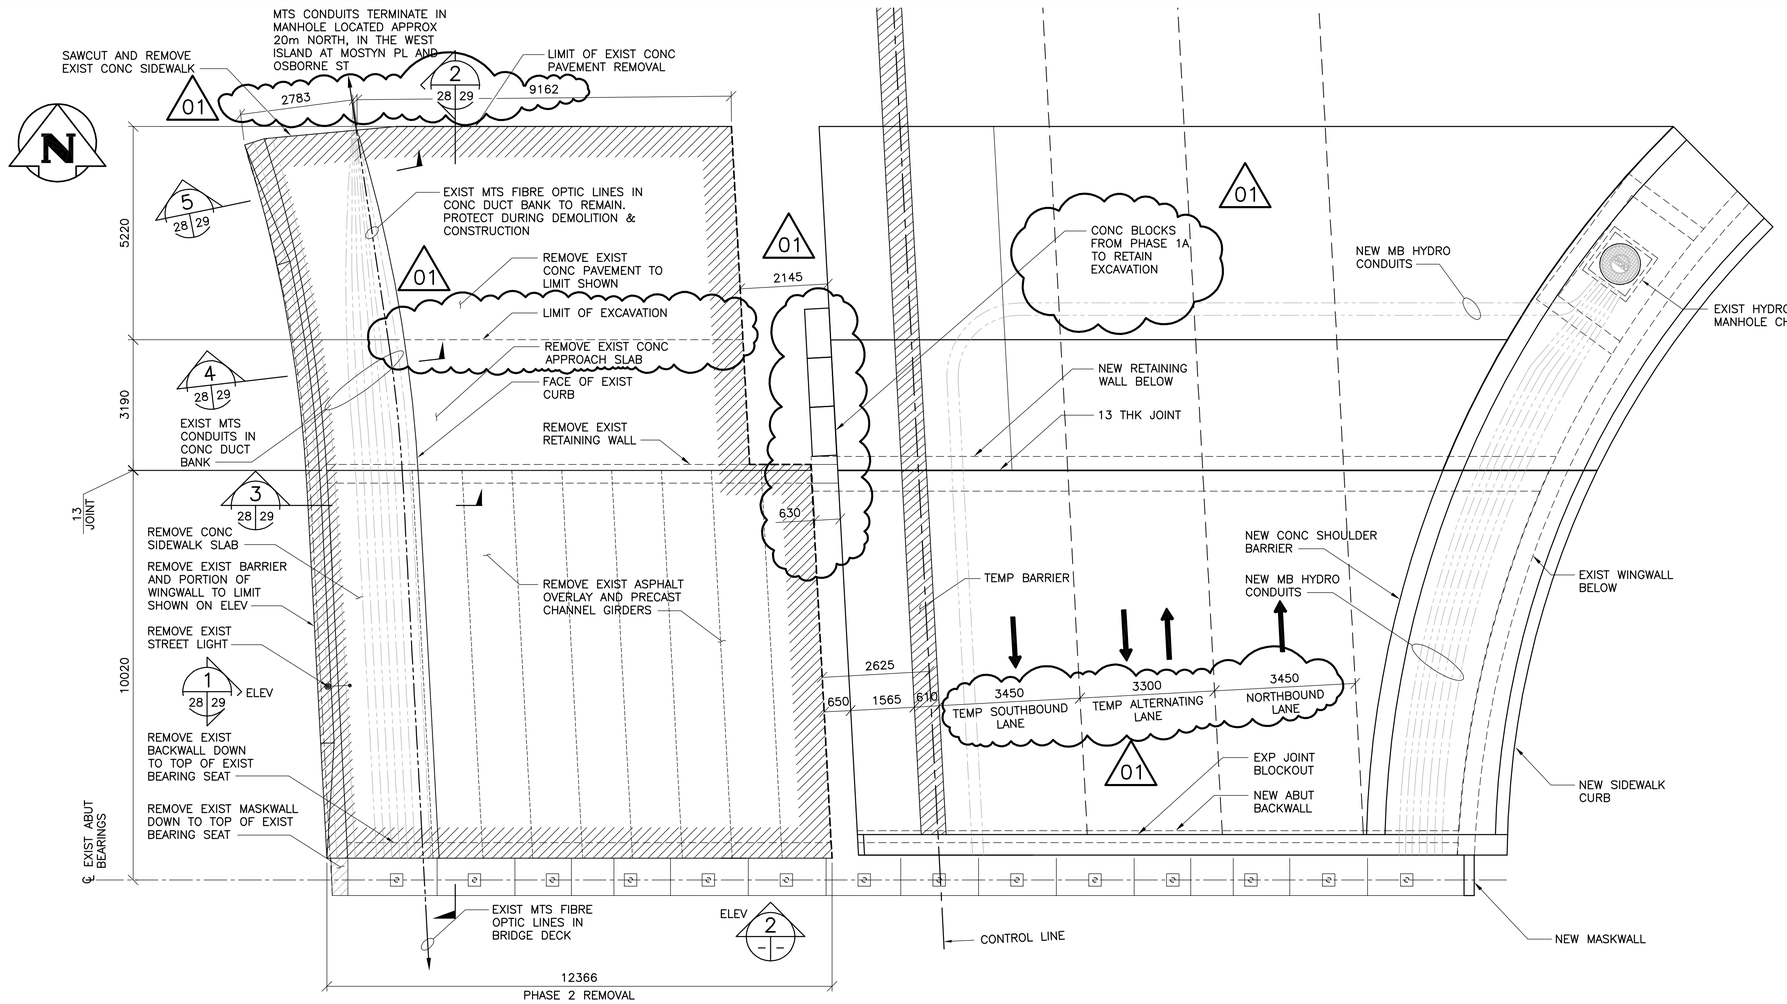

1 — PLAN – NORTH ABUTMENT PHASE 2 REMOVAL

1 : 75

– CONTRACTOR IS RESPONSIBLE TO LOCATE, PROTECT AND UNDERTAKE ALL WORKS WITHOUT DAMAGING THE EXISTING MTS FIBRE OPTIC LINES OR CONC DUCT BANK WITH THE FIBRE OPTIC LINES

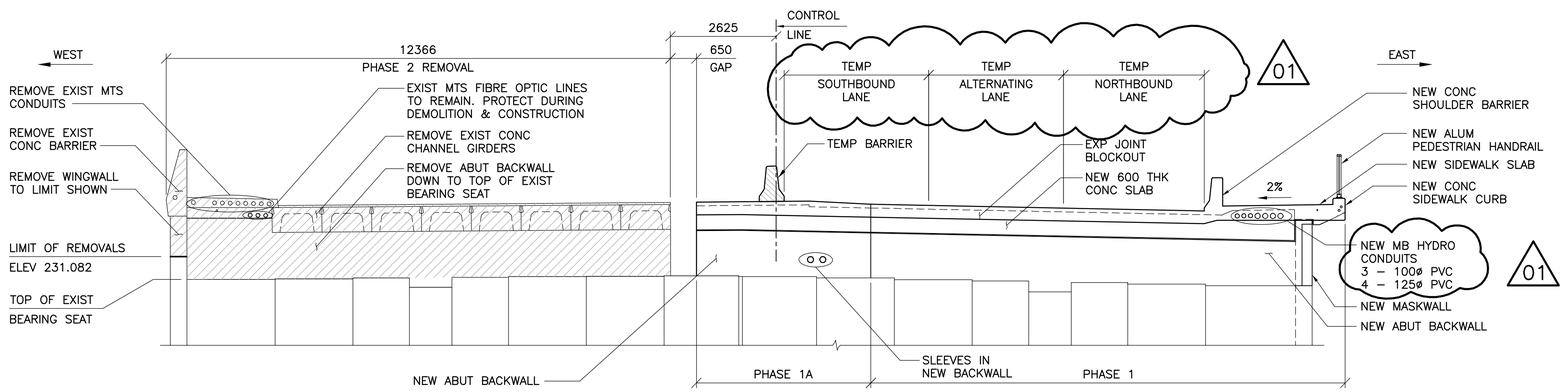

2 — NORTH ELEVATION – PHASE 2 REMOVAL

1 : 75

– EXIST GIRDERS NOT SHOWN FOR CLARITY

01 — MTS WILL RELOCATE ALL LINES IN EXISTING MTS CONDUITS TO BE REMOVED TO THE THREE CONDUITS CONTAINING FIBRE OPTIC LINES. CONTRACTOR TO COORDINATE ACCESS AND WORK WITH MTS PRIOR TO REMOVING EXISTING MTS CONDUITS.

APEGM Certificate of Authorization — Wardrop Engineering Inc. — No. 195 — Date: April 30, 2011

B.M. ELEV.		F.B.		
01	ISSUED FOR ADDENDUM 1	11.03.07	RHW	
00	ISSUED FOR TENDER	11.02.16	RHW	
NO.	REVISIONS	DATE	BY	

WARDROP — A TETRA TECH COMPANY

DESIGNED BY	S.Y.	CHECKED BY	R.H.W.
DRAWN BY	B.M.	APPROVED BY	R.H.W.
HOR. SCALE: / VERTICAL:	AS NOTED	RELEASED FOR CONSTRUCTION	DATE ORIGINAL SIGNED 11.02.16
DATE	10.10.20	MATT CHISLETT, P.ENG BRIDGE PROJECTS ENGINEER	

PROVINCE OF MANITOBA — ORIGINAL SIGNED 11.02.16 W.R. HALDANE-WILSONE — REGISTERED PROFESSIONAL ENGINEER

CONSULTANT DRAWING NO. 0900070502-DWG-S0028

Winnipeg

THE CITY OF WINNIPEG
PUBLIC WORKS DEPARTMENT
ENGINEERING DIVISION

OSBORNE STREET BRIDGE
REHABILITATION & RELATED WORKS

CITY DRAWING NUMBER B109-11-033

SHEET 28 OF 131

NORTH ABUTMENT AND APPROACH SLAB PHASE 2 REMOVAL

28