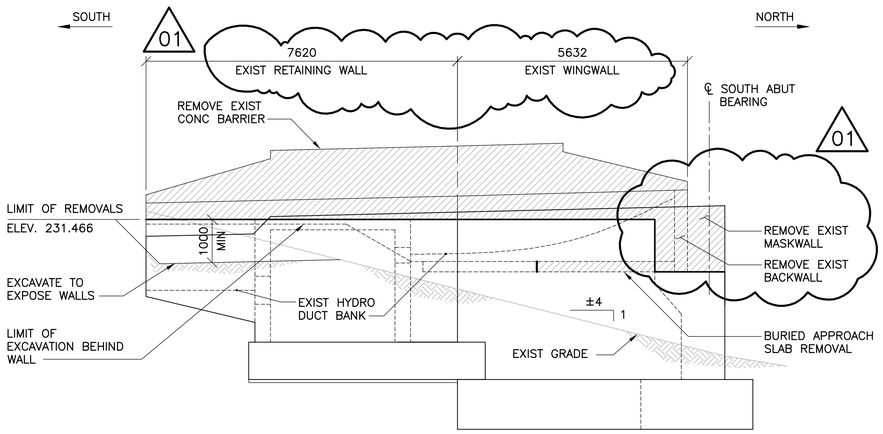

1 SOUTH EAST ELEVATION
36 37
1 : 75

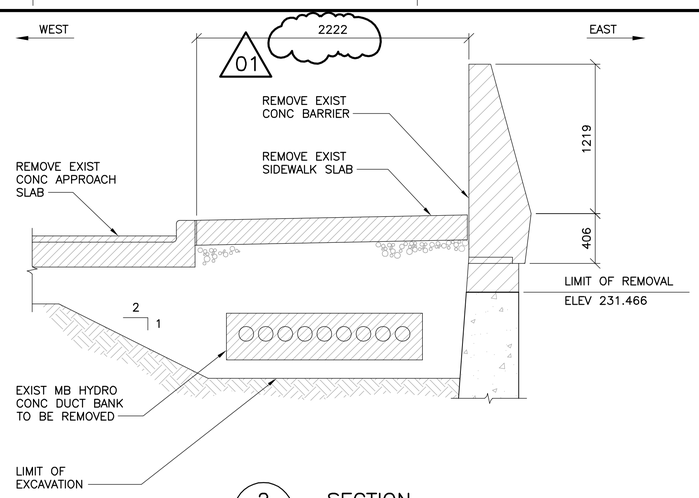

2 SECTION
36 37
1 : 25

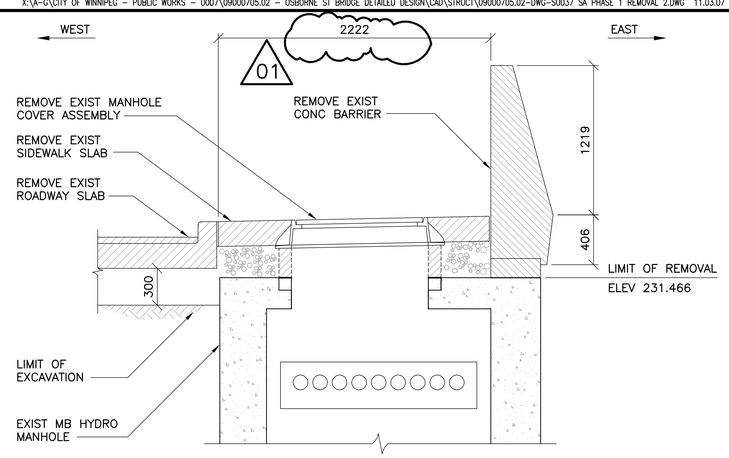

3 SECTION
36 37
1 : 25

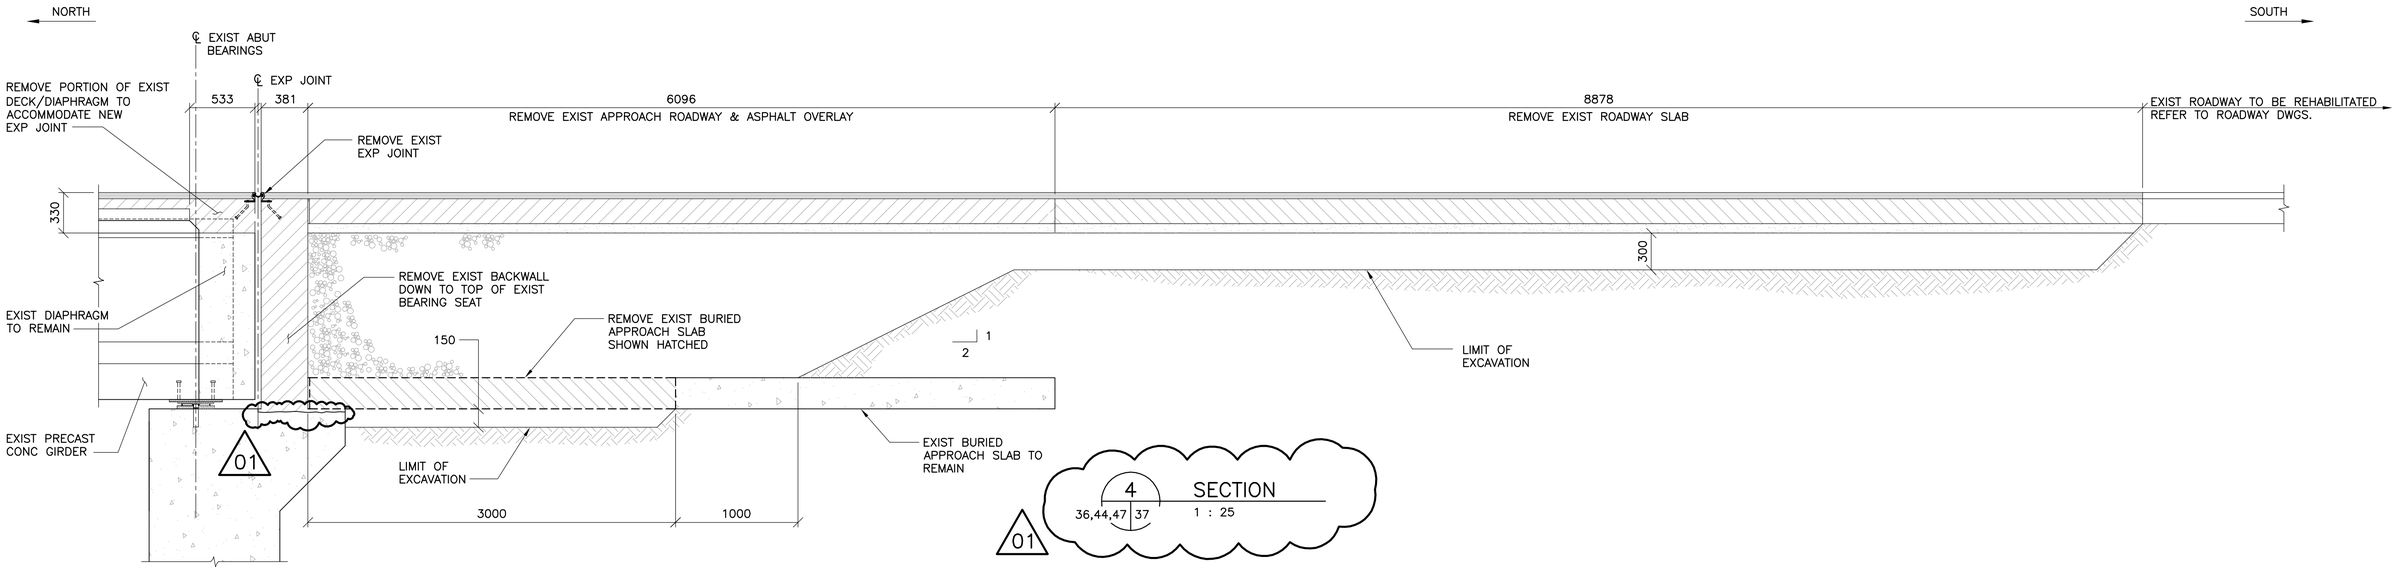

4 SECTION
36,44,47 37
1 : 25

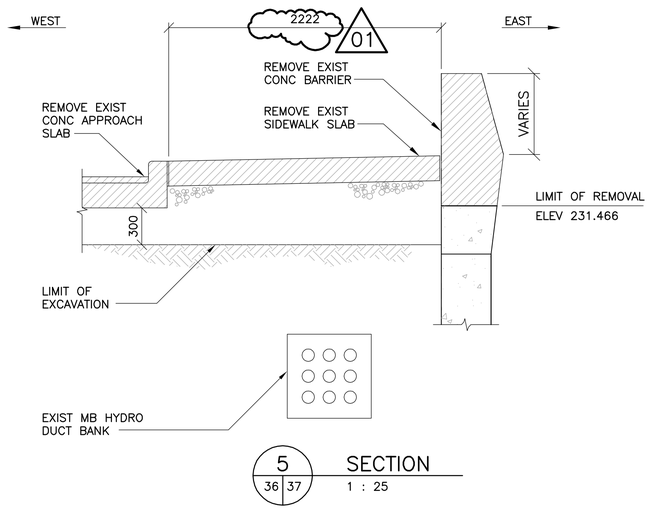

5 SECTION
36 37
1 : 25

APEGM
Certificate of Authorization
Wardrop Engineering Inc.
No. 195 Date: April 30, 2011

NO.	REVISIONS	DATE	BY
01	ISSUED FOR ADDENDUM 1	11.03.07	RHW
00	ISSUED FOR TENDER	11.02.18	RHW

B.M. ELEV. F.B.

WARDROP
A TETRA TECH COMPANY

DESIGNED BY S.Y. | CHECKED BY R.H.W.
DRAWN BY B.M. | APPROVED BY R.H.W.
HOR. SCALE: AS NOTED | RELEASED FOR CONSTRUCTION DATE
VERTICAL: | ORIGINAL SIGNED 11.02.16
DATE 10.10.20 | MATT CHISLETT, P.ENG BRIDGE PROJECTS ENGINEER

PROVINCE OF MANITOBA
ORIGINAL SIGNED 11.02.16
W.R. HALDANE-WILSONE
REGISTERED PROFESSIONAL ENGINEER

CONSULTANT DRAWING NO.
0900070502-DWG-S0037

Winnipeg
THE CITY OF WINNIPEG
PUBLIC WORKS DEPARTMENT
ENGINEERING DIVISION

OSBORNE STREET BRIDGE
REHABILITATION & RELATED WORKS

CITY DRAWING NUMBER
B109-11-042

SHEET 37 OF 131

SOUTH ABUTMENT AND APPROACH SLAB PHASE 1 REMOVAL

37