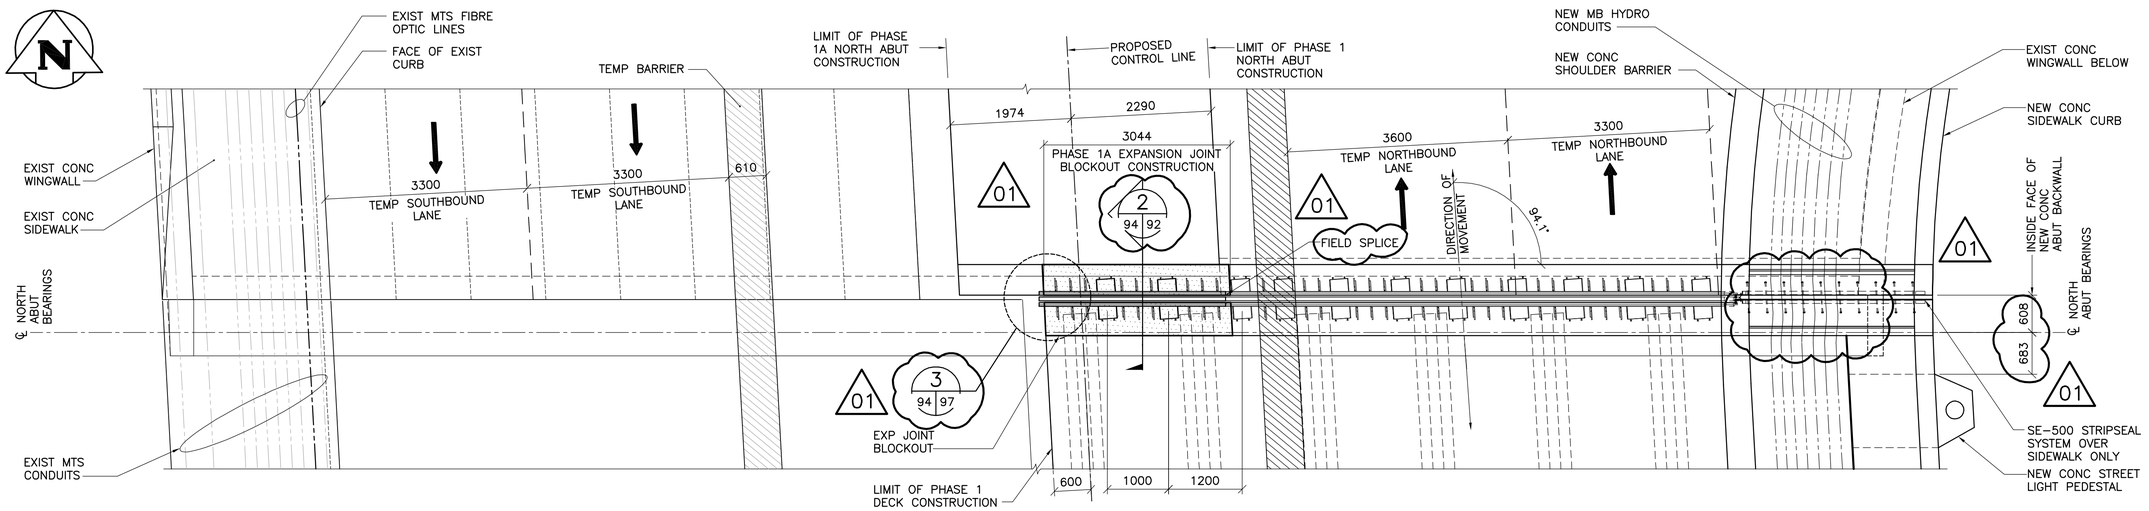

1 / – / – PLAN – NORTH EXPANSION JOINT PHASE 1A CONSTRUCTION

1 : 50

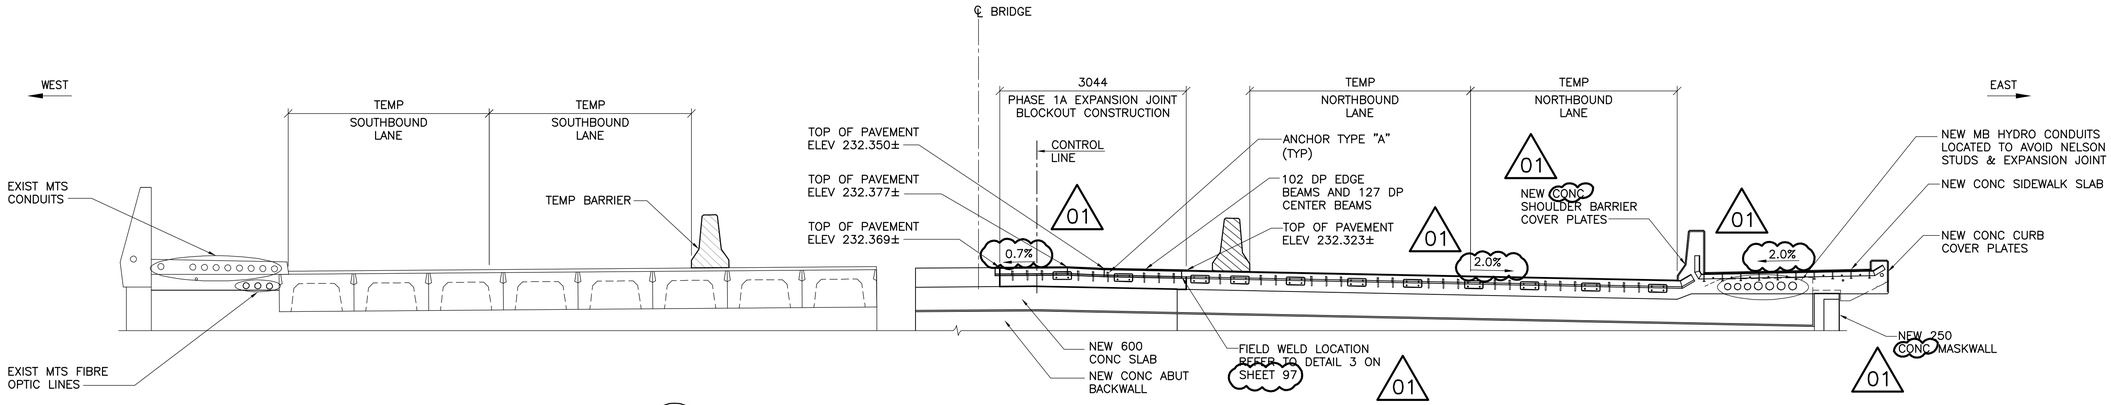

2 / – / – ELEVATION – INSIDE FACE OF ABUTMENT BACKWALL PHASE 1A

1 : 50

– EXIST GIRDERS NOT SHOWN FOR CLARITY

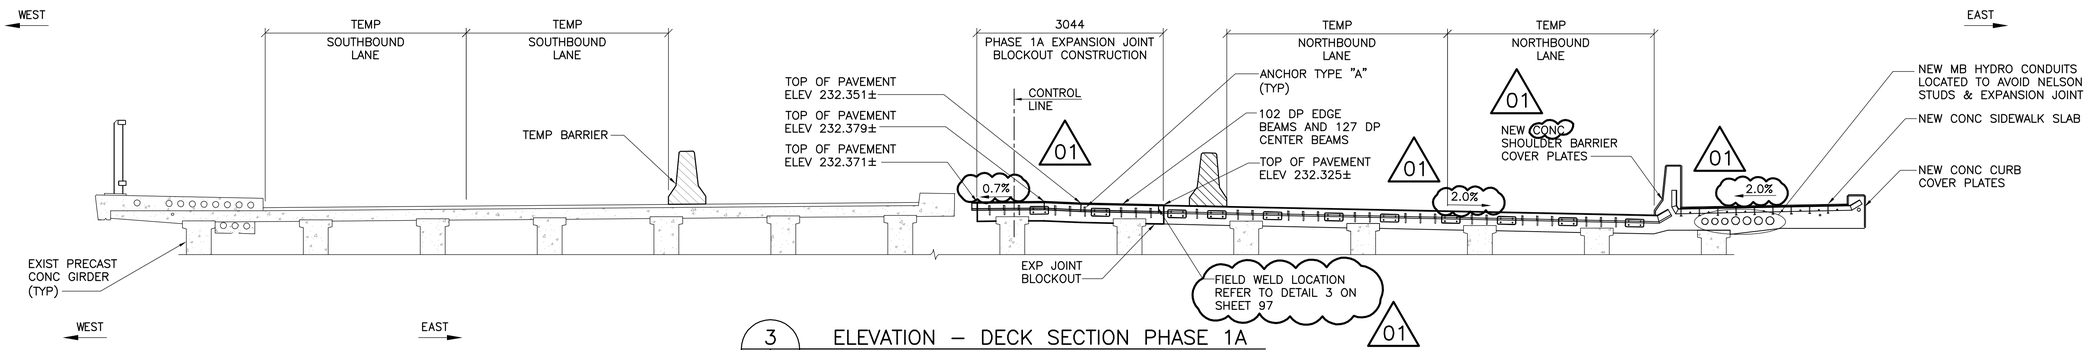

3 / – / – ELEVATION – DECK SECTION PHASE 1A

1 : 50

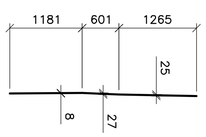

4 / – / – PROFILE DETAIL – EDGE AND CENTRE BEAMS PHASE 1A

1 : 50

APEGM
Certificate of Authorization
Wardrop Engineering Inc.
No. 195 Date: April 30, 2011

NO.	REVISIONS	DATE	BY
01	ISSUED FOR ADDENDUM 1	11.03.07	VB
00	ISSUED FOR TENDER	11.02.18	VB

B.M. ELEV. F.B.

WARDROP
A TETRA TECH COMPANY

DESIGNED BY K.Y. | CHECKED BY V.B.
DRAWN BY E.M.M. | APPROVED BY R.H.W.
HOR. SCALE: AS NOTED
VERTICAL:
RELEASED FOR CONSTRUCTION DATE ORIGINAL SIGNED 11.02.16
DATE 10.12.03
MATT CHISLETT, P.ENG BRIDGE PROJECT'S ENGINEER

PROVINCE OF MANITOBA
ORIGINAL SIGNED 11.02.16
V. BANTHIA
Member
23477
REGISTERED PROFESSIONAL ENGINEER

CONSULTANT DRAWING NO.
0900070500-DWG-S0094

Winnipeg

THE CITY OF WINNIPEG
PUBLIC WORKS DEPARTMENT
ENGINEERING DIVISION

OSBORNE STREET BRIDGE
REHABILITATION & RELATED WORKS

CITY DRAWING NUMBER
B109-11-099

SHEET 94 OF 131

NORTH EXPANSION JOINT – PHASE 1A CONSTRUCTION

94