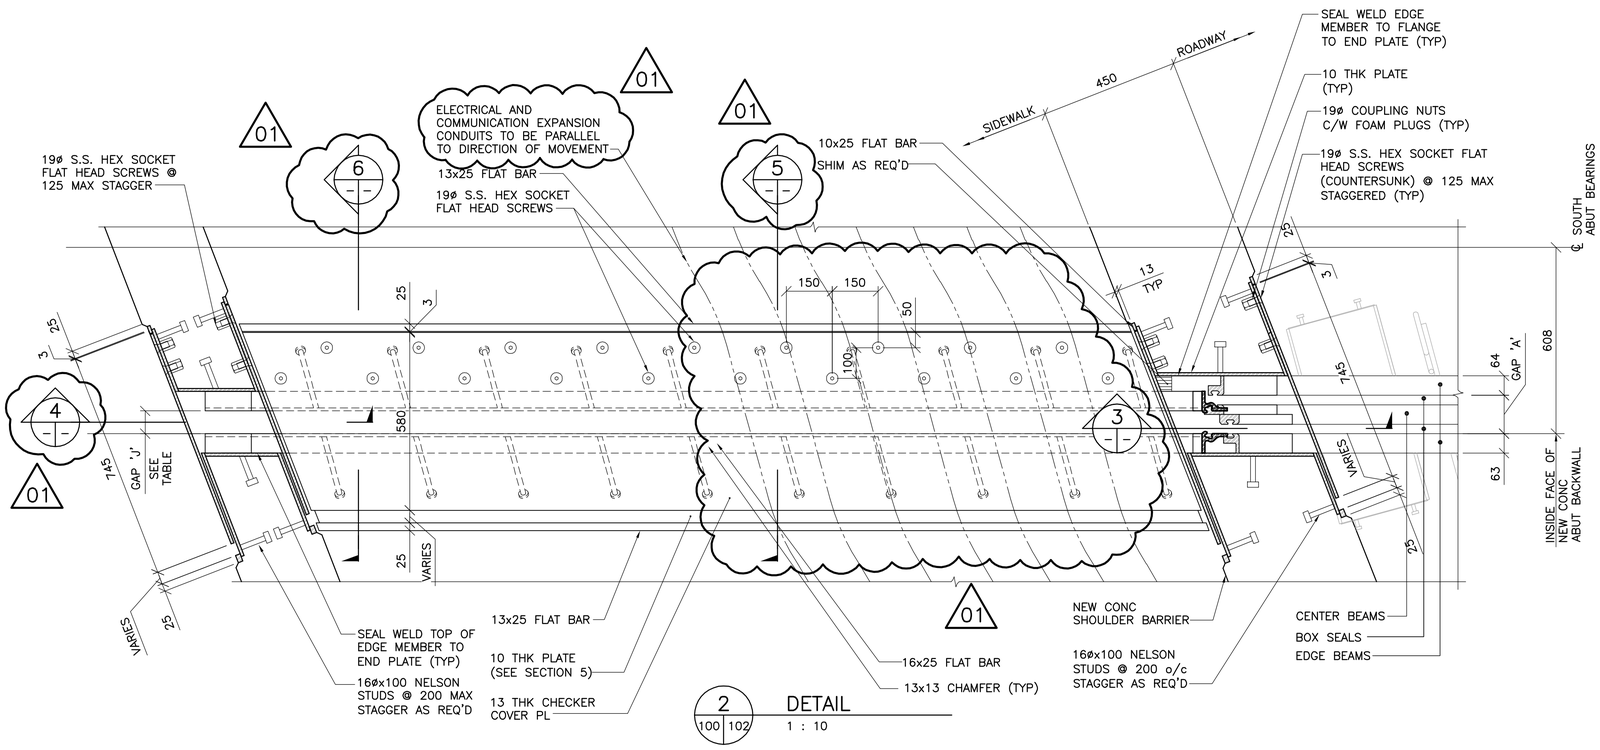

2 | 100 | 102 DETAIL
1 : 10

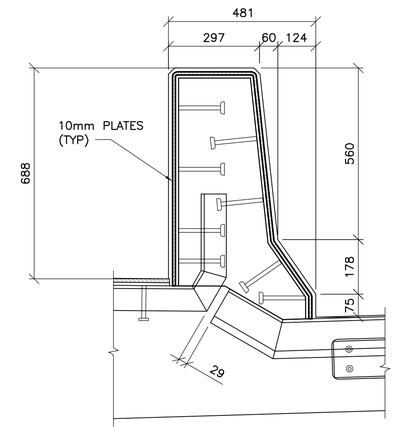

3 | – | – SECTION
1 : 10
– WABO MODULAR D600

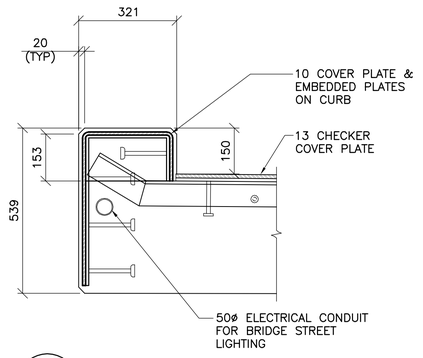

4 | – | – SECTION
1 : 10
– SE500 STRIPSEAL

01

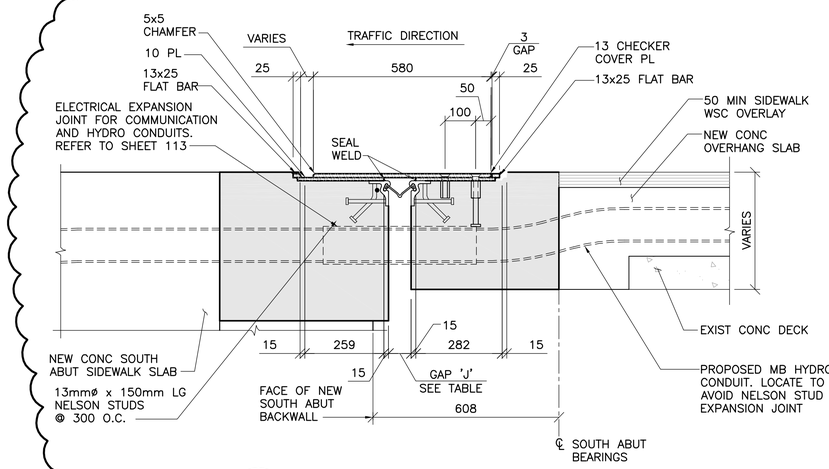

5 | – | – SECTION AT SIDEWALK
1 : 10
– SHOWN FOR 20°C

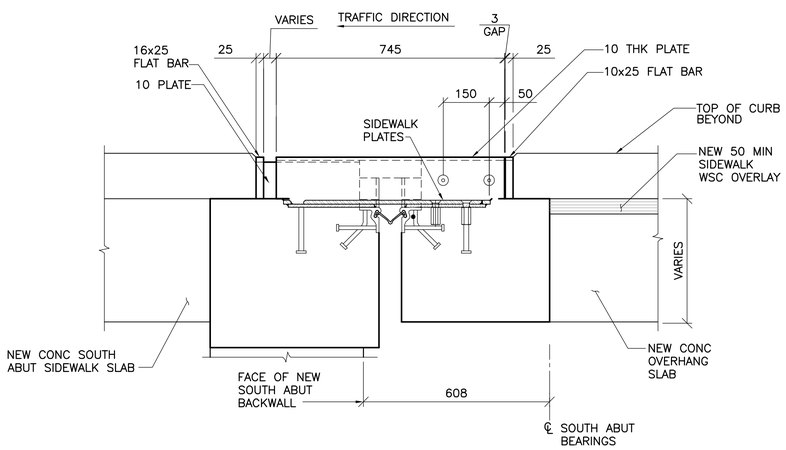

6 | – | – SECTION AT SIDEWALK
1 : 10
– SHOWN FOR 20°C

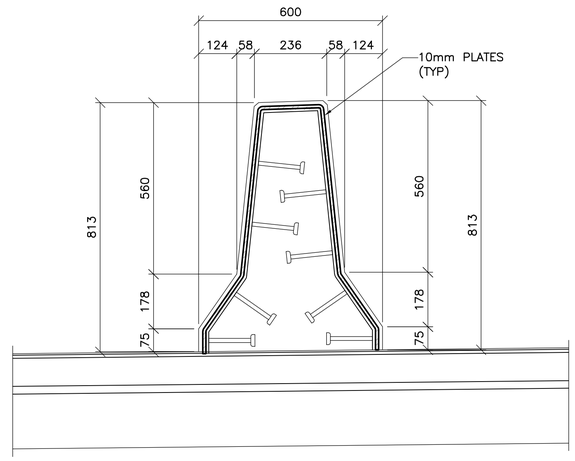

1 | – | – SECTION AT CONC MEDIAN BARRIER
1 : 10

APEGM
Certificate of Authorization
Wardrop Engineering Inc.
No. 195 Date: April 30, 2011

NO.	REVISIONS	DATE	BY
01	ISSUED FOR ADDENDUM 1	11.03.07	VB
00	ISSUED FOR TENDER	11.02.18	VB

B.M. ELEV. F.B.

WARDROP
A TETRA TECH COMPANY

DESIGNED BY K.Y. | CHECKED BY V.B.
DRAWN BY E.M.M. | APPROVED BY R.H.W.
HOR. SCALE: AS NOTED
VERTICAL:
RELEASED FOR CONSTRUCTION DATE ORIGINAL SIGNED 11.02.16
DATE 10.12.03
MATT CHISLETT, P.ENG BRIDGE PROJECT'S ENGINEER

PROVINCE OF MANITOBA – ORIGINAL SIGNED 11.02.16 – V. BANTHIA Member 23477 – REGISTERED PROFESSIONAL ENGINEER

CONSULTANT DRAWING NO. 0900070502-DWG-S0102

Winnipeg
THE CITY OF WINNIPEG
PUBLIC WORKS DEPARTMENT
ENGINEERING DIVISION

OSBORNE STREET BRIDGE
REHABILITATION & RELATED WORKS

CITY DRAWING NUMBER B109-11-107
SHEET 102 OF 131

SOUTH EXPANSION JOINT

102