



1 PROFILE 'C' - ON ALIGNMENT CONTROL LINE
VERT = 1 : 450 HOR = 1 : 1125

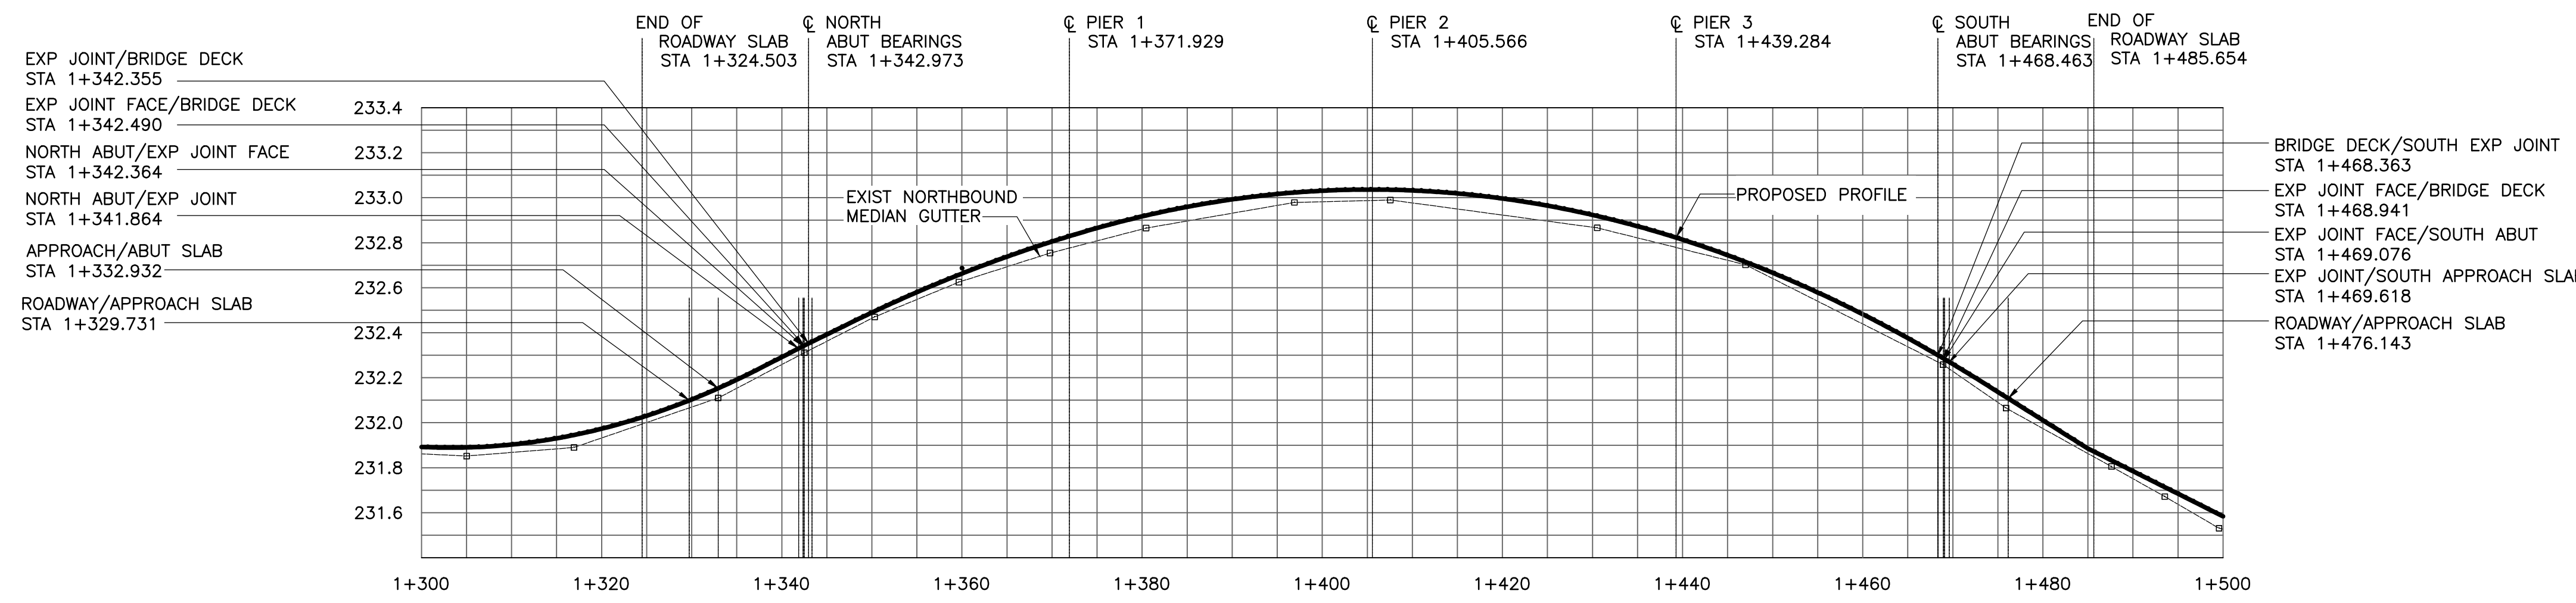

2 PROFILE 'D' - 1.512m EAST OF ALIGNMENT CONTROL LINE
VERT = 1 : 450 HOR = 1 : 1125

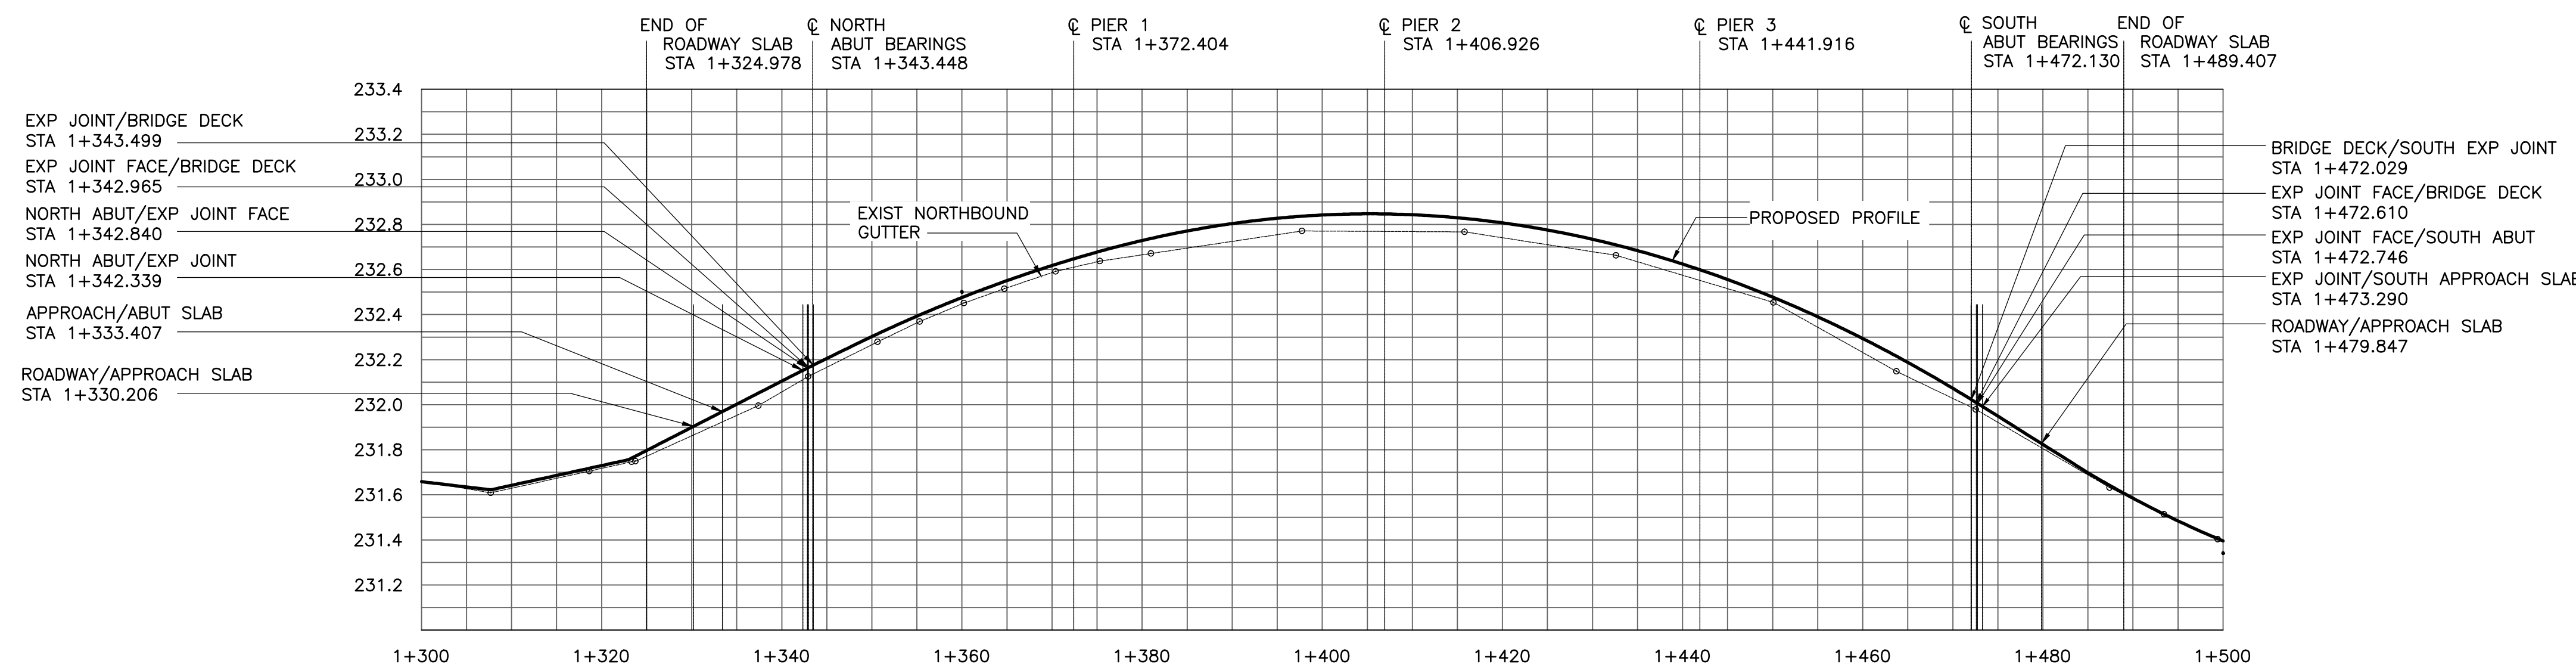


3 PROFILE 'E' - 10.328m EAST OF ALIGNMENT CONTROL LINE
VERT = 1 : 450 HOR = 1 : 1125

01



NO.	REVISIONS	DATE	BY
01	ISSUED FOR ADDENDUM 2	11.03.10	VB
00	ISSUED FOR TENDER	11.02.18	VB

WARDROP ATETRA TECH COMPANY	
DESIGNED BY: K.Y.	CHECKED BY: V.B.
DRAWN BY: C.T.	APPROVED BY: R.H.W.
HOR. SCALE: AS NOTED	RELEASED FOR CONSTRUCTION DATE: 11.02.16
VERTICAL: AS NOTED	ORIGINAL SIGNED: 11.02.16
DATE: 10.02.16	MAIT CHRELETT, P.ENG. BRIDGE PROJECTS ENGINEER

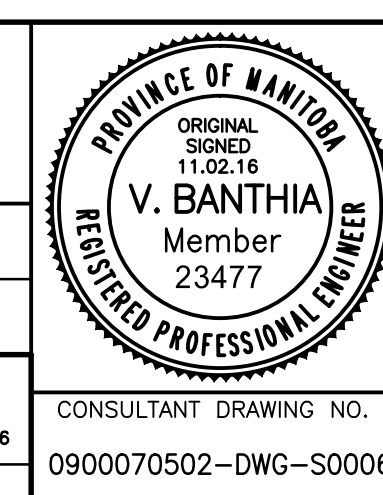

THE CITY OF WINNIPEG PUBLIC WORKS DEPARTMENT ENGINEERING DIVISION	
OSBORNE STREET BRIDGE REHABILITATION & RELATED WORKS	
DECK PROFILE 2	
CITY DRAWING NUMBER B109-11-011	SHEET 6 OF 131
6	