

THIS DRAWING MUST NOT BE SCALED.


THE GENERAL CONTRACTOR SHALL VERIFY ALL DIMENSIONS, DATUMS, AND LEVELS PRIOR TO COMMENCEMENT OF WORK. ALL ERRORS AND OMISSIONS TO BE REPORTED TO NUMBER TEN ARCHITECTURAL GROUP BEFORE PROCEEDING.

VARIOUS AND MODIFICATIONS TO WORK SHOWN ON THESE DRAWINGS SHALL NOT BE CARRIED OUT WITHOUT WRITTEN PERMISSION OF NUMBER TEN ARCHITECTURAL GROUP.


THIS DRAWING IS THE EXCLUSIVE PROPERTY OF NUMBER TEN ARCHITECTURAL GROUP AND THE COPYRIGHT IN THE SAME BEING RESERVED TO THEM. IT MAY BE REPRODUCED ONLY WITH THE PERMISSION OF NUMBER TEN ARCHITECTURAL GROUP, IN WHICH CASE THE REPRODUCTION MUST BEAR THEIR NAME.

REVISED/ ISSUED/ PLOTTED	DATE
Rev. 2 - RE-ISSUED FOR TENDER	MARCH 07/2012
Rev. 1 - ISSUED FOR TENDER	FEBRUARY 03/2012
Rev. 0 - ISSUED FOR TENDER	NOVEMBER 21/2011

- NOTES:**
- NIGHT LIGHTING IS FED FROM CIRCUIT LDP-12.
 - REFER TO THE LIGHTING CONTROLLER RISER DIAGRAM ON DRAWING E11.0 FOR CONTROL DETAILS.
 - LIGHTS IN WAFFLE SLAB CEILING SPACE ARE TO RE-USE EXISTING WIRING.

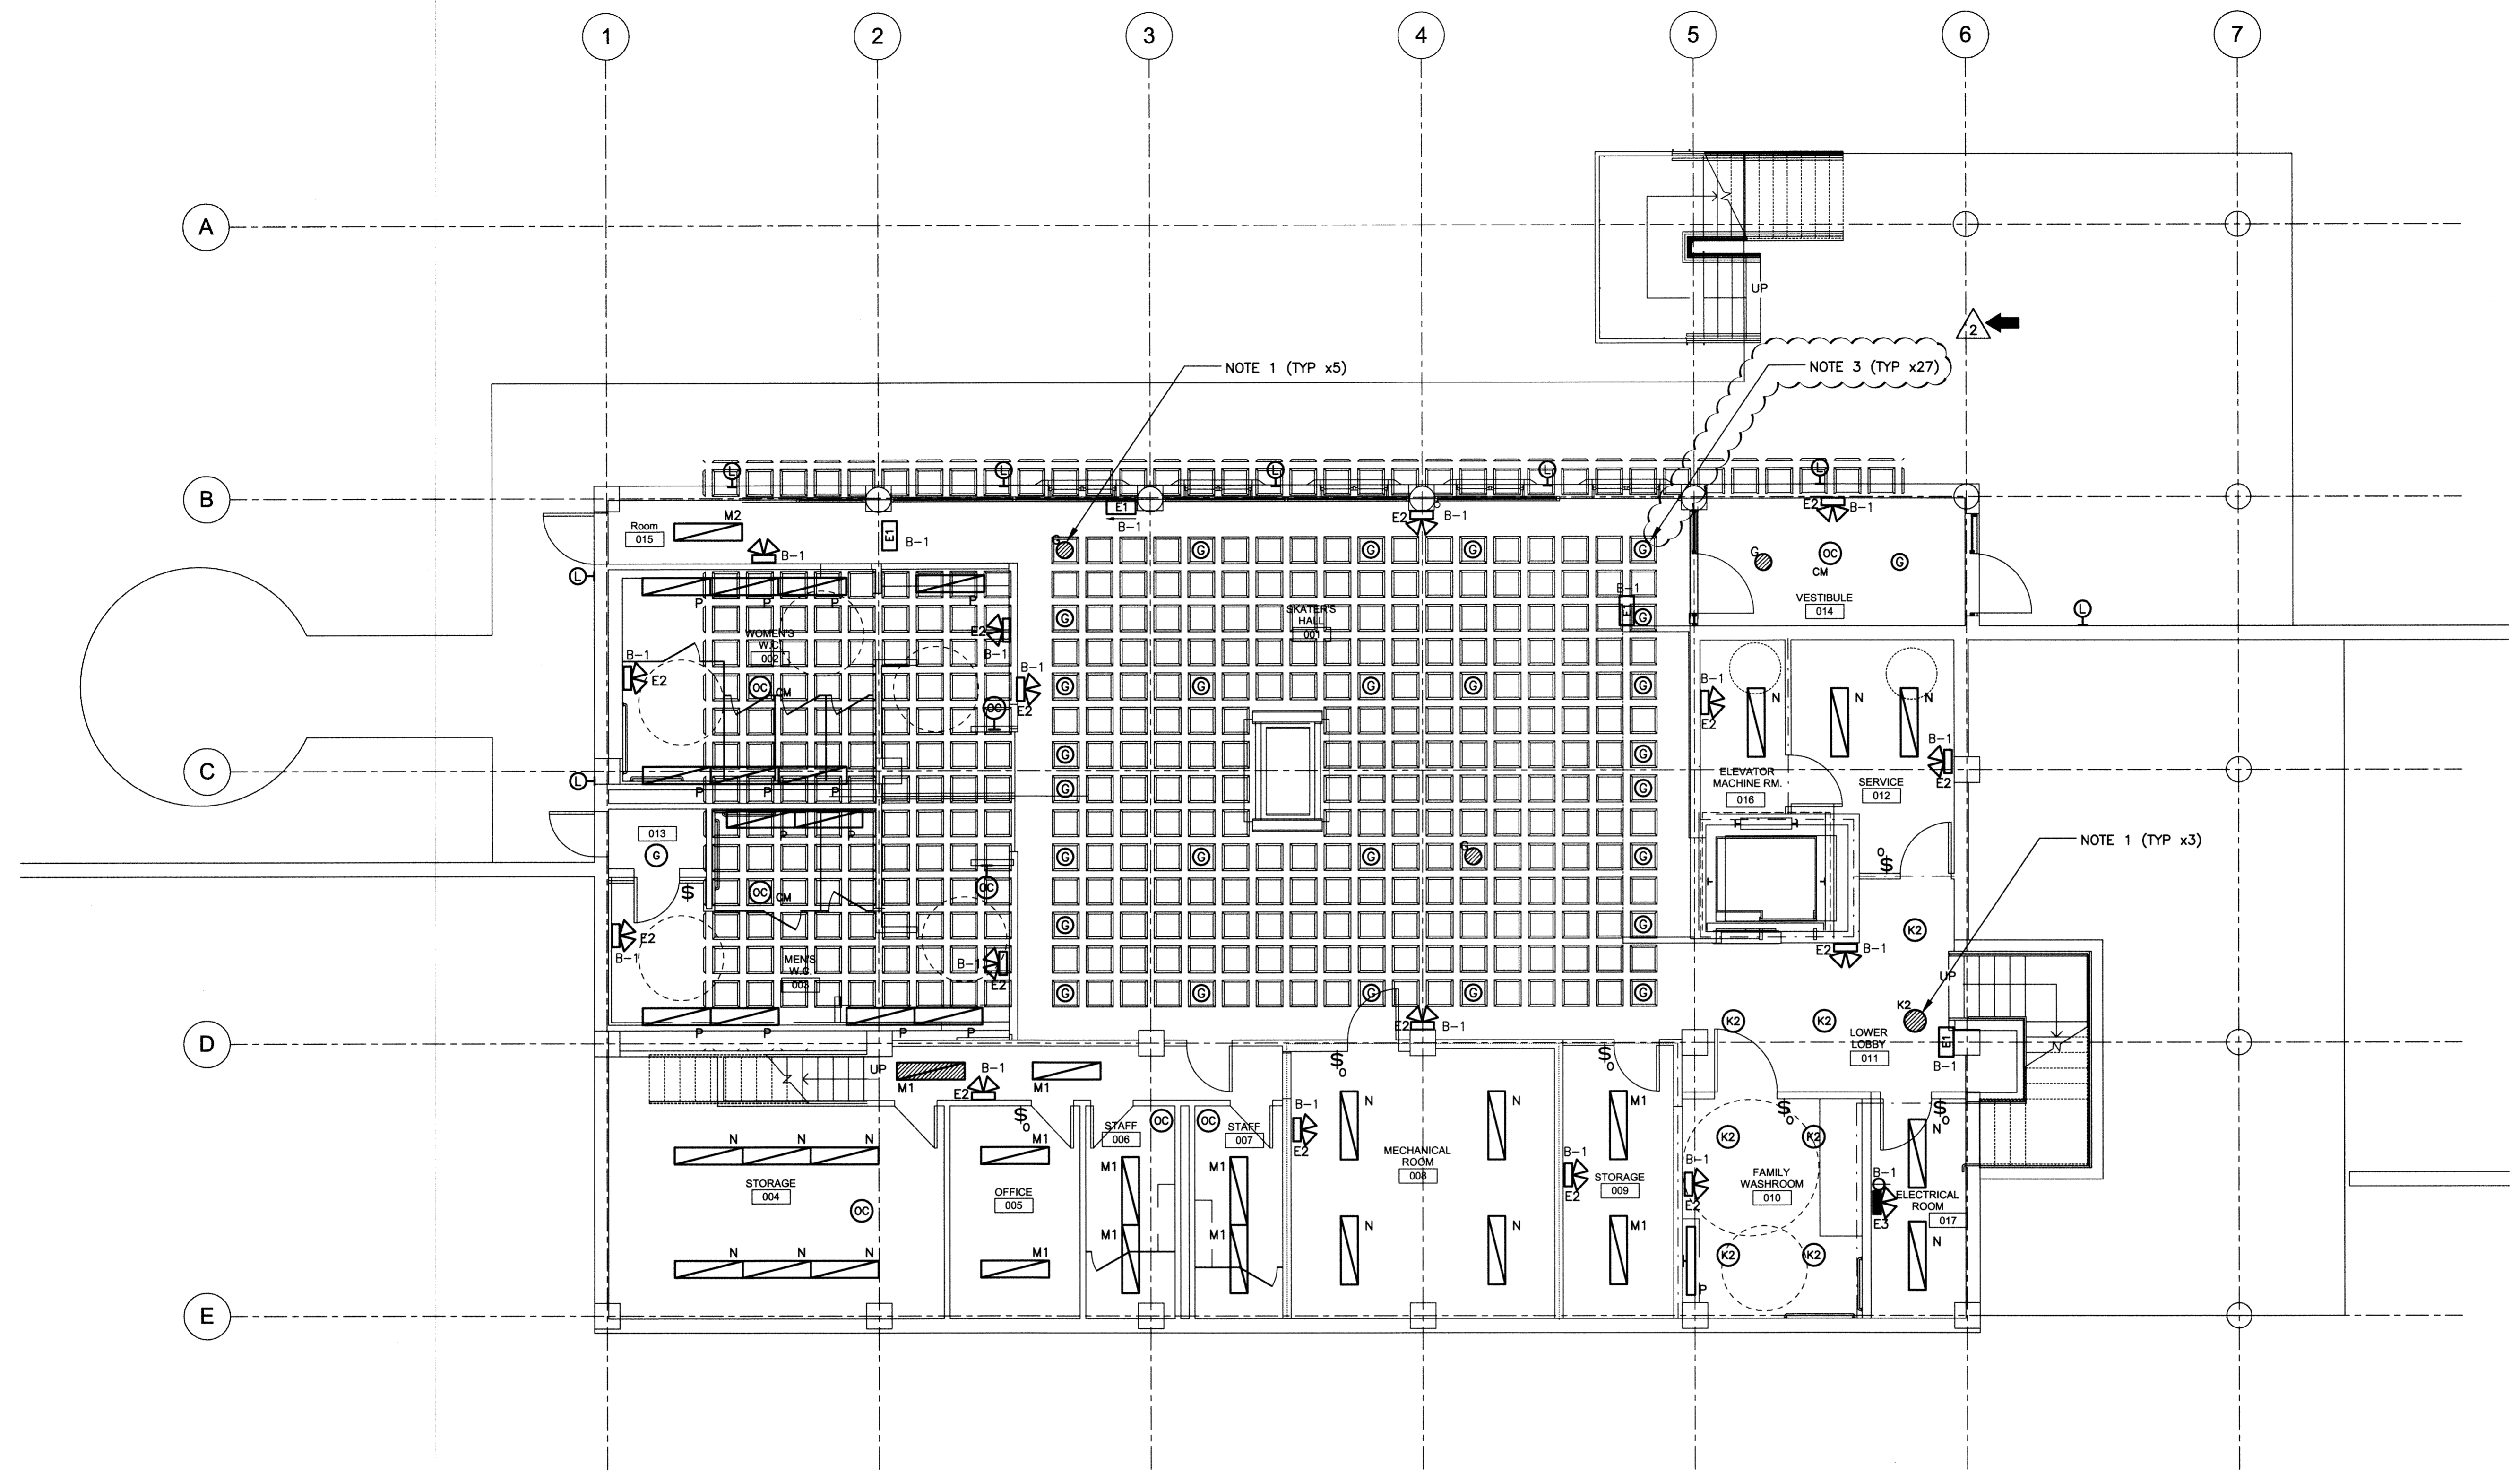

1 LOWER LEVEL PLAN - LIGHTING

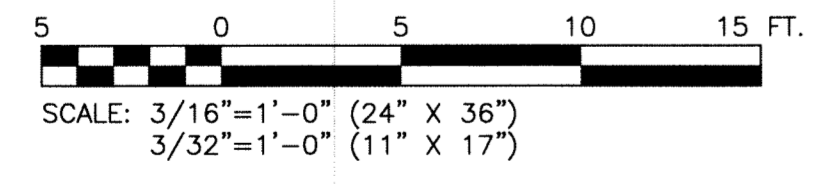

FIXTURE CIRCUITING SCHEDULE (NOTE 2)						
ROOM NUMBER	DESCRIPTION	TOTAL LOAD	FIXTURE TYPE(S)	SWITCHING	CIRCUIT(S)	NOTES
1	SKATER HALL	1101	G	ZONE 1	LDP-1	
14	LOWER LEVEL VESTIBULE	45	G	ZONE 1	LDP-6	
15	-	75	M2	ZONE 1	LDP-6	
11	LOWER LEVEL LOBBY	70	K2	ZONE 1	LDP-6	
16	ELEVATOR MACHINE ROOM	75	N	LINE VOLTAGE OCCUPANCY SENSOR	DP-2	
12	SERVICE	150	N	LINE VOLTAGE OCCUPANCY SENSOR	DP-2	
2	WOMENS W.C.	450	P	LINE VOLTAGE OCCUPANCY SENSOR	DP-5	
3	MENS W.C.	380	P	LINE VOLTAGE OCCUPANCY SENSOR	DP-5	
13	HOSE ROOM	45	G	LOCAL SWITCH	DP-5	
4	STORAGE	455	N	LINE VOLTAGE OCCUPANCY SENSOR	DP-2	
5	OFFICE	150	M1	LINE VOLTAGE OCCUPANCY SENSOR	DP-2	
6	STAFF W.C.	150	M1	LINE VOLTAGE OCCUPANCY SENSOR	DP-7	
7	STAFF W.C.	150	M1	LINE VOLTAGE OCCUPANCY SENSOR	DP-7	
8	MECHANICAL ROOM	300	N	LINE VOLTAGE OCCUPANCY SENSOR	DP-7	
9	STORAGE	150	M1	LINE VOLTAGE OCCUPANCY SENSOR	DP-7	
10	FAMILY WASHROOM	90	K2	LINE VOLTAGE OCCUPANCY SENSOR	DP-7	
17	ELECTRICAL ROOM	150	N	LINE VOLTAGE OCCUPANCY SENSOR	DP-7	
OUTDOOR	NORTH SIDE	1415	L	ZONE 2	LDP-5	
160	RESTAURANT HALLWAY	75	M1	LOCAL SWITCH	DP-5	

numberTEN
architectural group

winnipeg MB regina SK victoria BC
204.942.9981 306.721.1501 250.360.2106

architecture • interior design • graphic design

PEGUS PAVILION
UPGRADES AND ENTRY ADDITION
BIDDING #913-2011

ELECTRICAL
LOWER LEVEL
LIGHTING

KGS GROUP CONSULTING ENGINEERS



scale: 3/16"=1'-0"
date: August 15, 2011
sheet no. **E6.0**

E:\Projects\2011\1-0902-04_Pegasus\1-0902-04_Pegasus\1-0902-04_E6.0-Rev 2.dwg - Tab: E6.0 Plotted By: DDeroche 12/03/07 [Wed 5:18pm]
 24.208/LOT SCALE: 1:1