


THIS DRAWING MUST NOT BE SCALED.
 THE GENERAL CONTRACTOR SHALL VERIFY ALL DIMENSIONS, DETAILS, AND LEVELS PRIOR TO COMMENCEMENT OF WORK. ALL ERRORS AND OMISSIONS TO BE REPORTED TO NUMBER TEN ARCHITECTURAL GROUP BEFORE PROCEEDING.
 VARIATIONS AND MODIFICATIONS TO WORK SHOWN ON THESE DRAWINGS SHALL NOT BE CARRIED OUT WITHOUT WRITTEN PERMISSION OF NUMBER TEN ARCHITECTURAL GROUP.
 THIS DRAWING IS THE EXCLUSIVE PROPERTY OF NUMBER TEN ARCHITECTURAL GROUP AND THE COPYRIGHT IN THE SAME BEING RESERVED TO THEM. IT MAY BE REPRODUCED ONLY WITH THE PERMISSION OF NUMBER TEN ARCHITECTURAL GROUP, IN WHICH CASE THE REPRODUCTION MUST BEAR THEIR NAME.

REVISED/ ISSUED/ PLOTTED	DATE
Rev. 2 - RE-ISSUED FOR TENDER	MARCH 07/2012
Rev. 1 - ISSUED FOR TENDER	FEBRUARY 03/2012
Rev. 0 - ISSUED FOR TENDER	NOVEMBER 21/2011

- NOTES:**
- NIGHT LIGHTING IS FED FROM CIRCUIT LDP-12.
 - REFER TO THE LIGHTING CONTROLLER RISER DIAGRAM ON DRAWING E11.0 FOR CONTROL DETAILS.
 - TYPICAL NEW WAFFLE SLAB ROOF PENETRATION.

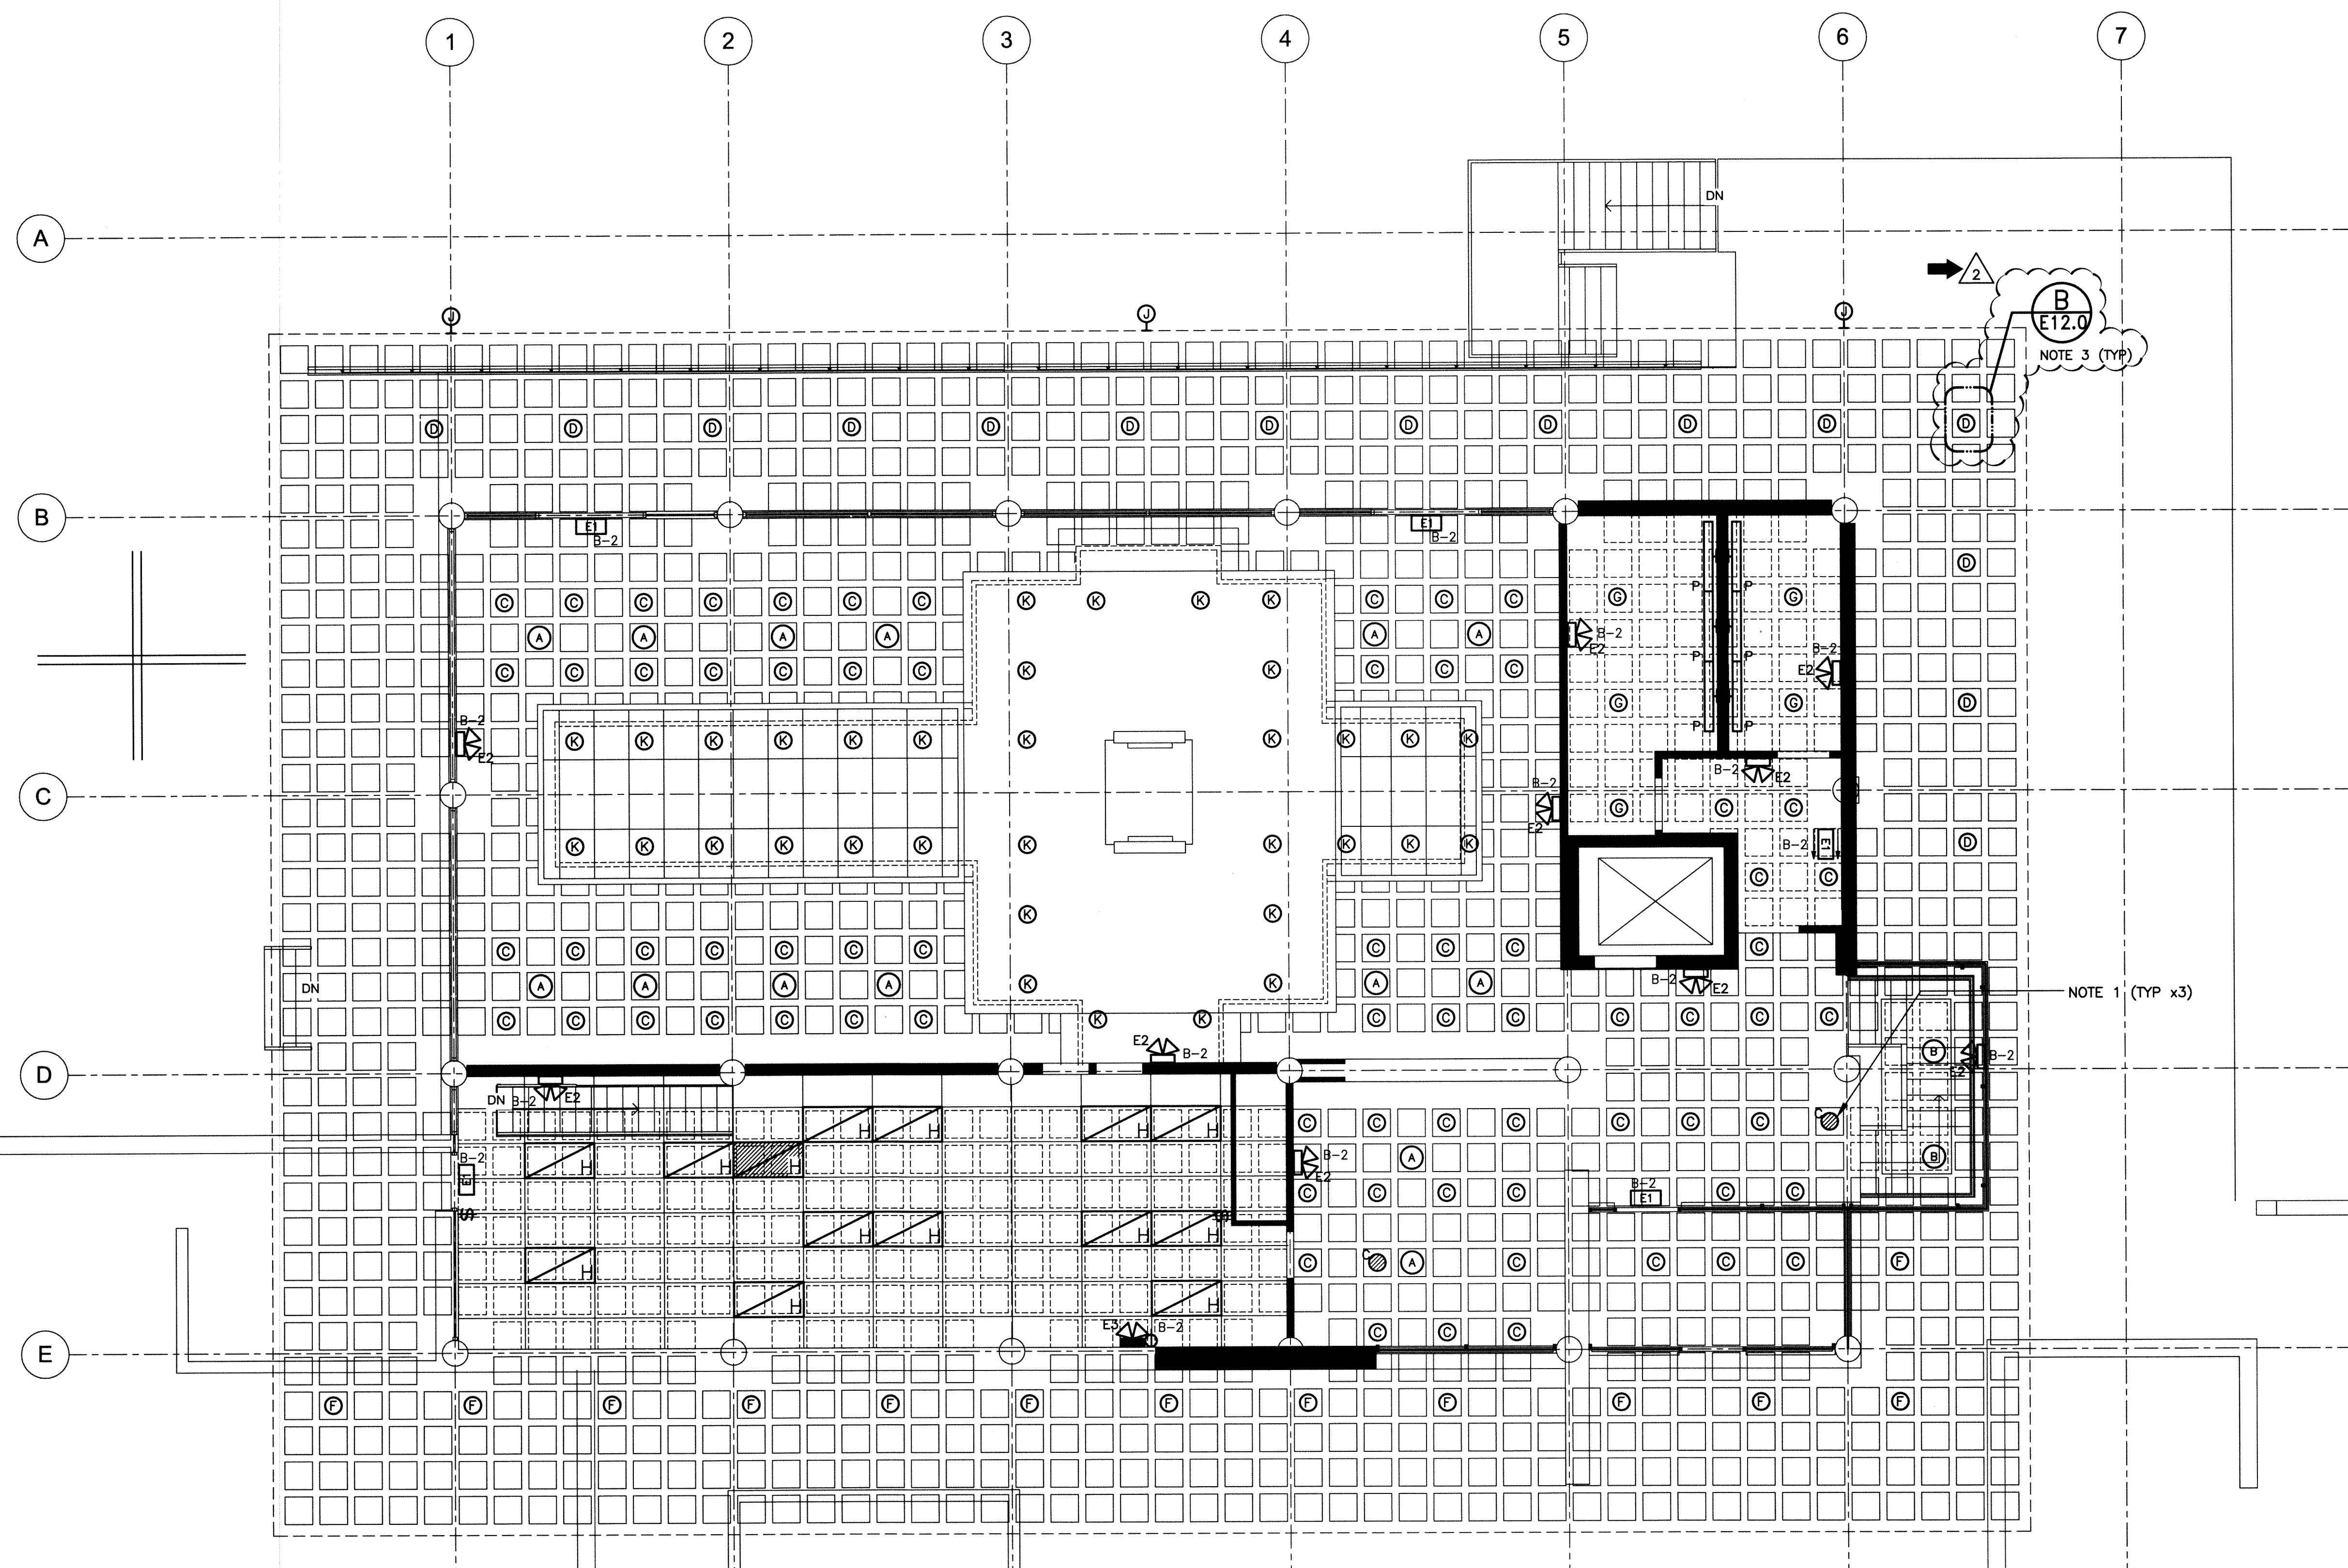

1 MAIN FLOOR - LIGHTING
 SCALE: 3/16"=1'-0" (24" X 36")
 3/32"=1'-0" (11" X 17")

FIXTURE CIRCUITING SCHEDULE (NOTE 2)						
ROOM NUMBER	DESCRIPTION	TOTAL LOAD	FIXTURE TYPE(S)	SWITCHING	CIRCUIT(S)	NOTES
104	DINNING ROOM A	320	A	ZONE 5; LINE VOLTAGE DIMMING	LDP-2	
104	DINNING ROOM A	330	C	ZONE 4; DIMMING 0-10VDC	LDP-2	
104	DINNING ROOM A	450	K	ZONE 3; DIMMING 0-10VDC	LDP-2	
105	DINNING ROOM B	160	A	ZONE 5; LINE VOLTAGE DIMMING	LDP-4	
105	DINNING ROOM B	145	C	ZONE 4; DIMMING 0-10VDC	LDP-4	
105	DINNING ROOM B	315	K	ZONE 3; DIMMING 0-10VDC	LDP-4	
103	KITCHEN	1468	H	LOCAL SWITCH	DP-3,5	
102	CAFÉ	80	A	ZONE 12; LINE VOLTAGE DIMMING	LDP-8	
102	CAFÉ	155	C	ZONE 11; DIMMING	LDP-8	
110	MAIN FLOOR LOBBY	165	B	ZONE 9	LDP-8	
110	MAIN FLOOR LOBBY	165	C	ZONE 13; DIMMING 0-10VDC	LDP-8	
101	VESTIBULE	40	C	ZONE 10; DIMMING 0-10VDC	LDP-8	
106	WOMENS W.C.	275	G; P	ZONE 13	LDP-10	
107	MENS W.C.	320	G; P	ZONE 13	LDP-10	
ROOF TOP	CHRISTMAS/ROPE LIGHTS	1200	-	ZONE 14	LDP-9	
OUTDOOR	NORTH SIDE	145	D	ZONE 6	LDP-3	
OUTDOOR	NORTH SIDE	530	J	ZONE 8	LDP-3	
OUTDOOR	SOUTH SIDE	415	F	ZONE 7	LDP-7	

File Name: P:\Projects\2011\11-0902-04\Doc.Control\Tobias\DWG\11-0902-04_E7.0-Rev 2.dwg - Tab: E7.0 Plotted By: DDeroche 12/03/07 [Wed 5:18pm]
 24 X 36 PLOT SCALE: 1:1

numberTEN
 architectural group

winnipeg MB regina SK victoria BC
 204.942.0981 306.721.1501 250.360.2106

architecture • interior design • graphic design

PEGUIS PAVILION
 UPGRADES AND ENTRY ADDITION
 BIDDING #913-2011

project

ELECTRICAL
 MAIN FLOOR
 LIGHTING

sheet title

KGS GROUP CONSULTING ENGINEERS

consultant

APECN
 Certificate of Authorization
 KGS Group
 No. 245

A.R.D. PAWLKEWICH
 Member
 23235
 PROFESSIONAL ENGINEER

scale: 3/16"=1'-0"
 date: August 15, 2011

drawn by: JPL
 checked by:
 project no. 2011026

sheet no. **E7.0**