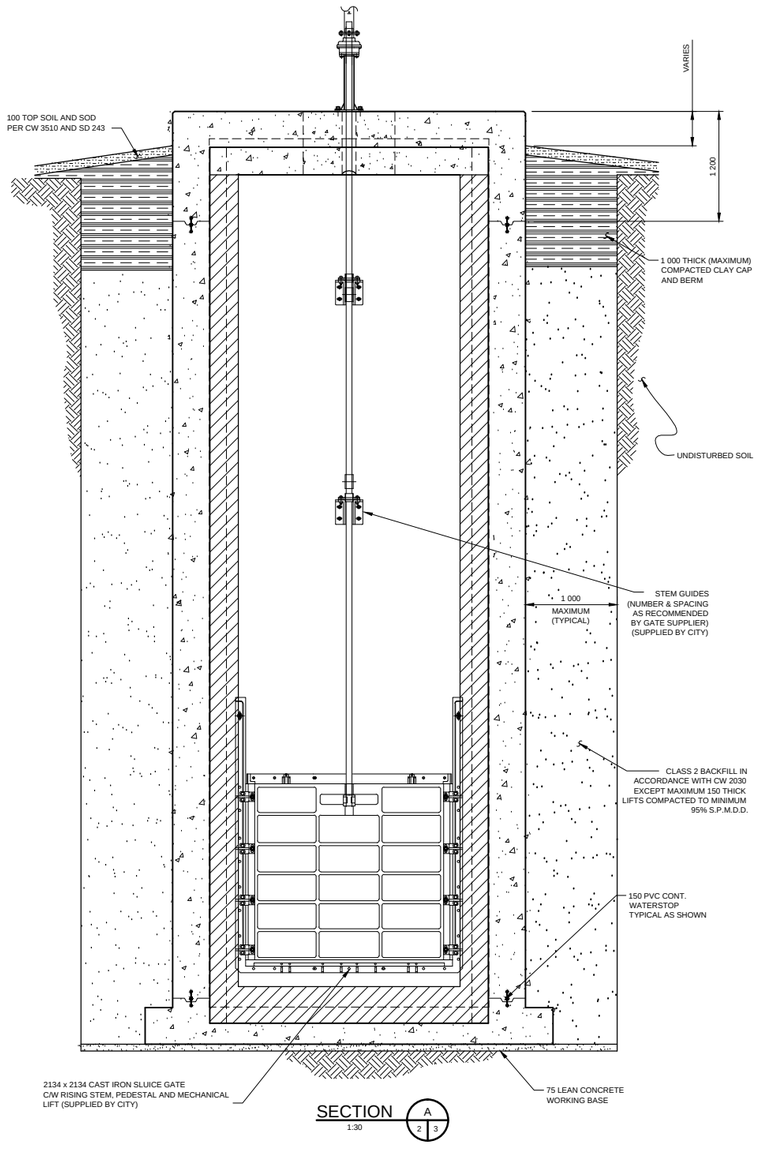

SECTION A (2 3) 1:30

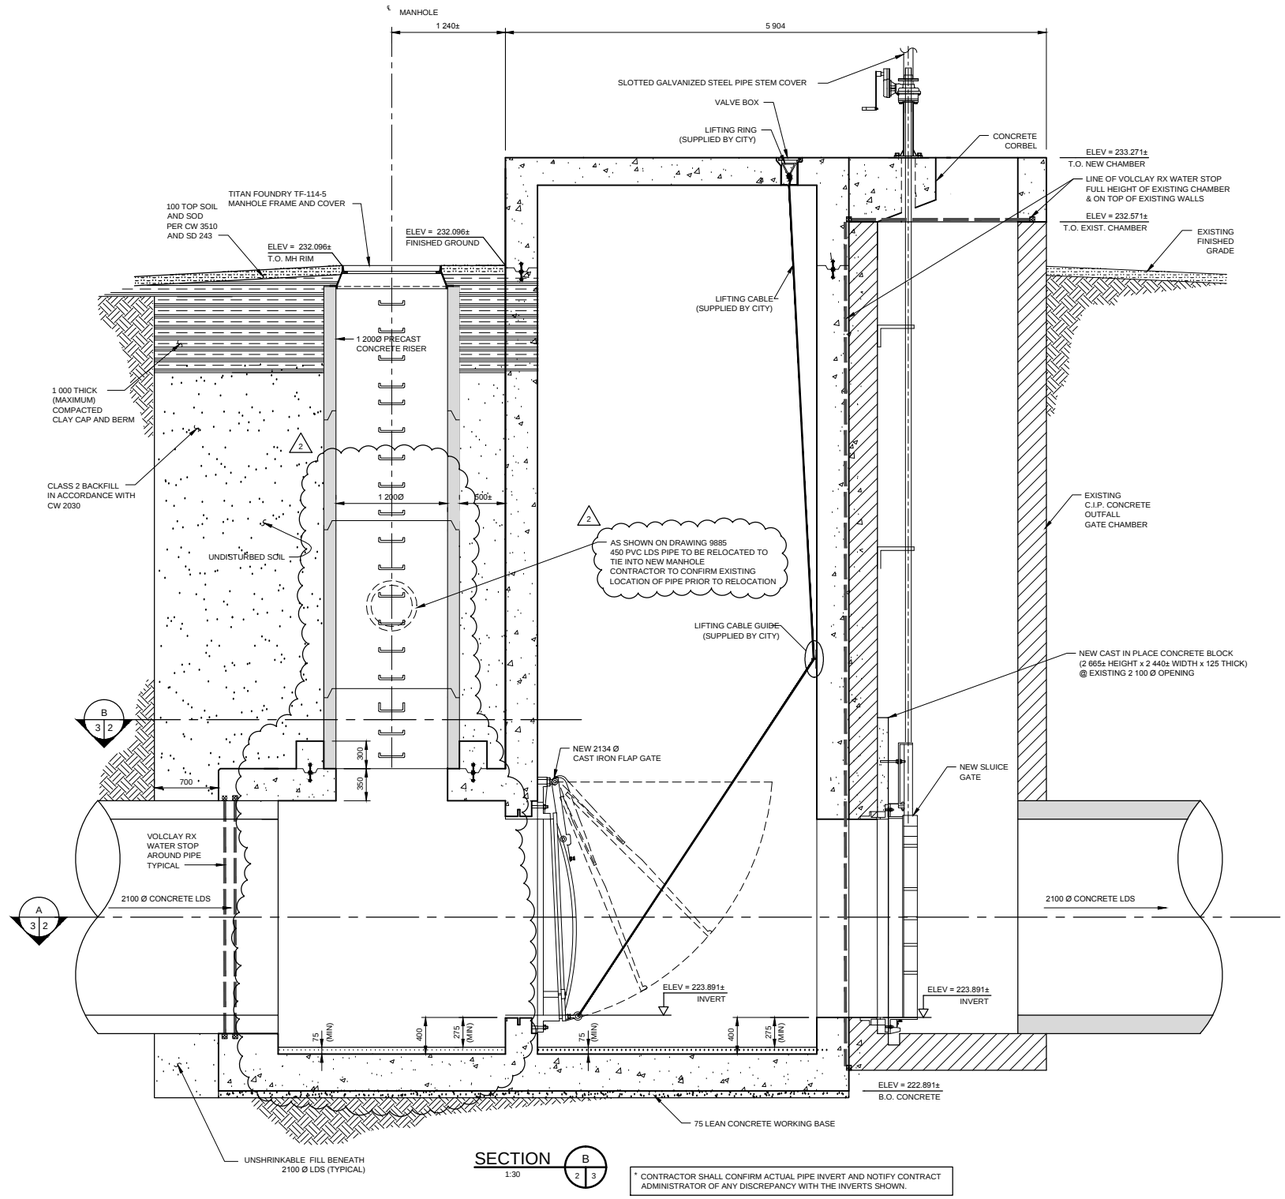

SECTION B (2 3) 1:30

* CONTRACTOR SHALL CONFIRM ACTUAL PIPE INVERT AND NOTIFY CONTRACT ADMINISTRATOR OF ANY DISCREPANCY WITH THE INVERTS SHOWN.

NOTE:
ALL GATES ARE PROVIDED BY THE CITY BID OPPORTUNITY No. 794-2011

SCALE LEGEND:

1:30 0.0 0.5 1.0 1.5 2.0m

A = DETAIL/SECTION No.
B = DRAWING WHERE SHOWN
C = DRAWING WHERE TAKEN

METRIC
WHOLE NUMBERS INDICATE MILLIMETRES
DECIMALIZED NUMBERS INDICATE METRES

No.	REVISIONS	DATE	BY
2	ISSUED FOR ADDENDUM 1	11.11.29	DM
1	ISSUED FOR TENDER	11.11.18	DM

MMM GROUP
MMM Group Limited
Suite 111 - 93 Lombard Ave.
Winnipeg, MB R3B 3B1
t. 204.943.3178 | f. 204.943.4948
www.mmm.ca

DESIGNED BY	MM	CHECKED BY	DM/CDP
DRAWN BY	KDB	APPROVED BY	DM
HOR. SCALE	AS NOTED	RELEASED FOR CONSTRUCTION	
VERT. SCALE	AS NOTED		
DATE		DATE	2011.11.29

ENGINEER'S SEAL
PROVINCE OF MANITOBA
Nov. 29, 2011
MUHURDAREVIC
Member
31027
REGISTERED PROFESSIONAL ENGINEER

BID OPPORTUNITY: 938-2011
PLOT DATE: 2011.11.29

PEGM
Certificate of Authorization
MMM Group Limited
No. 4531 Date: 11.11.29

Winnipeg
THE CITY OF WINNIPEG
WASTE AND WATER DEPARTMENT

OUTFALL GATE CHAMBERS CONSTRUCTION & UPGRADES

MINNETONKA STREET & RIVER ROAD
LDS OUTFALL GATE CHAMBER ADDITION

CONCRETE DETAILS (2 OF 2)

CONSULTANT DRAWING No.: 5511125-3
SHEET 3 OF 10
CITY DRAWING No.: LD-5709

NOTE:
These design documents are prepared solely for the use by the party with whom the design professional has entered into a contract and there are no representations of any kind made by the design professional to any party with whom the design professional has not entered into a contract.

Last saved November 29, 2011 - 1:11 PM by BERNARDINK
P:\551\101-551119991\5511125 - Minnetonka Gate Chambers Construction\MMM Drawings\5511125 minnetonka gate chambers_111128_kdb.dwg